PUB ROAD DIV NO	STATE	PROJECT NO	FISCAL YEAR	SHEET NO	TOTAL SHEETS
5	KANSAS	87RS 428(13)			

lot 2

N. 0° 00' E.

Property Line

P.C. Base Line Sta 1142+80.90

P.C. Adv. 105' Rt. @ Sta. 1142+38.17

SEDGWICK COUNTY ZOO

lot 1

100.73

106' Right Base Line
Begin 15" Clay Pipe
@ .15 % Grade
~~1313.26~~ Flo
1313.61

℄ Sanitary Sewer Easement

S 1° 35' 29" E

30' Sanitary Sewer Easement

Block "A"

Proposed Manhole by others

1325 Top of pipe

Begin Concrete Encasement (See Detail)

6" Texaco Pipeline

50' Texaco Pipeline Easement

30' Utility Easement

Existing South R/W Line

10' Stabilized Shoulder

Proposed Improvement

Combined Curb and Gutter (Type D)

1143+00

1325.28 Top of pipe

Base Line

Section Line — N. 89°26'39" E. — ℄ 21st St. North

1144+00

Selected Emb. Material

Combined Curb and Gutter (Type C)

Combined Curb and Gutter (Type A)

Existing North R/W Line

60' R/W Line

121' Left Base Line
End 15" Clay Pipe
@ .15 % Grade
~~1313.60~~ Flo
1313.96

End Concrete Encasement

1143+48.90 ℄ Tangent


℄ Entrance

1/16 Section Line


Temp. Easement 200' ± Long.

Plan Scale 1"=20'
Profile Scale 1"=20' Horiz.
1"= 5' Vert.

BM. 1317.67 State Highway Dept. BM #32A – Steel Fence Post at 1139+78.1 and at approx. Nt. 21st Street North = City of Wichita Datum of 130.19

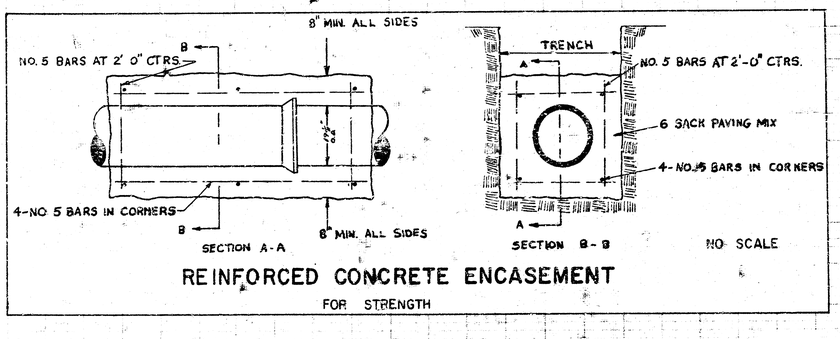

REINFORCED CONCRETE ENCASEMENT
FOR STRENGTH

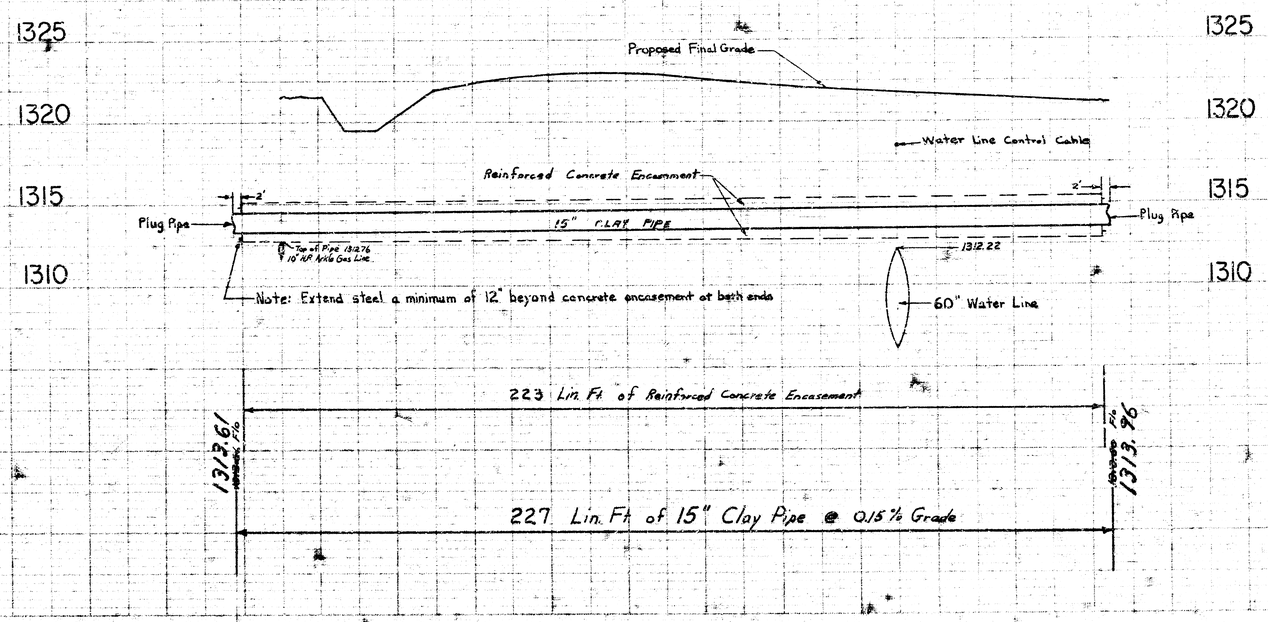

SANITARY SEWER CROSSING
TWENTY FIRST STREET
NORTH OF SEDGWICK CO.
ZOO

PRIVATE PROJECT DBKW705057