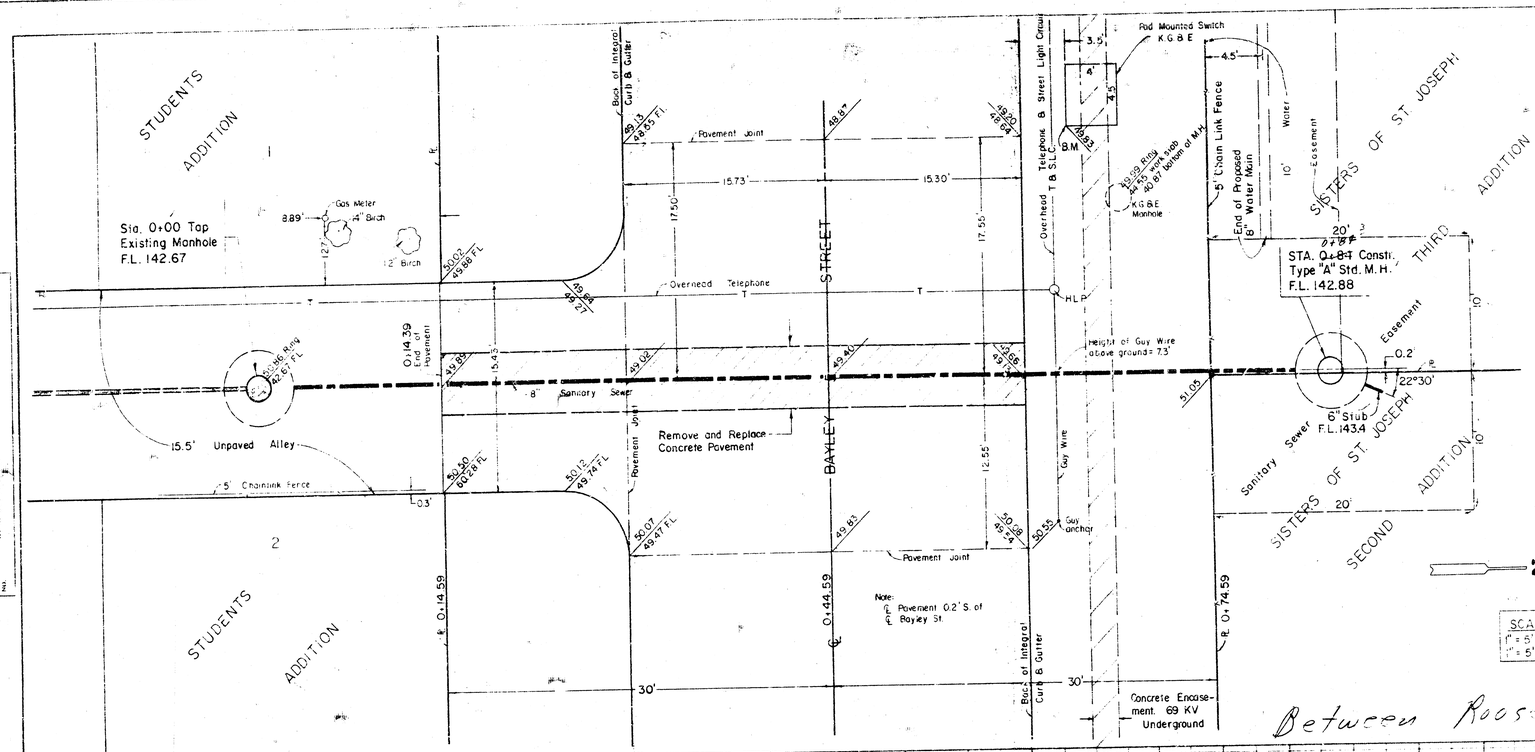

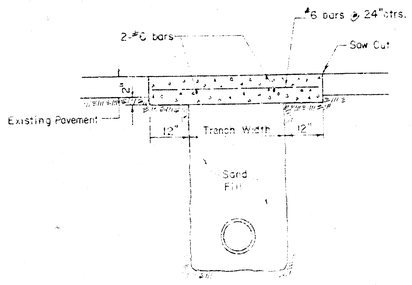

PAVEMENT REPLACEMENT DETAIL
No Scale

Between Roosevelt & York

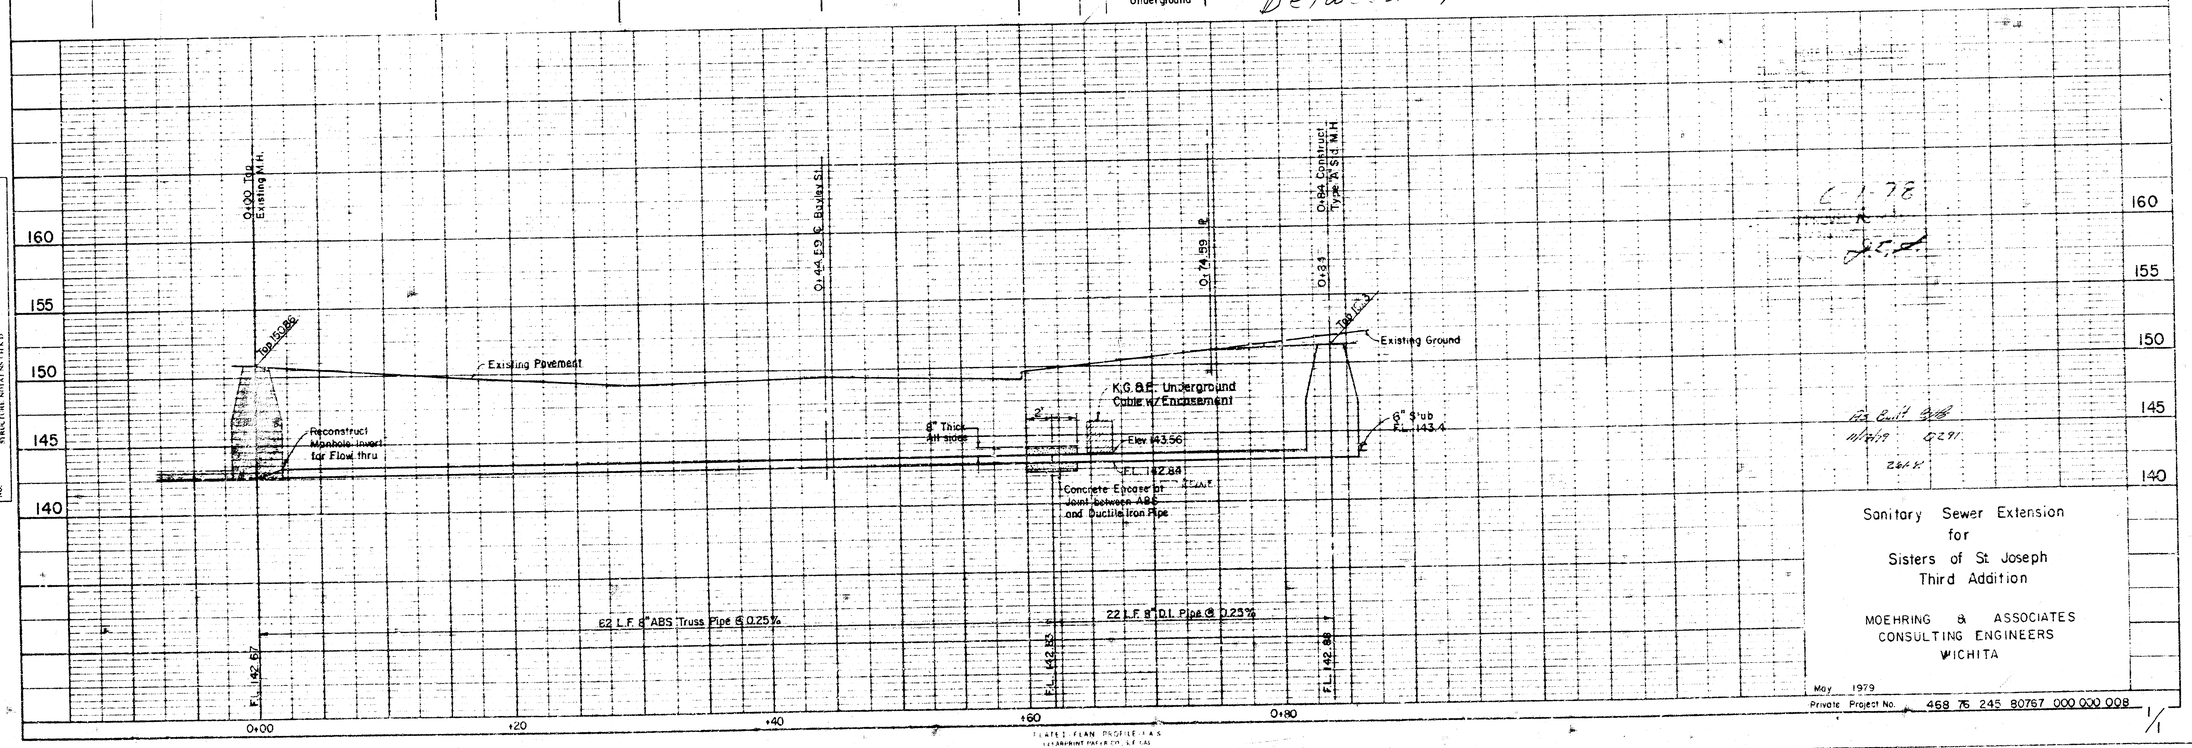

PLAN
SURVEYED
PLOTTED
COMPUTED
SURVEY BOOK
NOTE BOOK
NO.

PROFILE
SURVEYED
PLOTTED
COMPUTED
SURVEY BOOK
NOTE BOOK
NO.

Sanitary Sewer Extension
for
Sisters of St Joseph
Third Addition

MOEHRING & ASSOCIATES
CONSULTING ENGINEERS
WICHITA

May 1979

Private Project No. 468 76 245 80767 000 000 008

1/1

FILMED FROM THE BEST