




STANDARD MANHOLE
TYPE "A"

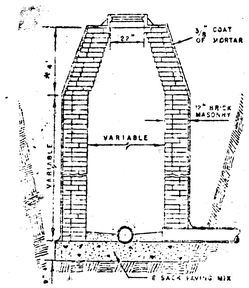


STANDARD MANHOLE
TYPE "B"

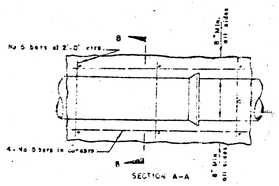

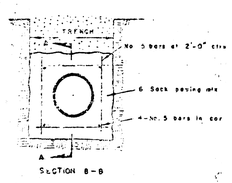

REINFORCED CONCRETE ENCASEMENT

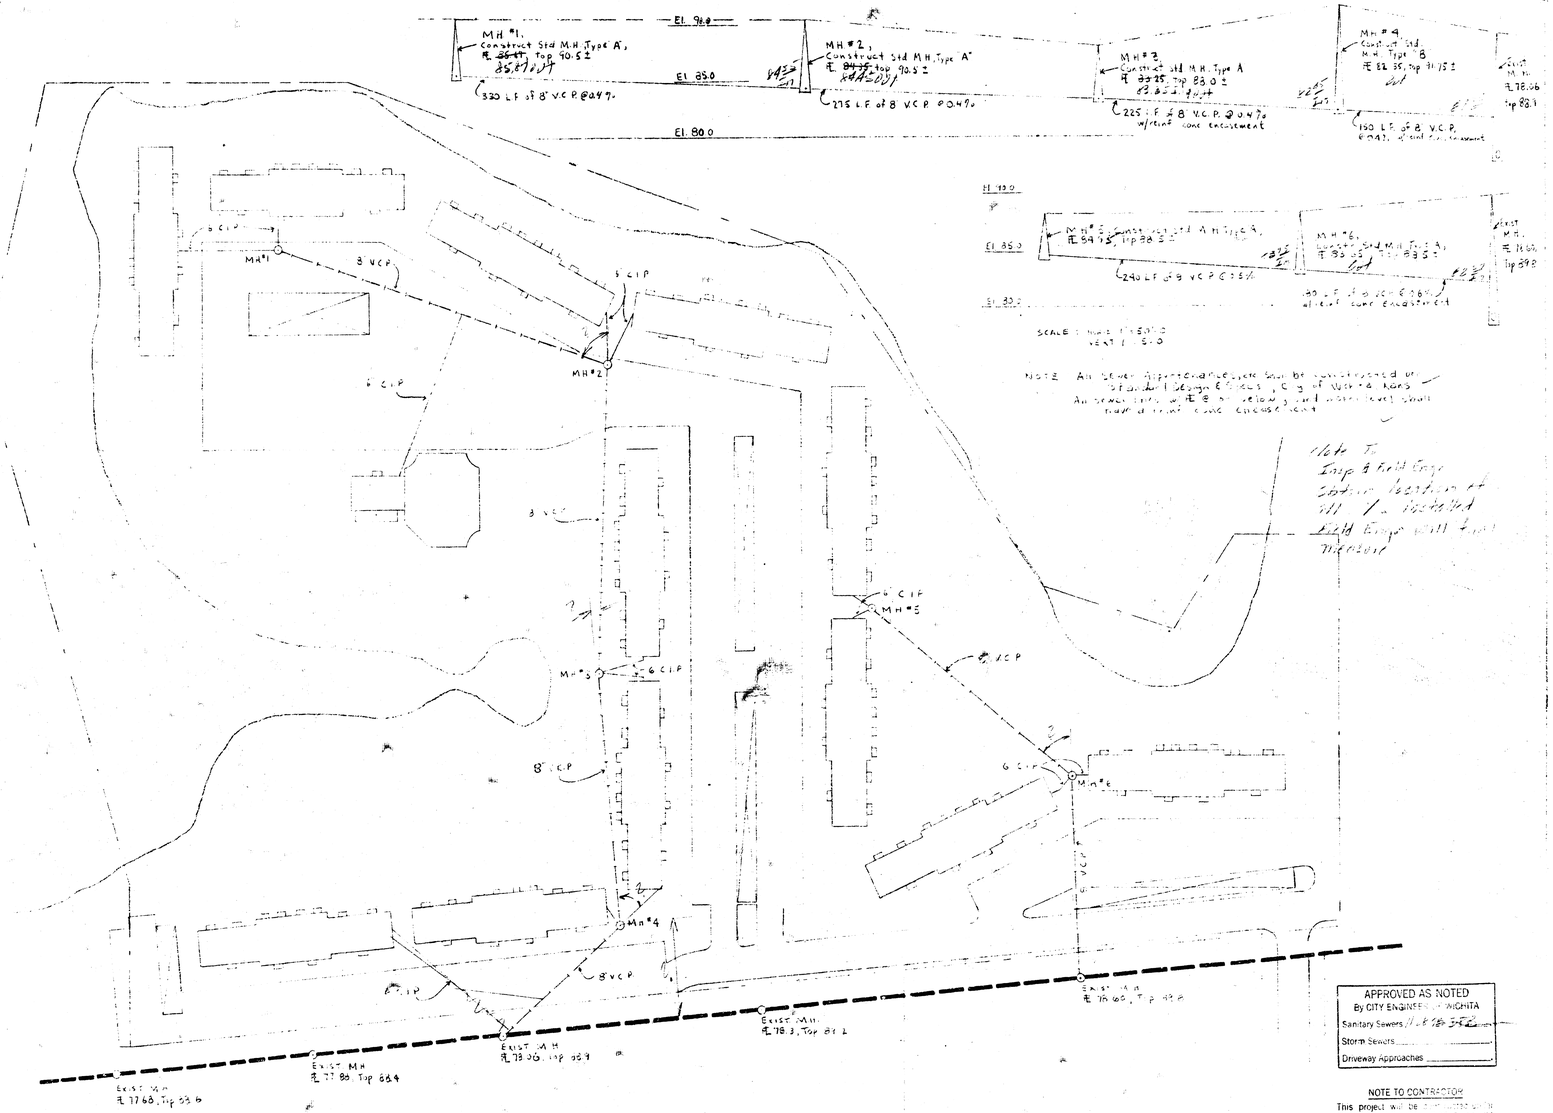

UTILITY PLAN
Scale: 1" = 50'-0"

N

APPROVED AS NOTED
By CITY ENGINEER - WICHITA
Sanitary Sewers
Storm Sewers
Driveway Approaches

NOTE TO CONTRACTOR
This project will be constructed under the supervision of the CITY ENGINEER and conform to the specifications of the CITY OF WICHITA. The CONTRACTOR will be charged for all engineering, Staking and Inspection.

	SOUTHLAKE VILLAGE	DICK BRABHAM ARCH.

15