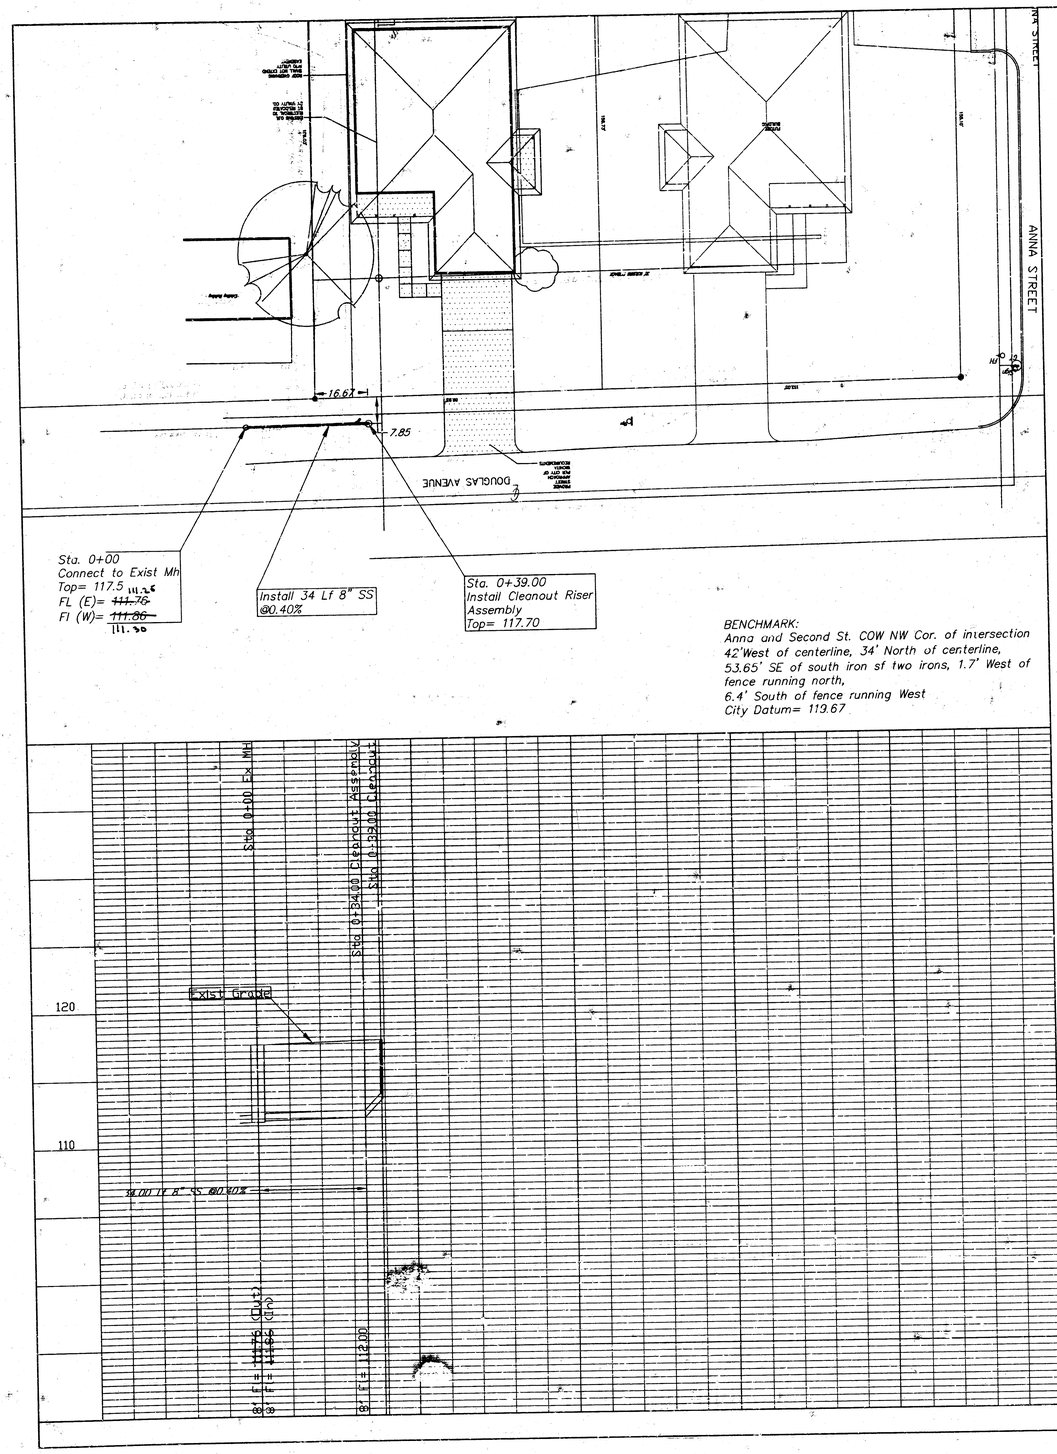

SANITARY SEWER TO SERVE

RYAN STARKEY 6 BEDROOM HOME

DOUGLAS AND ANNA
LOT 1, BLOCK 1
Kouri Addition
1310 PPS (607861)
CITY OF WICHITA, KANSAS

AS-BUILT
3/27/03
Date
Signed

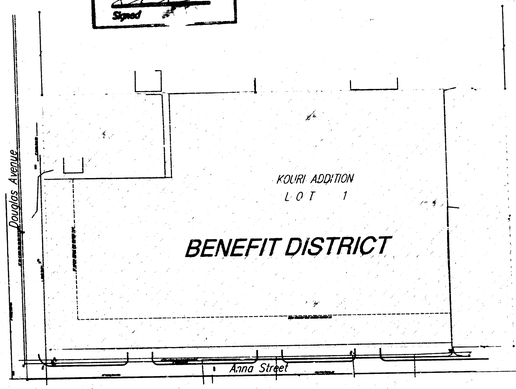

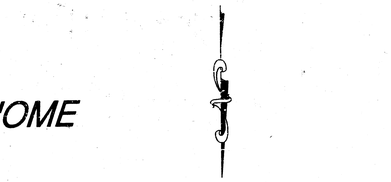

APPROVED AS NOTED

Sanitary Sewers URH 1/29/03

NOTE TO CONTRACTORS

Installation, inspection and testing for this project is to be provided by a Licensed Consulting Engineering Firm under contract with the Owner/Developer. Said inspection to be in accordance with the City of Wichita standard construction engineering practices and certified by a Licensed Professional Engineer. No work shall be performed in dedicated easements or public right-of-way by the Contractor without such inspection nor shall any work be commenced without written authorization by the City Engineer. All Construction and Materials shall comply with the City of Wichita Specifications and Standards (on file and available in the City Engineer's Office).

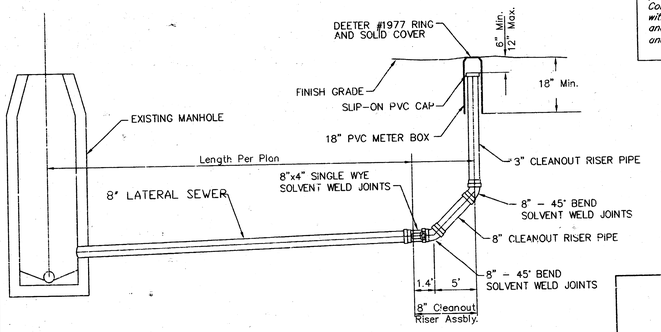

8" CLEANOUT RISER ASSEMBLY DETAIL

KIRK E. MILLER LICENSED 11283 1-27-03 KANSAS PROFESSIONAL ENGINEER

Cleanout to Serve
Ryan Starkey House
Wichita Kansas

kemiller engineering
516 S. Market, Wichita, KS 67202 316/264-0242

PROJECT NUMBER 1310 PPS (607861)			
XEM NO. 03001	FILE PPS	DATE 01-23-02	SHEET 1
DESIGN KM	DRAWN BB	REVISED	OF 1