


**ENLARGED PLAN VIEW
ELECTRICAL VAULT** SCALE: 1"=5'-0"

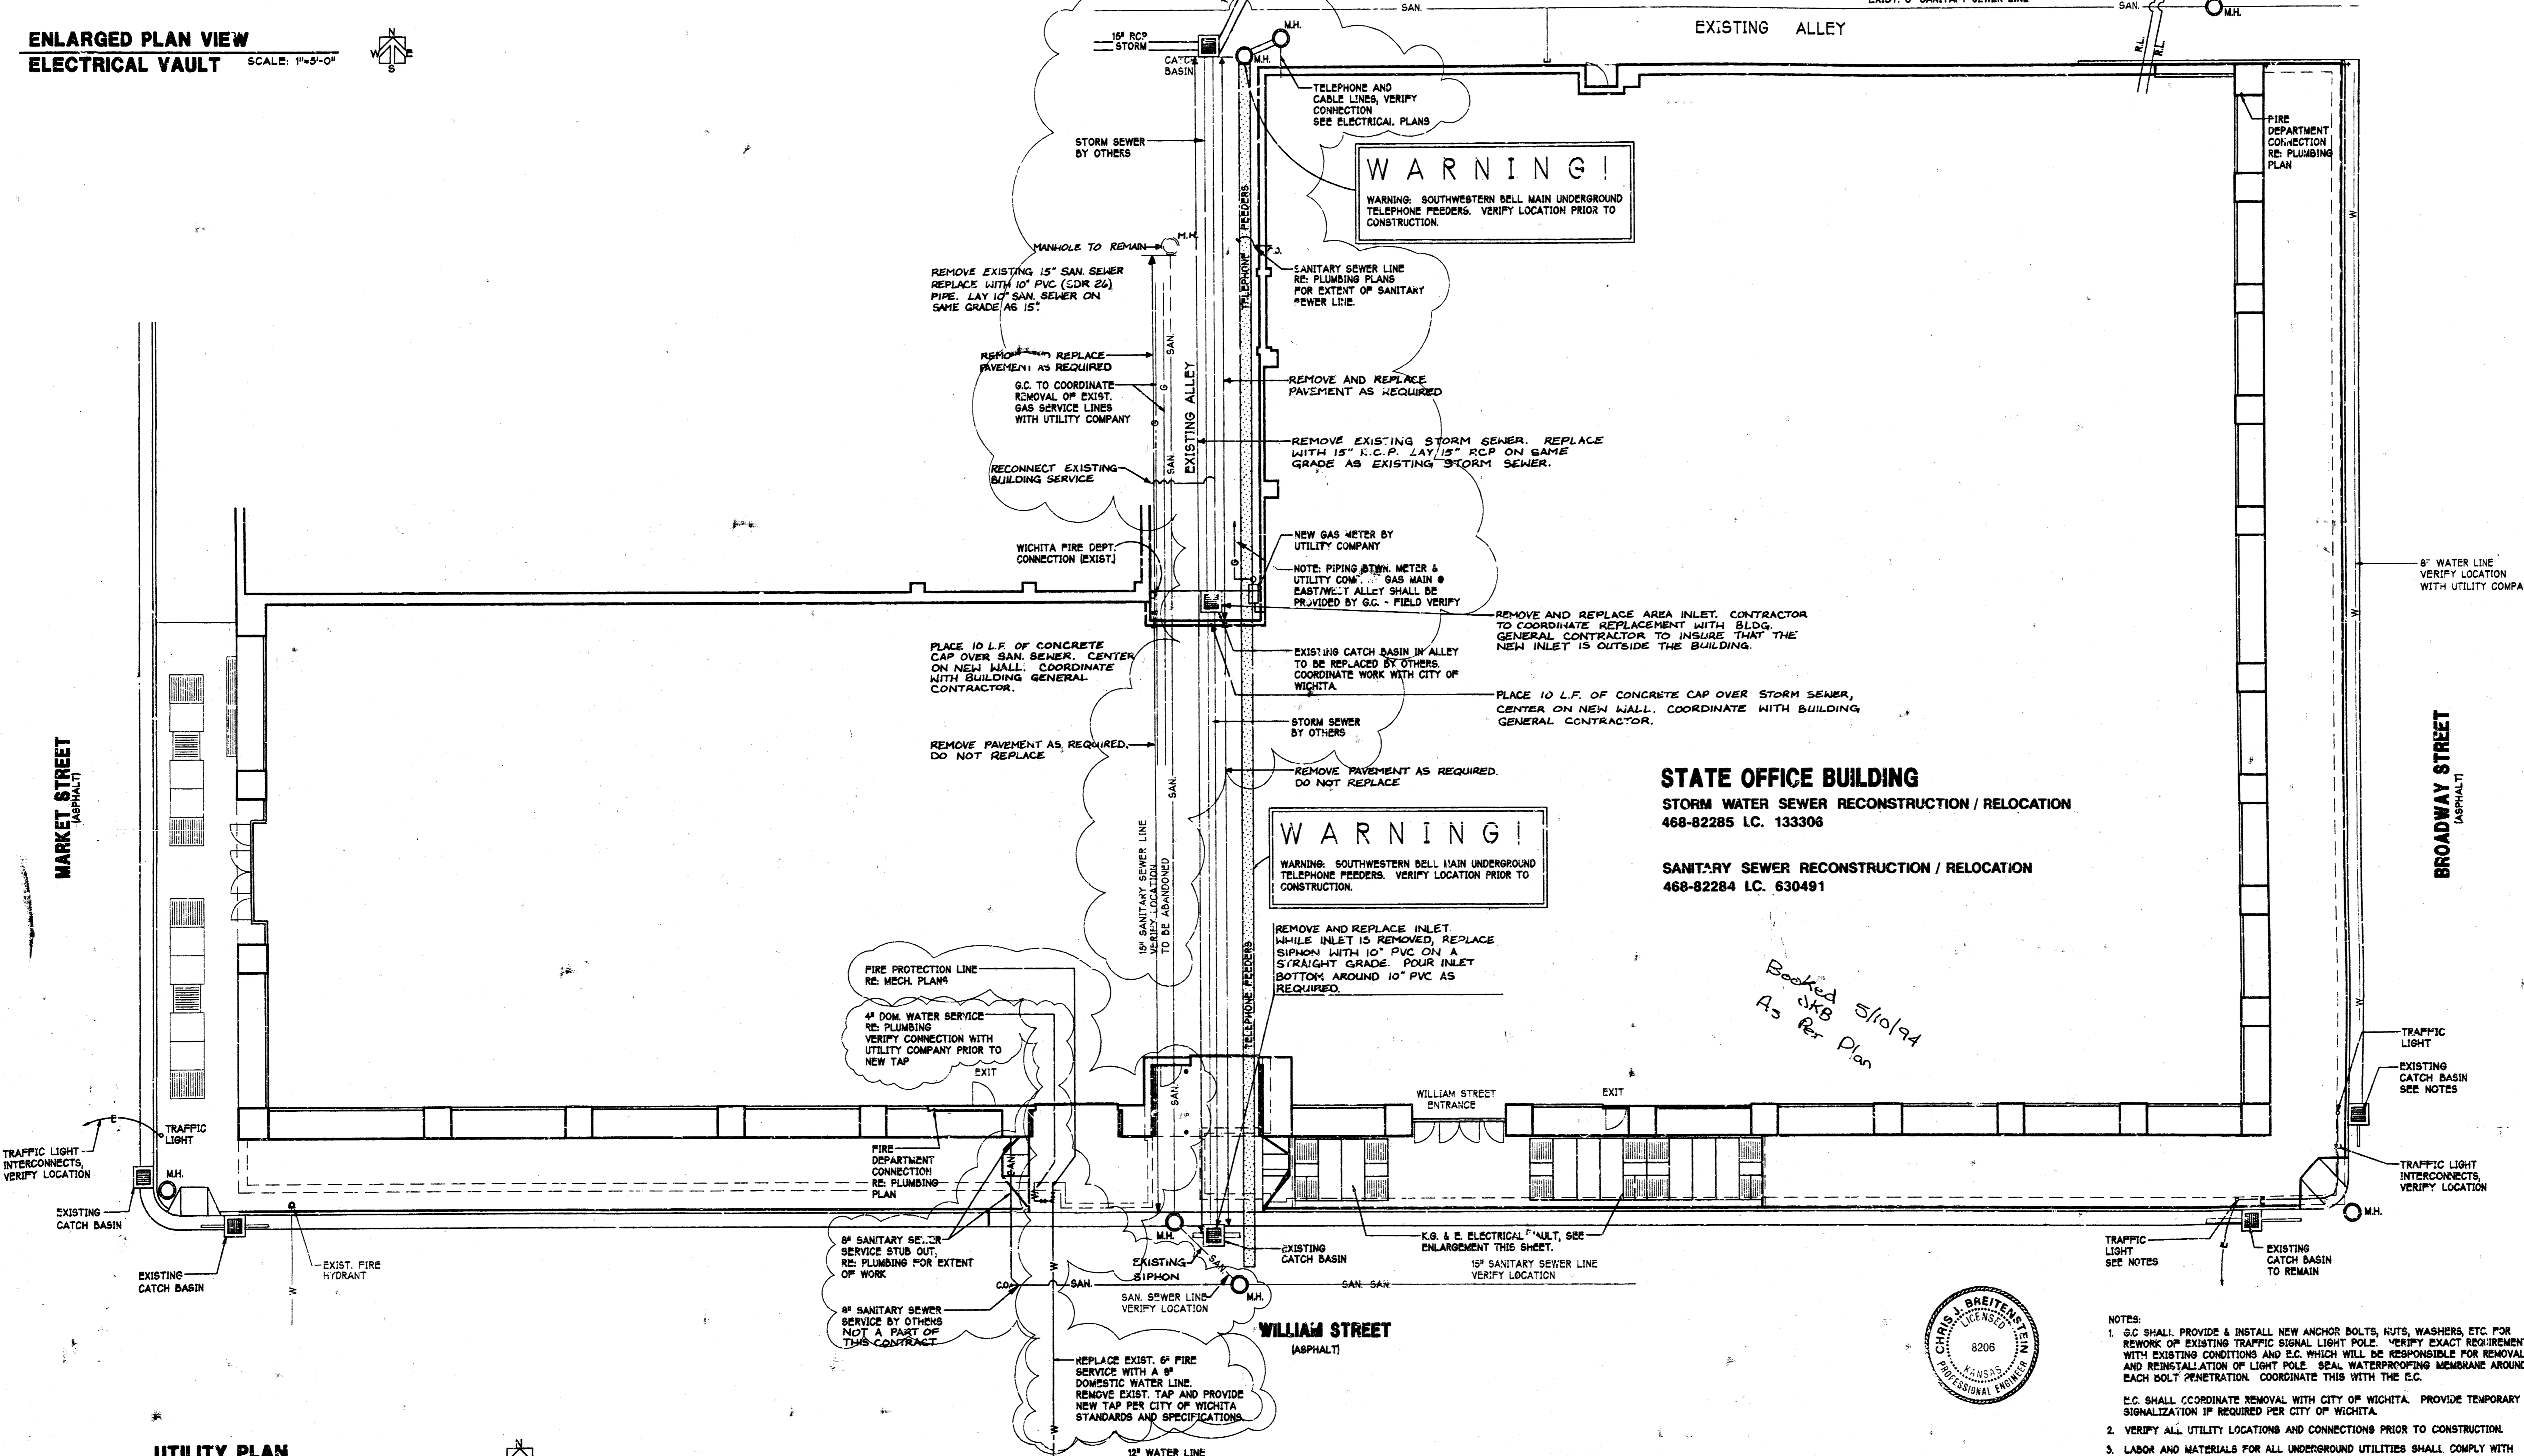

UTILITY PLAN SCALE: 1"=10'-0"

**OBLINGER
MASON
MCCLUGGAGE
& VAN SICKLE
CORPORATION**


Architects: Former's Landscape Architects
P.O. Box 98448
Wichita, Kansas 67201
Wichita, Kansas 67208
(913) 265-0401
(913) 265-0485 FAX

**STATE OFFICE BUILDING
(former Dillard's Building)**

WICHITA, KANSAS

PROJECT NO.
DATE:
REVISION:
DRAWN:
CHECKED:

SHEET
SP-2
OF SHEETS

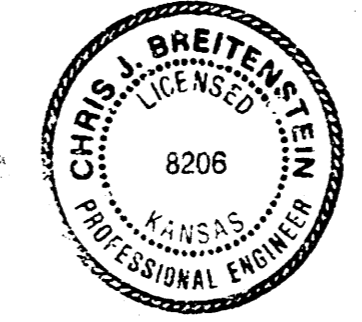

- NOTES:**
- S.C. SHALL PROVIDE & INSTALL NEW ANCHOR BOLTS, NUTS, WASHERS, ETC. FOR REWORK OF EXISTING TRAFFIC SIGNAL LIGHT POLE. VERIFY EXACT REQUIREMENTS WITH EXISTING CONDITIONS AND E.C. WHICH WILL BE RESPONSIBLE FOR REMOVAL AND REINSTALLATION OF LIGHT POLE. SEAL WATERPROOFING MEMBRANE AROUND EACH BOLT PENETRATION. COORDINATE THIS WITH THE E.C.
 - E.C. SHALL COORDINATE REMOVAL WITH CITY OF WICHITA. PROVIDE TEMPORARY SIGNALIZATION IF REQUIRED PER CITY OF WICHITA.
 - VERIFY ALL UTILITY LOCATIONS AND CONNECTIONS PRIOR TO CONSTRUCTION.
 - LABOR AND MATERIALS FOR ALL UNDERGROUND UTILITIES SHALL COMPLY WITH CITY OF WICHITA SPECIFICATIONS.

FILMED FROM THE BEST AVAILABLE COPY.