
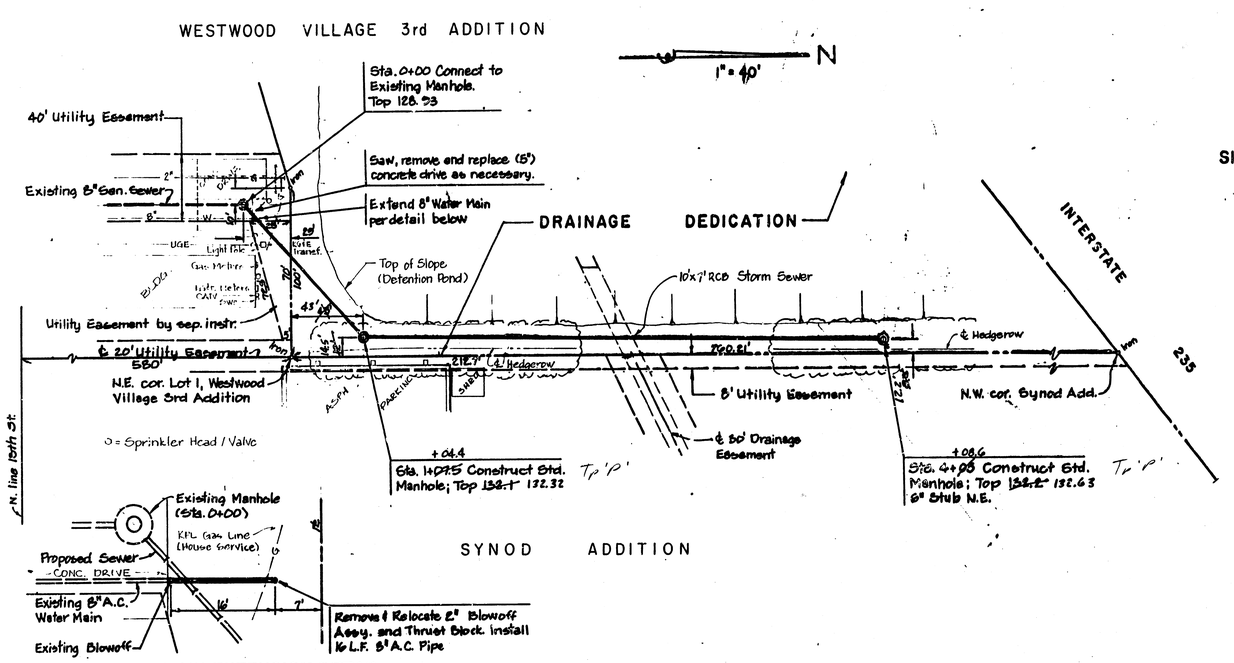


WATER MAIN EXTENSION DETAIL

Note: Water Main to be constructed per std. Water Dept. specifications, rev. 1-1-88

BENCH MARK:
"D" cut on N.W. cor. concrete walk @ sta. 0+14, 65' rt.; elev. 129.79

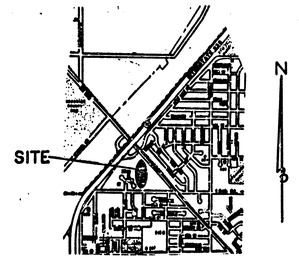

VICINITY MAP

APPROVED AS NOTED
By CITY ENGINEER OF WICHITA
Sanitary Sewers 3/7/89
Storm Sewers
Driveway Approaches
Water Mains
Paving

NOTE TO CONTRACTOR


INSPECTION AND TESTING FOR THIS PROJECT IS TO BE PROVIDED BY A LICENSED CONSULTING ENGINEERING FIRM UNDER CONTRACT WITH THE OWNER/DEVELOPER. SAID INSPECTION TO BE IN ACCORDANCE WITH THE CITY OF WICHITA STANDARD CONSTRUCTION ENGINEERING PRACTICES AND CERTIFIED BY A LICENSED PROFESSIONAL ENGINEER. NO WORK SHALL BE PERFORMED IN DEDICATED EASEMENTS OR PUBLIC RIGHT-OF-WAY BY THE CONTRACTOR WITHOUT SUCH INSPECTION NOR SHALL ANY WORK BE COMMENCED WITHOUT WRITTEN AUTHORIZATION BY THE CITY ENGINEER.

GENERAL NOTES

1. Existing utilities and their locations, as shown on the plans, represent the best information obtainable for design. The Contractor shall be required to verify those locations in the field, and to work around existing utilities within the easement.
2. The Contractor shall trim and/or remove trees which are in direct conflict with the proposed construction. Trees which are not in direct conflict shall be saved.
3. The Contractor shall not excavate, operate equipment on, or otherwise disturb the slope of the detention pond to the left of the proposed sewer alignment. No construction equipment shall be operated to the left (north or west) of the sewer line trench.
4. The top of the berm shall be regraded after construction, seeded with K-31 fescue, fertilized, and mulched according to the standard specifications of the City of Wichita.
5. The Contractor shall remove and replace concrete driveway pavement, remove all excess materials, rubble, and tree trimmings, and otherwise leave the work area in as good a condition as before construction.
6. The Contractor shall be required to repair or replace any underground sprinkler system damaged by his operations.
7. The Contractor shall be responsible for preserving property corner irons as shown on the plans. The Contractor shall be required to re-establish, at his own expense, any such irons disturbed by his operations. Such irons shall be reset by a licensed surveyor in accordance with state laws.
8. The cost of all above described work shall be incidental to and included in the Contractor's bid price.

PLAN — SURVEYED / NOTED / STAKED / ALIGNMENT CHECKED BY CITY CHECK? — NOTE BOOK — No. BA-40 — DATE

PROFILE — SURVEYED / NOTED / STAKED / GRADES CHECKED / R/W - NOTED / ELEVATIONS CHECKED — NOTE BOOK — No. BA-40 — DATE

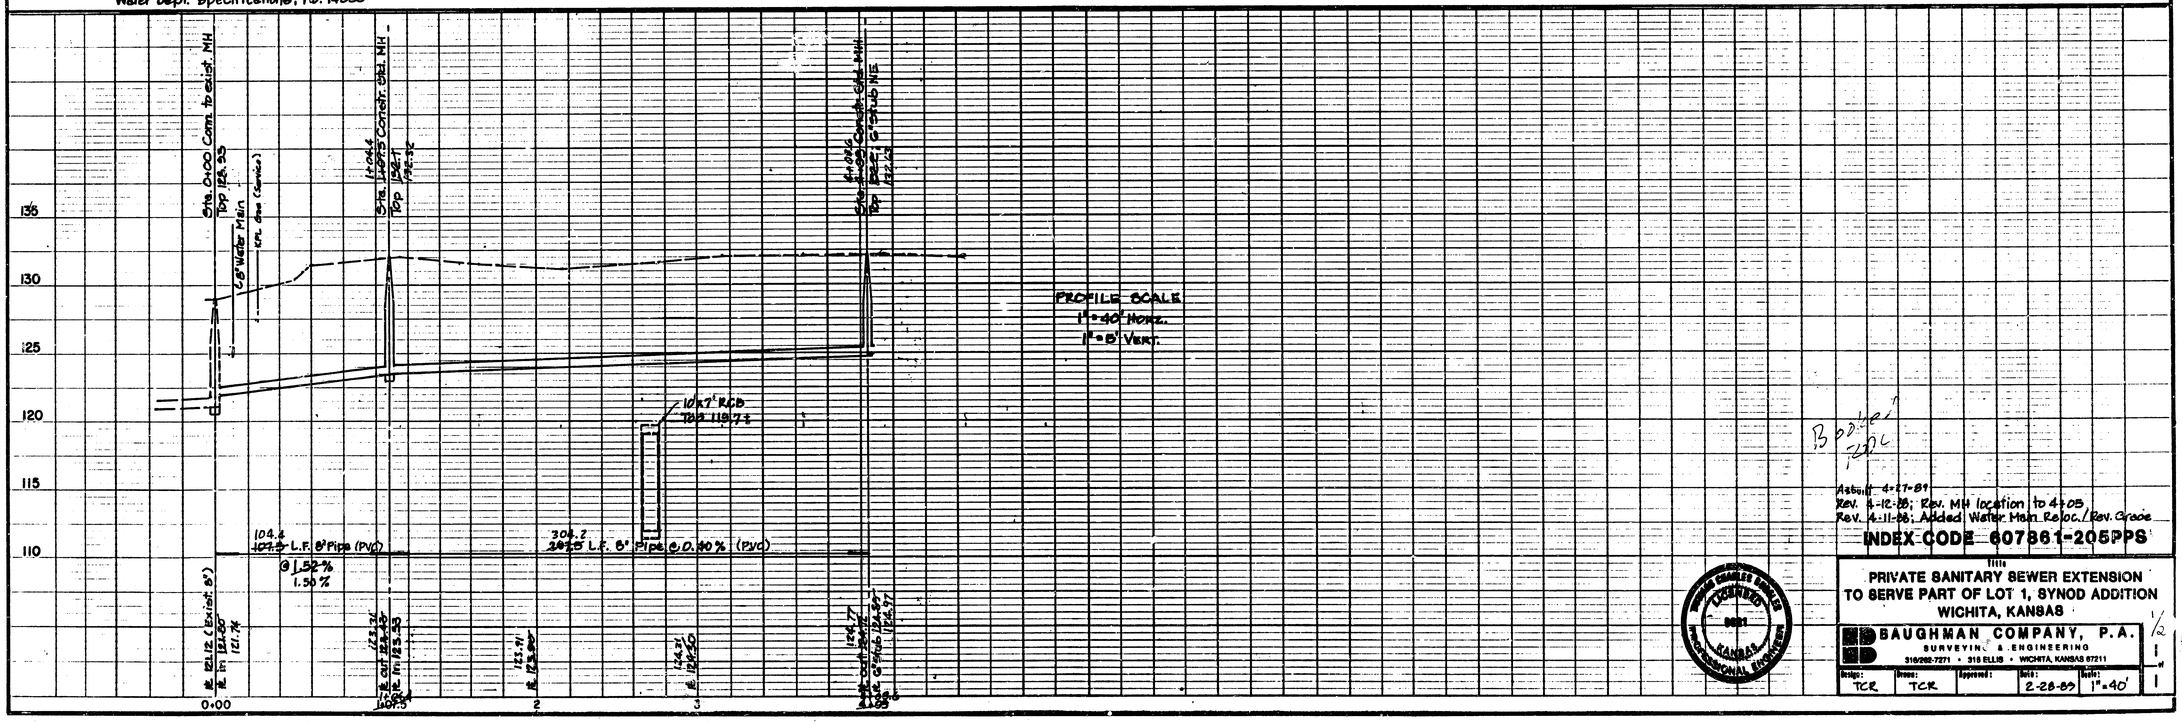

Bobbie 1-20-89

As-built 4-27-89
Rev. 4-12-89: Rev. MH location to 4+05
Rev. 4-11-89: Added Water Main Reloc. / Rev. Grade


INDEX CODE 607861-205PPS


Title
PRIVATE SANITARY SEWER EXTENSION TO SERVE PART OF LOT 1, SYNOD ADDITION WICHITA, KANSAS

BAUGHMAN COMPANY, P.A.
SURVEYING & ENGINEERING
316/262-7271 • 315 ELLIS • WICHITA, KANSAS 67211

Design:	Drawn:	Approved:	Date:	Scale:
TCR	TCR		2-28-89	1" = 40'

1/2

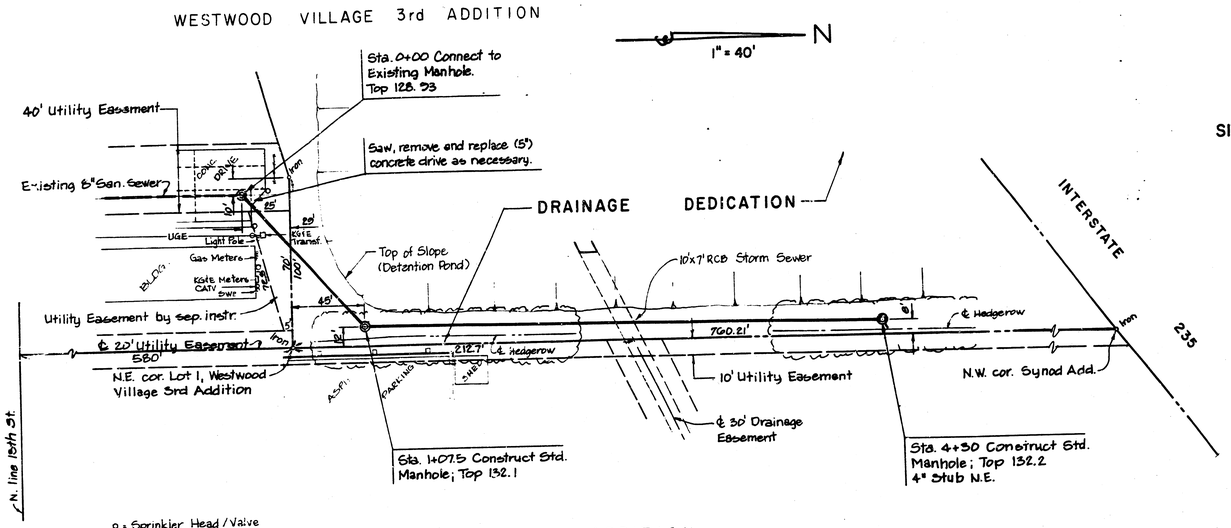

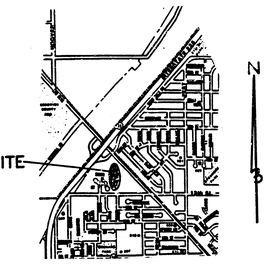

VICINITY MAP

APPROVED AS NOTED
By CITY ENGINEER OF WICHITA

Sanitary Sewers 3/7/89

Storm Sewers

Driveway Approaches

Water Mains

Paving


NOTE TO CONTRACTOR

INSPECTION AND TESTING FOR THIS PROJECT IS TO BE PROVIDED BY A LICENSED CONSULTING ENGINEERING FIRM UNDER CONTRACT WITH THE OWNER/DEVELOPER. SAID INSPECTION TO BE IN ACCORDANCE WITH THE CITY OF WICHITA STANDARD CONSTRUCTION ENGINEERING PRACTICES AND CERTIFIED BY A LICENSED PROFESSIONAL ENGINEER. NO WORK SHALL BE PERFORMED IN DEDICATED EASEMENTS OR PUBLIC RIGHT-OF-WAY BY THE CONTRACTOR WITHOUT SUCH INSPECTION NOR SHALL ANY WORK BE COMMENCED WITHOUT WRITTEN AUTHORIZATION BY THE CITY ENGINEER.

GENERAL NOTES

1. Existing utilities and their locations, as shown on the plans, represent the best information obtainable for design. The Contractor shall be required to verify those locations in the field, and to work around existing utilities within the easement.
2. The Contractor shall trim and/or remove trees which are in direct conflict with the proposed construction. Trees which are not in direct conflict shall be saved.
3. The Contractor shall not excavate, operate equipment or otherwise disturb the slope of the detention pond to the left of the proposed sewer alignment. No construction equipment shall be operated to the left (north or west) of the sewer line trench.
4. The top of the berm shall be regraded after construction, seeded with K-31 fescue, fertilized, and mulched according to the standard specifications of the City of Wichita.
5. The Contractor shall remove and replace concrete driveway pavement, remove all excess materials, rubble, and tree trimmings, and otherwise leave the work area in as good a condition as before construction.
6. The Contractor shall be required to repair or replace any underground sprinkler system damaged by his operations.
7. The Contractor shall be responsible for preserving property corner irons as shown on the plans. The Contractor shall be required to re-establish, at his own expense, any such irons disturbed by his operations. Such irons shall be reset by a licensed surveyor in accordance with state laws.
8. The cost of all above described work shall be incidental to and included in the Contractor's bid price.

BENCH MARK:
"a" cut on N.W.cor. concrete walk
@ sta. 0+14, 65' rt.; elev. 129.29

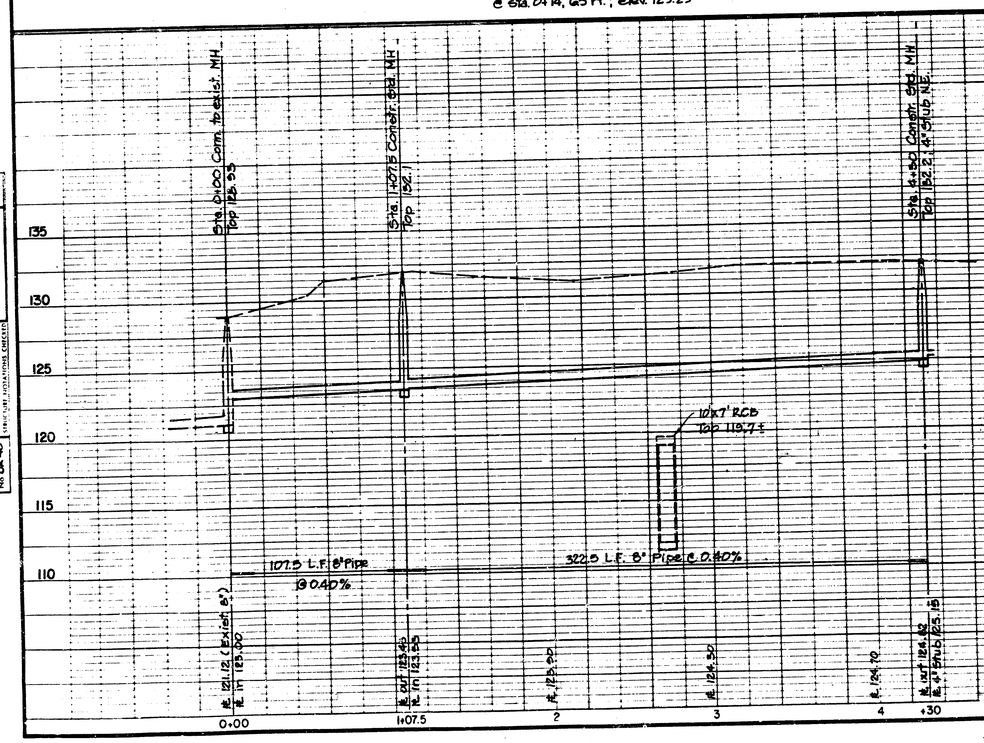

PROFILE SCALE
1" = 40' HORZ.
1" = 5' VERT.

INDEX CODE 607861-205PPS

Title
PRIVATE SANITARY SEWER EXTENSION TO SERVE PART OF LOT 1, SYNOD ADDITION WICHITA, KANSAS

BAUGHMAN COMPANY, P.A.
SURVEYING & ENGINEERING
316/262-7771 • 315 ELLIS • WICHITA, KANSAS 67211

Design:	Drawn:	Approved:	Date:	Scale:	Sheet	of
TCR	TCR		2-28-89	1"=40'	1	1

PROFILE — NOTE BOOK — No. BA-40

2/2