


Note: Install stubs south & southwest out of new man hole.

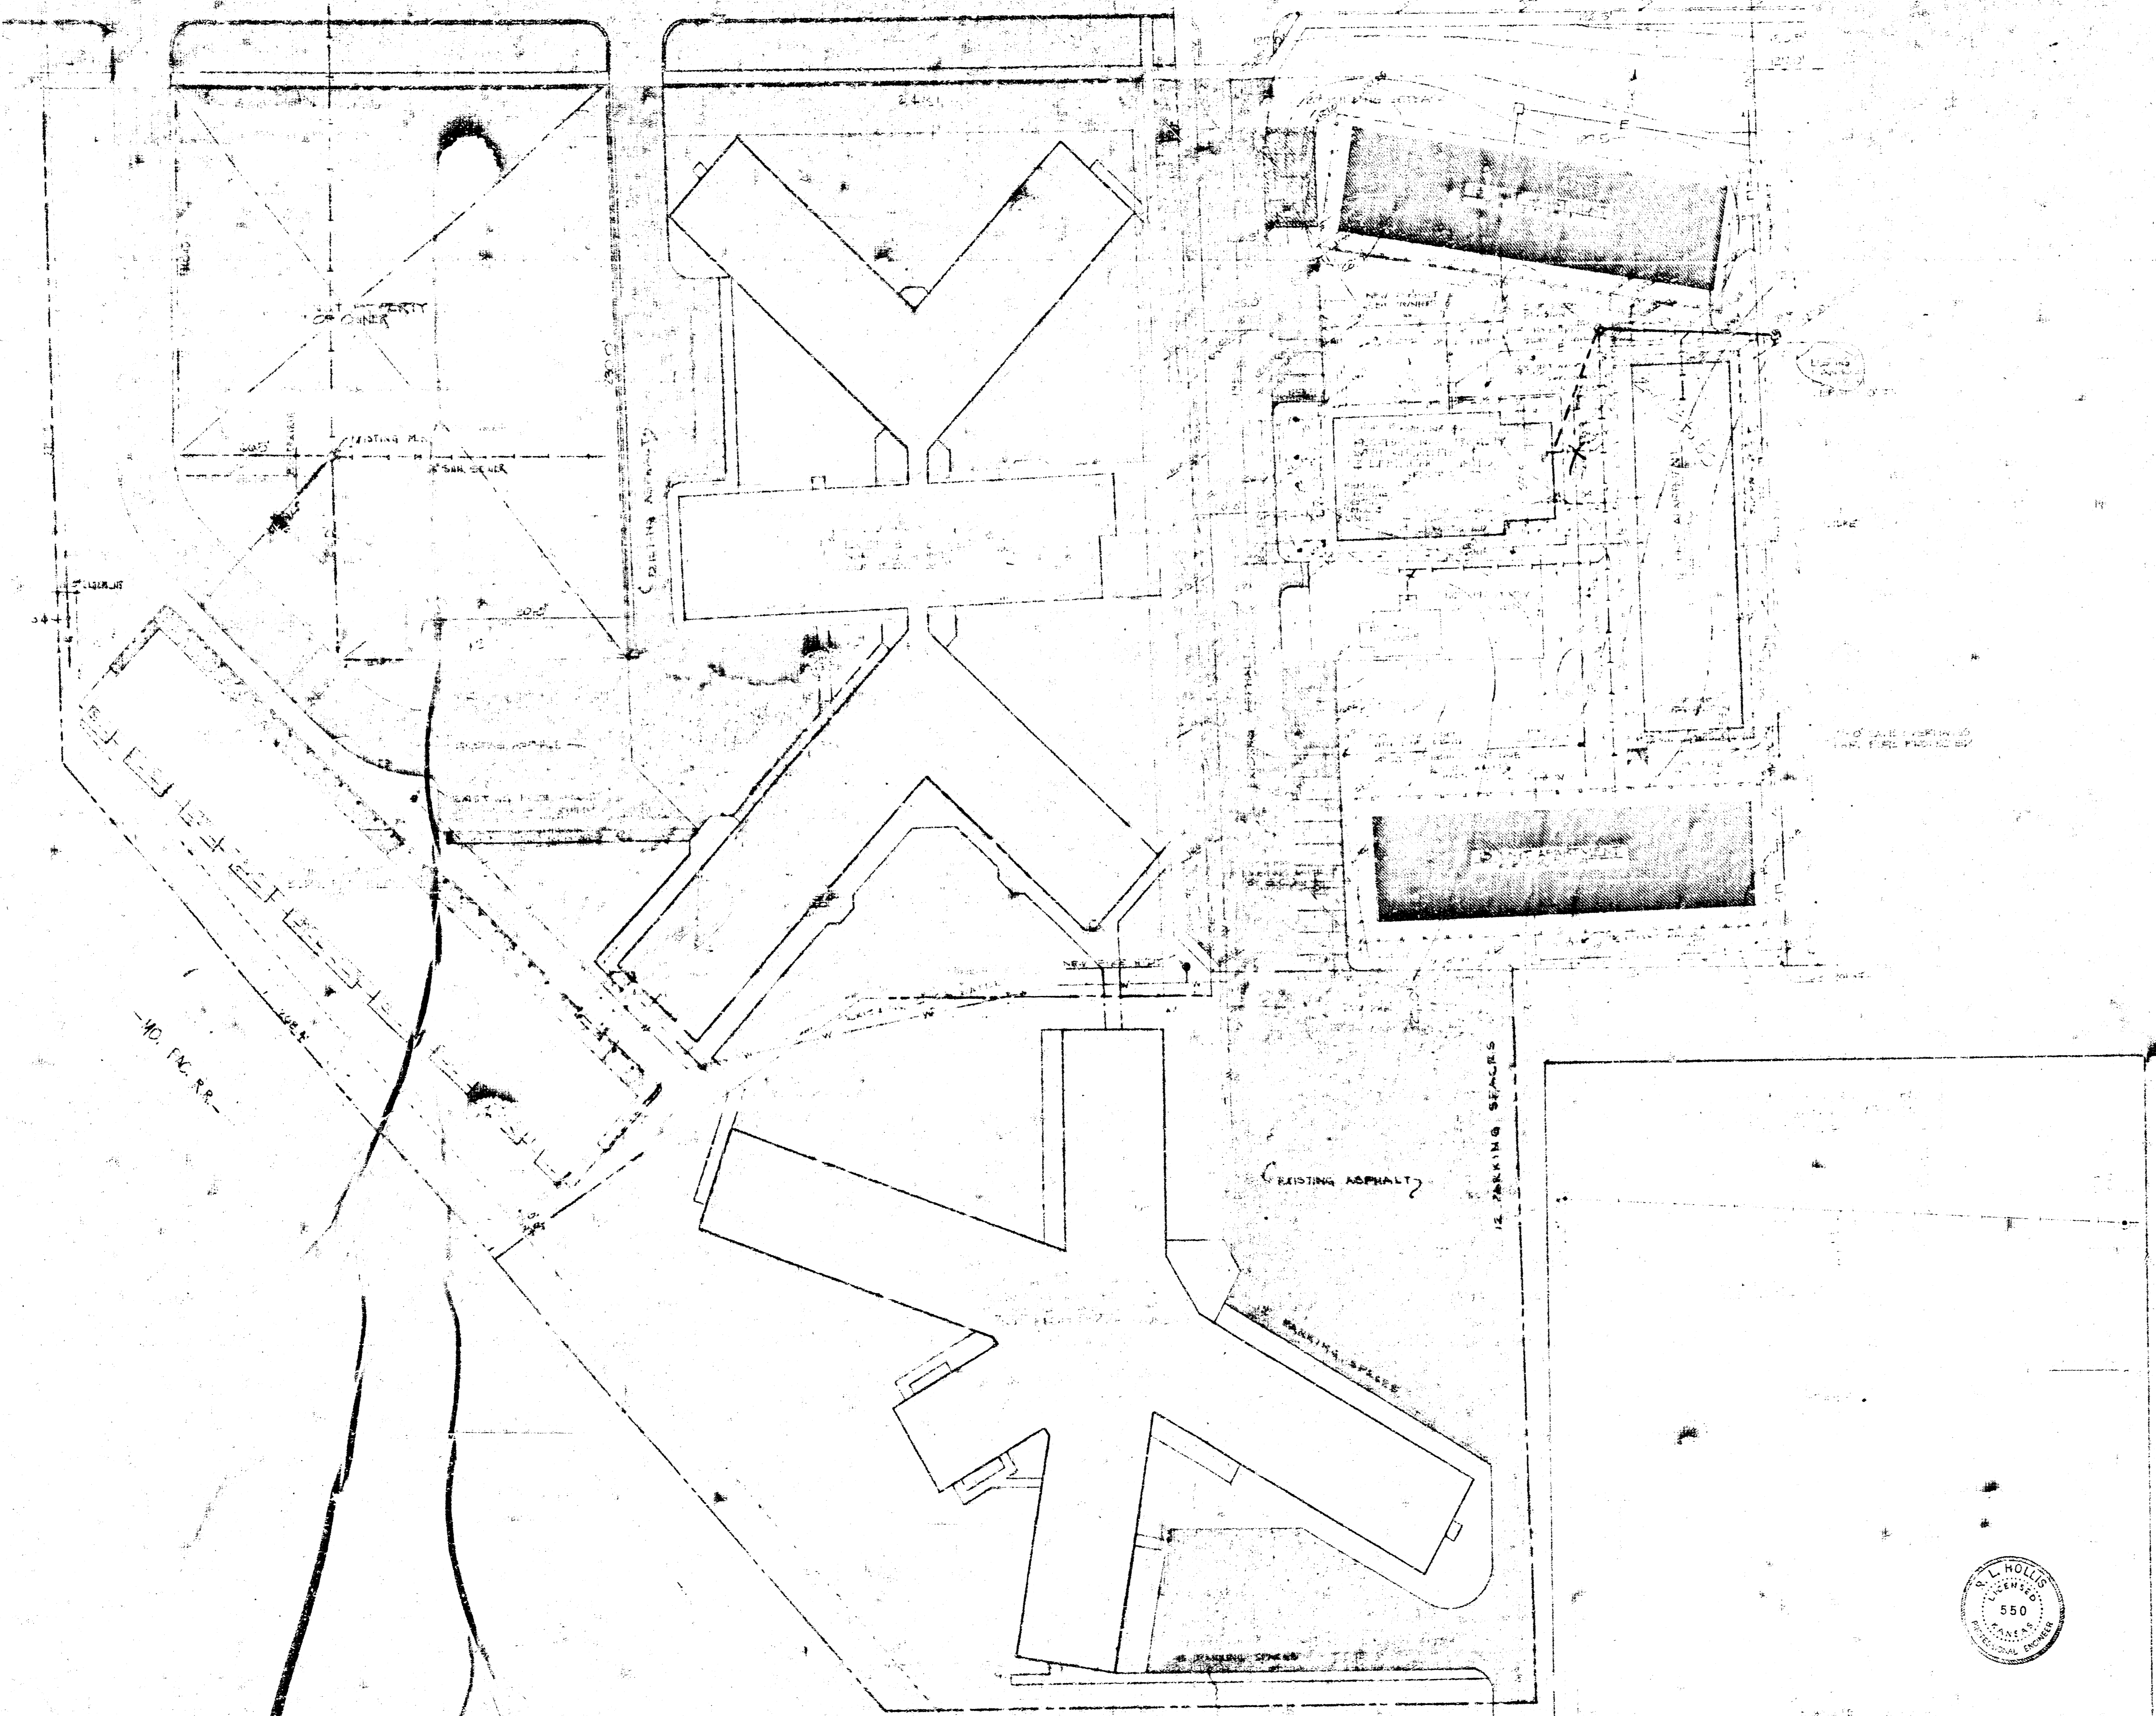

MATERIALS SYMBOLS


- [Symbol] CONCRETE
- [Symbol] BRICK
- [Symbol] ROUGH WOOD
- [Symbol] FINISHED WOOD
- [Symbol] STAIN
- [Symbol] GYP. PL.
- [Symbol] INSULATION
- [Symbol] GYP. BOARD

PLAT PLAN SYMBOLS

- [Symbol] SEWER
- [Symbol] GAS
- [Symbol] WATER
- [Symbol] PROPERTY LINE
- [Symbol] FINISH CONTOUR
- [Symbol] EXISTING CONTOUR
- [Symbol] EXISTING GRIDES
- [Symbol] FINISH GRADE
- [Symbol] GROUND WATER
- [Symbol] VALLEY DESIGN OF WATER

10-22-74
 APPROVED AS NOTED
 By CITY ENGINEER OF WICHITA
 Sanitary Sewers **J.D.S.**
 Storm Sewers
 Driveway Approaches

NOTE TO CONTRACTOR
 The project will be constructed under the supervision of the CITY ENGINEER and conforming to the SPECIFICATIONS of the CITY OF WICHITA. The CONTRACTOR will reimburse the City of Wichita for all cost of Engineering, Plans and Inspection.

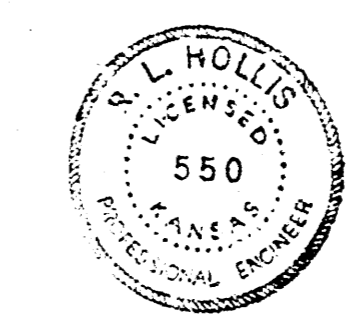

GENERAL NOTES

- 1. ALL DIMENSIONS UNLESS OTHERWISE SPECIFIED ARE IN FEET AND INCHES.
- 2. ALL DIMENSIONS TO FACE UNLESS OTHERWISE SPECIFIED.
Proj. No. DBKW 704060