
Note. Install stubs south & southwest out of new manhole.

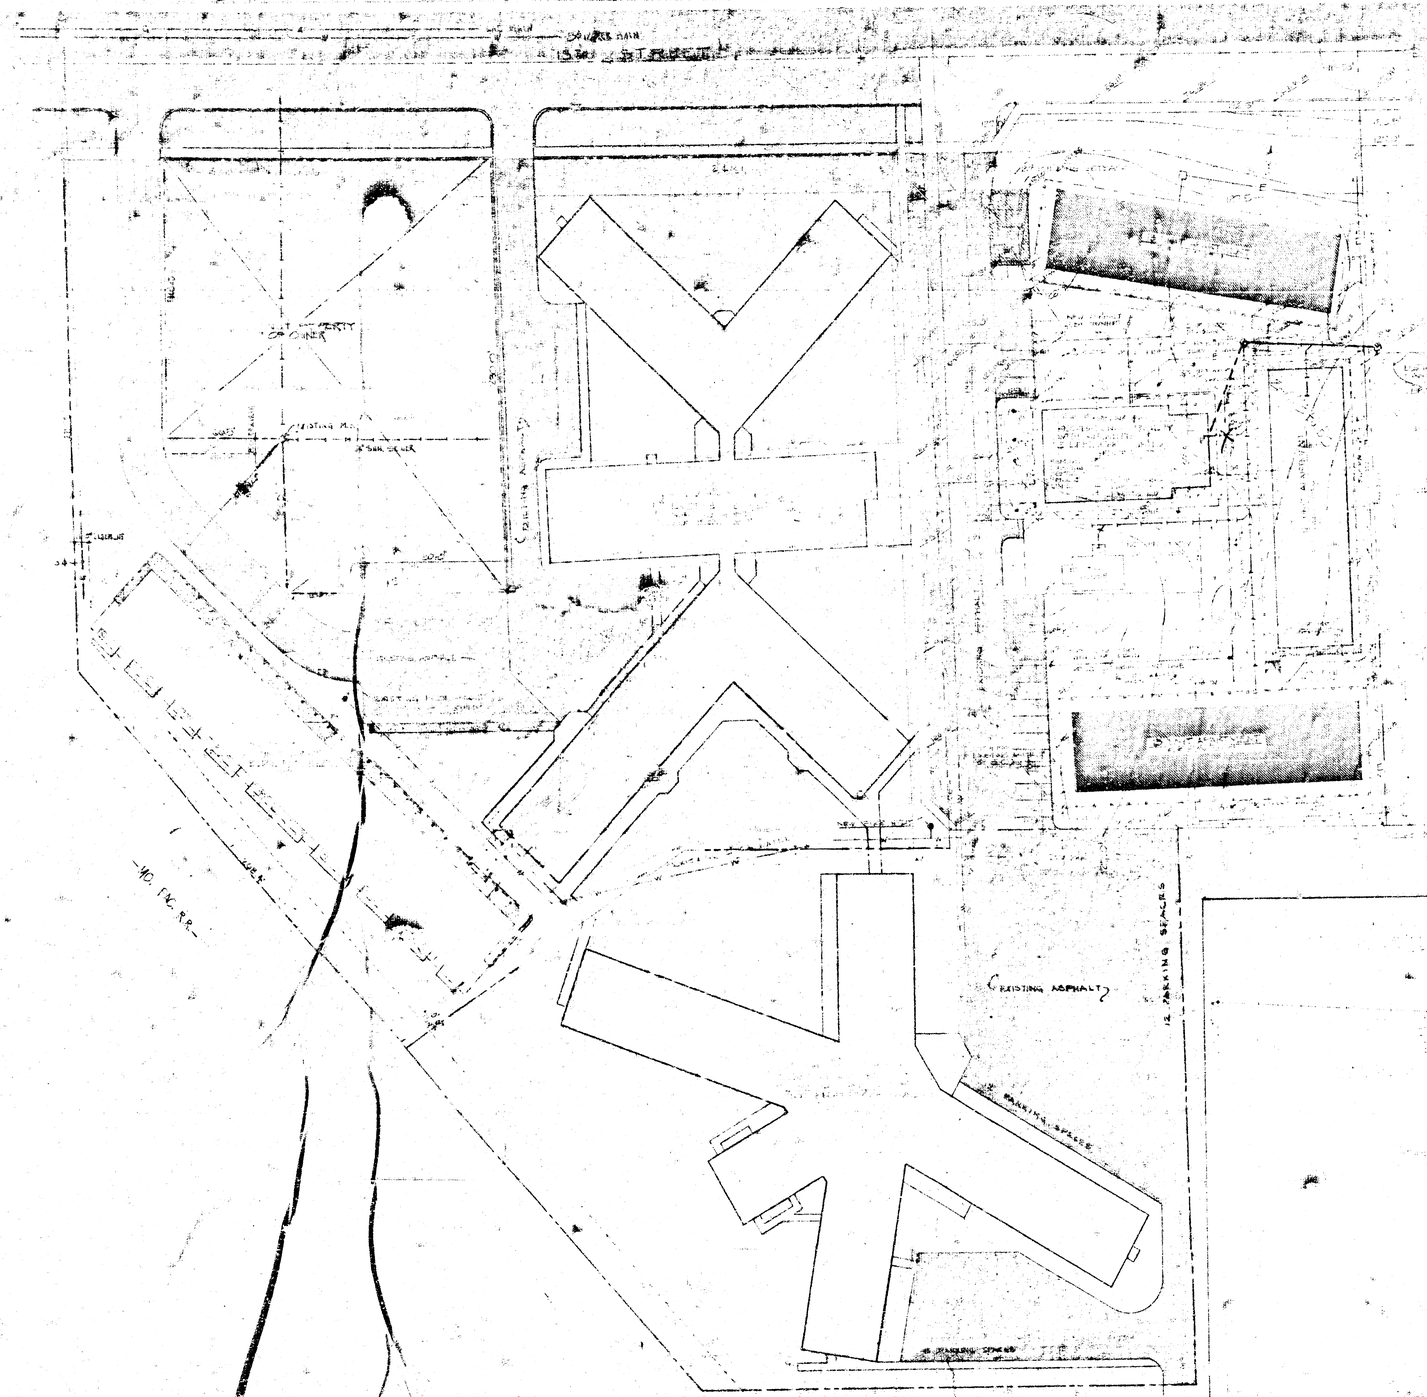

PLOT PLAN
1" = 30'-0"

GENERAL NOTES:

- ALL ITEMS NOT SPECIFICALLY CALLED [illegible] BY CONTRACTOR UNLESS SPECIFICALLY CALLED [illegible]
- [illegible] EXPANSION JOINT WHERE SIDEWALKS ARE PARALLEL [illegible] STREET TO [illegible] SURFACES
- [illegible] TO MAKE ALL SURFACES ACCESSIBLE AND/OR COMPATIBLE TO EXISTING IN NOTED SHOWN. CUT JOINTS AT 5'-0" O.C. [illegible]
- [illegible] PLAN [illegible] PRIOR TO 1ST POUR FROM DRAWING. NO GRADES TO SLOPE MORE THAN ONE FT ELEV IN FIVE FT. DISTANCE.
- SEE CONTRACTOR FILL "BOX" PRESTRE TO EXTEND 6" BEYOND BUILDING, DRIVES AND PARKING. ALL LOADS BEARING TO 500 LB/SQ. FT. PER FT. MAX.
- ALL EARTHWORK BY GENERAL CONTRACTOR TO COMPLETE ELEVATIONS REQUIRED BY TOP LINE OF GRADING LINE
- CONTRACTOR TO VERIFY ALL DIMENSIONS AND CONDITIONS, INCLUDING ALL UTILITIES, PRIOR TO STARTING EACH PHASE OF WORK.

MATERIALS SYMBOLS

- CONCRETE
- BRICK
- ROUGH WOOD
- FINISHED WOOD
- FILL
- EARTH
- SAND
- INSULATION
- BATT, BLANKET OR RIGID

PLOT PLAN SYMBOLS

- SEWER
- GAS
- WATER
- PROPERTY LINE
- FINISH CONTOURS
- EXISTING CONTOURS
- EXISTING GRADES
- FINISH GRADE
- SEWER
- VALLEY/DIVISION OF WATER FLOW

10-22-74

APPROVED AS NOTED
By CITY ENGINEER OF WICHITA
Sanitary Sewers 8" D.E.S.
Storm Sewers
Driveway Approaches

NOTE TO CONTRACTOR

This project will be constructed under the supervision of the CITY ENGINEER and conforming to the SPECIFICATIONS of the CITY OF WICHITA. The CONTRACTOR will reimburse the City of Wichita for all cost of Engineering, Plans, and Inspection.

R. C. HOLLIS LICENSED 550 REGISTERED PROFESSIONAL ENGINEER

Proj. No. DORW 704060

TERRACE GARDENS MANOR, INC. VILLA [illegible]

RAPP, DAVID N. HOLLIS ARCHITECTS - WICHITA, KANSAS