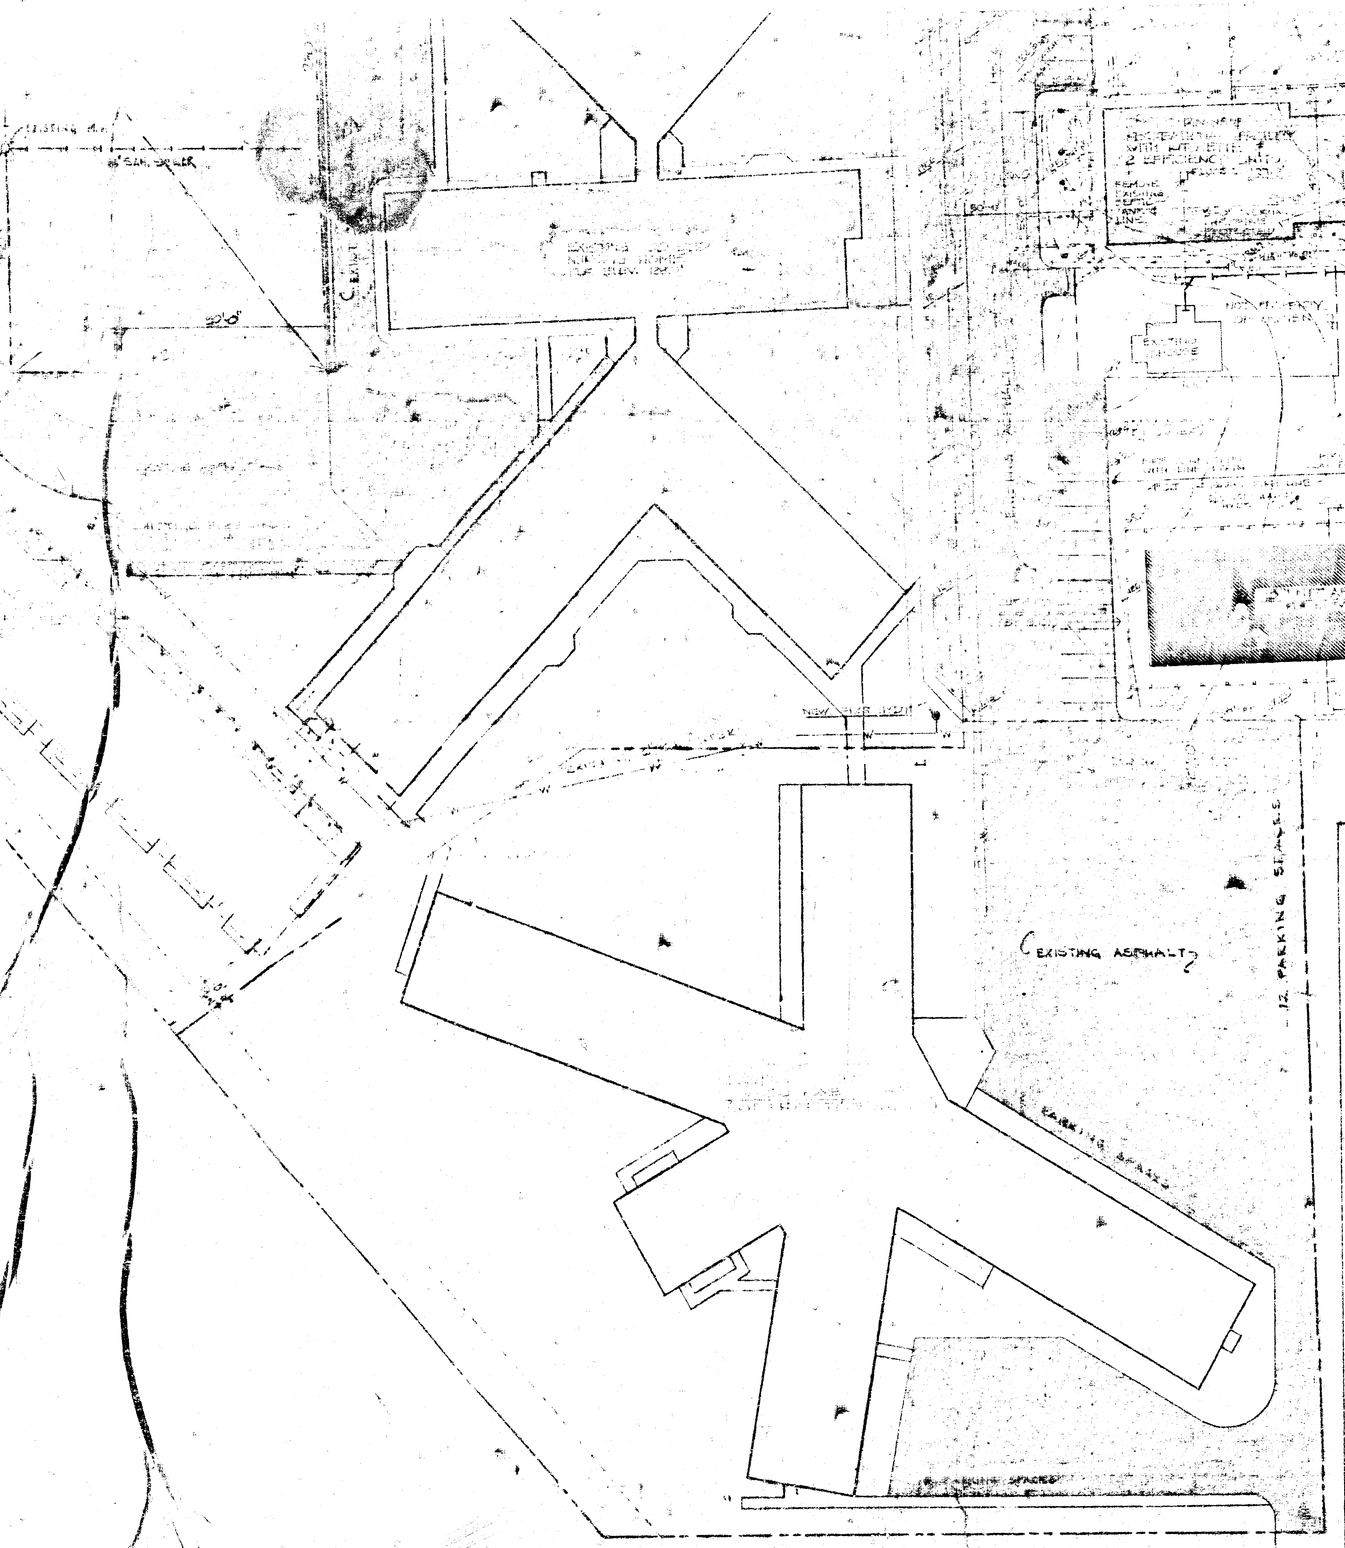


PLOT PLAN 1" = 30'-0"

PLOT PLAN SYMBOLS

- SEWER
- GAS
- WATER
- PROPERTY LINE
- FINISH CONTOURS
- EXISTING CONTOURS
- EXISTING GRADES
- FINISH GRADE

10-22-74

APPROVED AS NOTED
By CITY ENGINEER OF WICHITA
Sanitary Sewers 8" D.E.S.
Storm Sewers
Driveway Approaches:

NOTE TO CONTRACTOR

This project will be constructed under the supervision of the CITY ENGINEER and conforming to the SPECIFICATIONS of the CITY OF WICHITA. The CONTRACTOR will reimburse the City of Wichita for all cost of Engineering, Plans, and Inspection.

R. L. HOLLIS
LICENSED
550
KANSAS
PROFESSIONAL ENGINEER

FIRE PROTECTION REVISION—7/12/74

...ETS THIRD ADDITION

GENERAL NOTES

- ...SHALL BE DONE BY CONTRACTOR UNLESS SPECIFICALLY CALLED THERE...
- ...EXPANSION JOINT WHERE SIDEWALKS AND PORCHES ... SURFACES
- ... TO ... UNIFORM SCALE FROM BUILDING AND/OR CONFORM ... REVISIONS OF NOTES SHOWN. CUT JOINTS AT 5'-0" O.C. ... AT 30'-0" O.C.
- ... PAINT 10'-0" AWAY FROM BUILDING. NO ... SLOPE MORE THAN ONE FT. RISE IN FOUR FT. DISTANCE.
- ALL COMPACTED FILL 95% PROCTOR TO EXTEND 6'-0" BEYOND BUILDING, KEYES, AND PACKING. ALL LOADS BEARING TO SOIL 1750 LBS./ SQ. FT. MAX.
- ALL EARTHWORK BY GENERAL CONTRACTOR TO COMPACTED ELEVATIONS REQUIRED UP TO LIMIT OF GRADING LINE
- ALL CONTRACTORS TO VERIFY ALL DIMENSIONS AND CONDITIONS, INCLUDING ALL UTILITIES, PRIOR TO STARTING EACH PHASE OF WORK