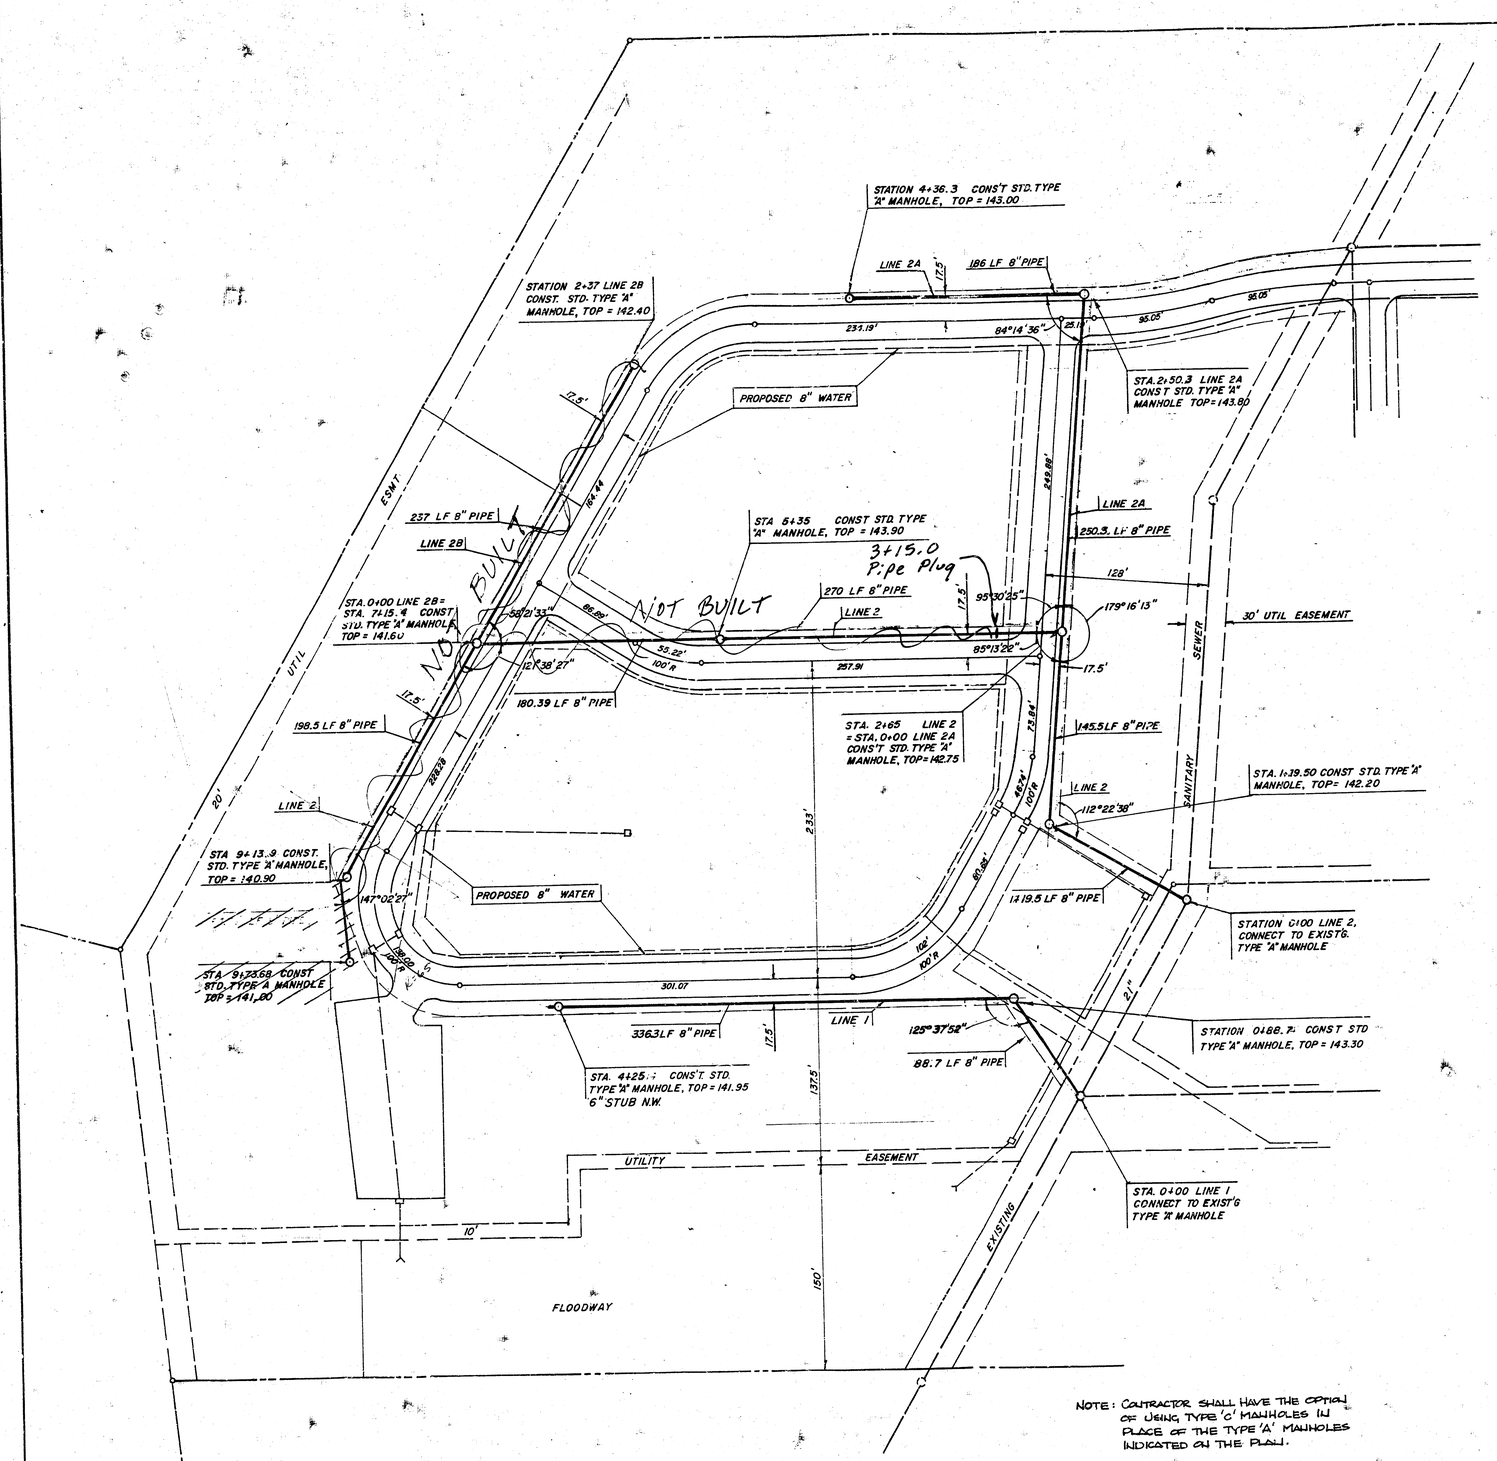


NOTE: CONTRACTOR SHALL HAVE THE OPTION OF USING TYPE 'C' MANHOLES IN PLACE OF THE TYPE 'A' MANHOLES INDICATED ON THE PLAN.

N

SCALE 1"=50'

APPROVED AS NOTED
By CITY ENGINEER OF WICHITA
Sanitary Sewers EJB 5/9/85
Storm Sewers _____
Driveway Approaches _____

NOTE TO CONTRACTOR

This project will be constructed under the supervision of the CITY ENGINEER and conforming to the SPECIFICATIONS of the CITY OF WICHITA. The CONTRACTOR will pay the City of Wichita for all costs of plan review, inspection and booking per contract.

K-268
Booked
8/31/88
RDL

MAY 1985

PRIVATE SANITARY SEWER TO SERVE PART OF LOT 3, TIMBER GROVE LAKES ADDITION


Proj. No. 017 PPS

CITY OF WICHITA, KS

Proj. no. 468-78-245-80001-000-000-017

BAUGHMAN COMPANY, P.A.
SURVEYING & ENGINEERING
316/262-7271 • 330 LAURA • WICHITA, KANSAS 67211

SCALE 1"= 5' VERT.
1"= 50' HORIZ.

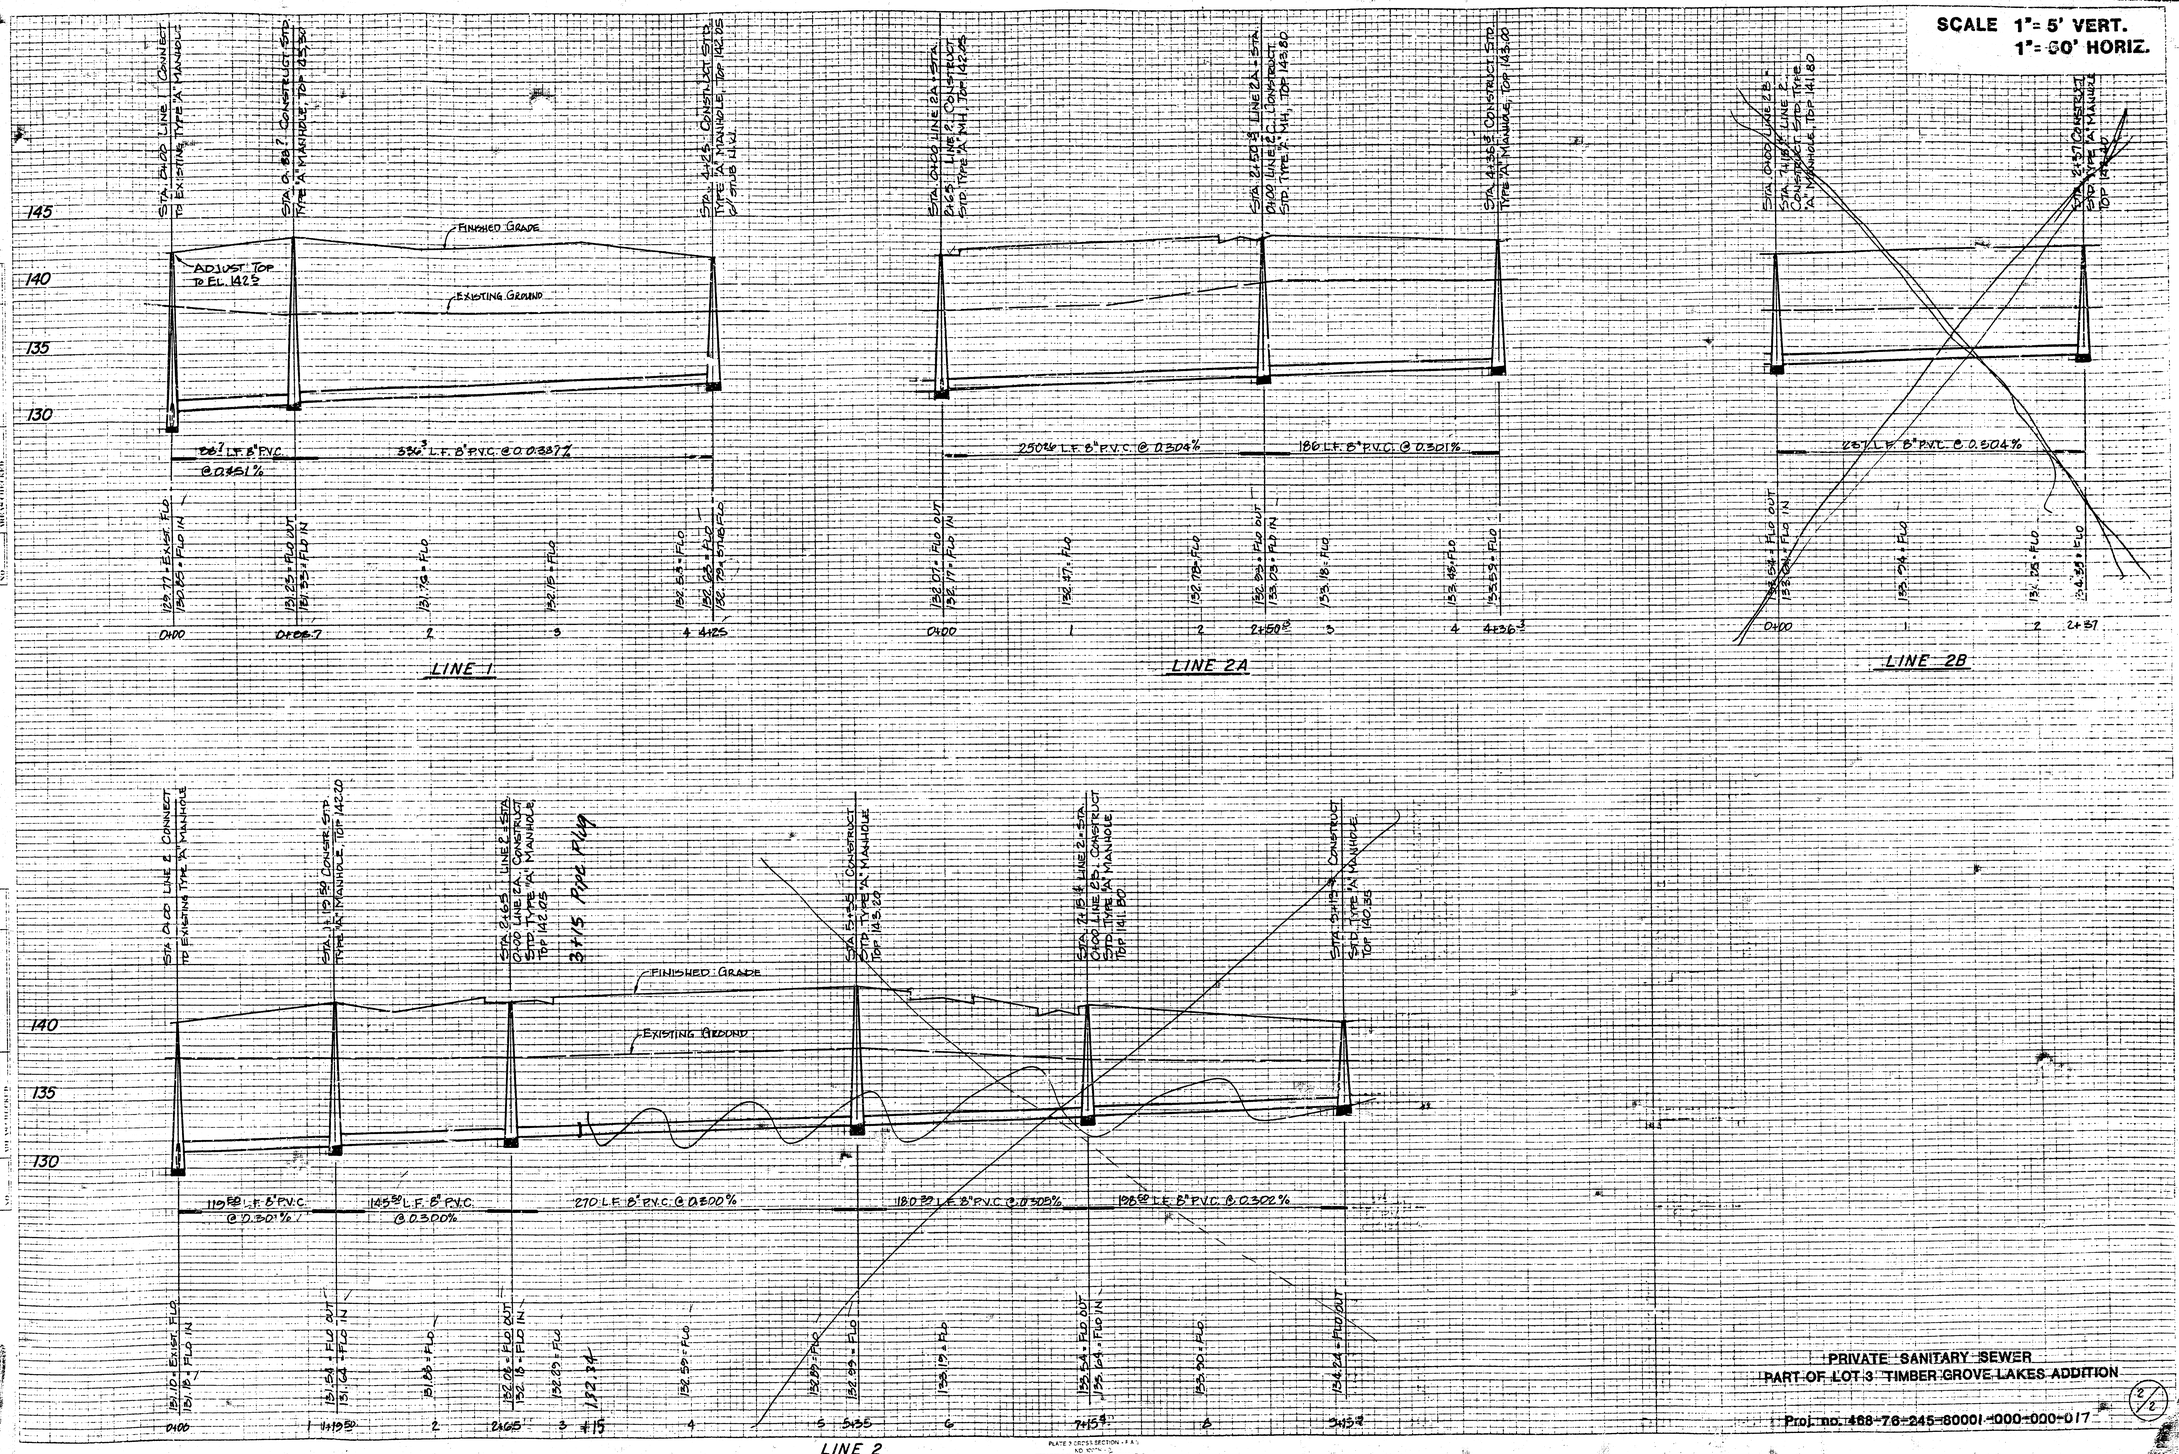

FINAL SURVEY
ORIGINAL SURVEY

PRIVATE SANITARY SEWER
PART OF LOT 3 TIMBER GROVE LAKES ADDITION

Proj. no. 468-76-245-80001-000-000-017

2/2

4 5 9r