
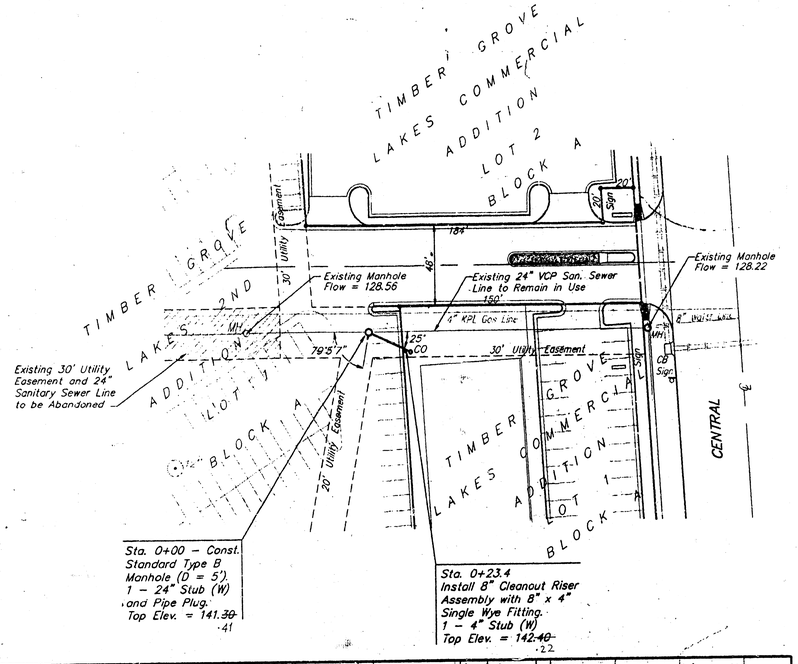


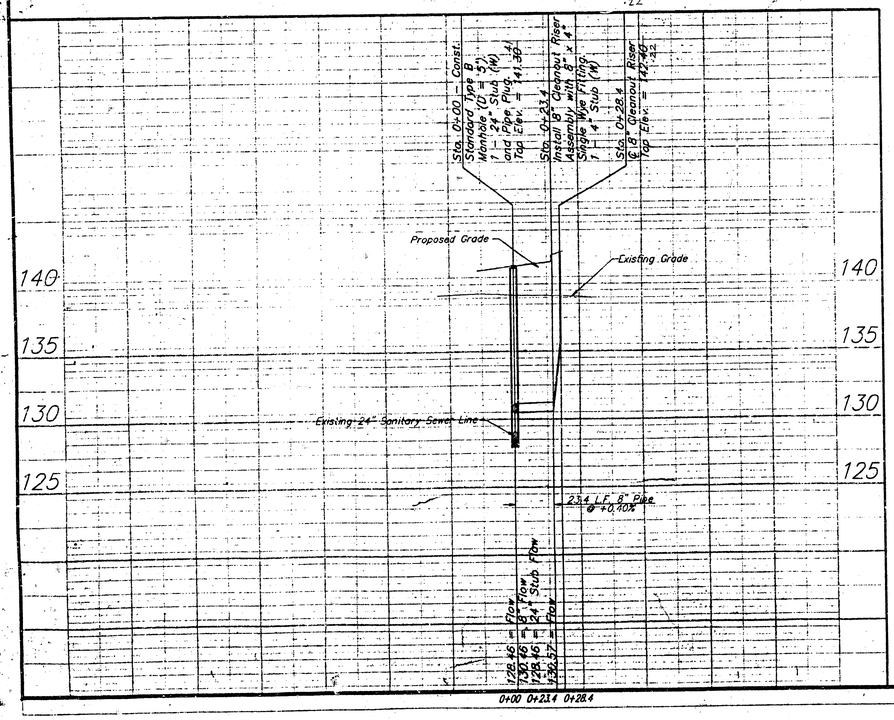

SCALE: 1" = 40' HORIZONTAL
1" = 5' VERTICAL

● = IRON

City Disc Located in Island at Northeast Corner of Maize Road and Central.


Elevation = 146.00 (City Datum)

"□" Cut in Top of Curb on West Side of Maize Road Between Lots 2 & 3, Block 1, Toh-N-Hah Village.

Elevation = 151.29 (City Datum)

GENERAL NOTE:

1. The Contractor shall be responsible for maintaining continuous flow of sewage through construction. Contractor's proposed method for maintaining sewage flow shall be approved by the Engineer. Cost of maintaining flow of sewage through construction will not be paid for directly and this cost shall be considered as subsidiary to the other pay items of work.

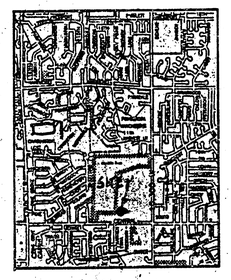

LOCATION MAP

Booked 1-19-95 JKB From As Builts

As Built 9-9-94 AZ

TIMBER GROVE LAKES COMMERCIAL ADDITION
SANITARY SEWER


BAUGHMAN COMPANY P.A.
ENGINEERING, SURVEYING & PLANNING
316-262-7271 • 313 ELLIS • WICHITA, KANSAS 67211


PROJECT NUMBER 483 PPS (607861) | SHEET NO. 1 OF 2

DESIGN	DRAWN	APPROVED	DATE	SCALE
NBW	DMV		7-27-94	NOTED

BRENT WOOTEN 8430 LICENSED PROFESSIONAL ENGINEER KANSAS


94-03-1694

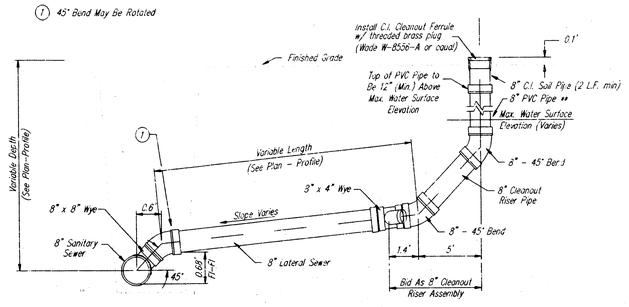

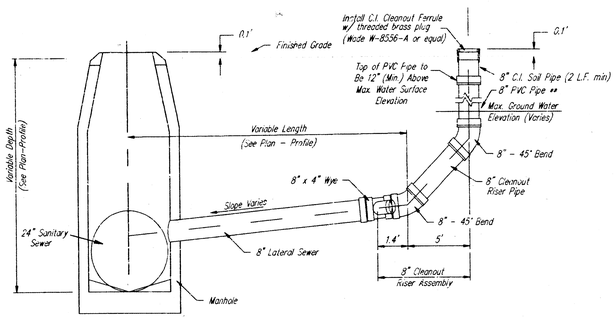


* 4" Branch To Serve as 4" Stub. Temporary Plug Until Service Connection is Required.

** 8" Lateral to be Air-Tested up to the Top of PVC Pipe, per Standard Specifications.

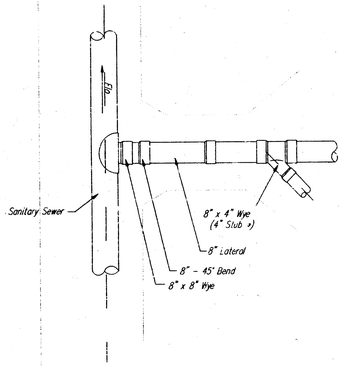

8" CLEANOUT RISER ASSEMBLY DETAIL
W/ WYE CONNECTION

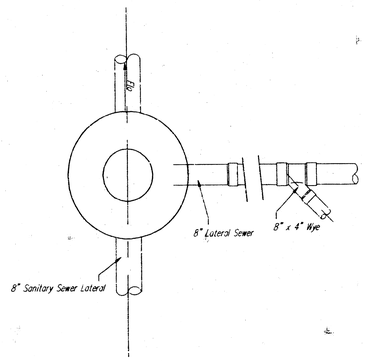

8" CLEANOUT RISER ASSEMBLY DETAIL
W/ MANHOLE CONNECTION

CLEANOUT RISER ASSEMBLY

BAUGHMAN COMPANY P. A.
ENGINEERING & SURVEYING
316/262-7271 • 315 ELLIS • WICHITA, KANSAS 67211

REV.

PROJECT NUMBER

SHEET 2 OF 2

DESIGN	DRAWN	APPROVED	DATE	SCALE
TCR	KLK		7-15-92	NONE

18-13-1