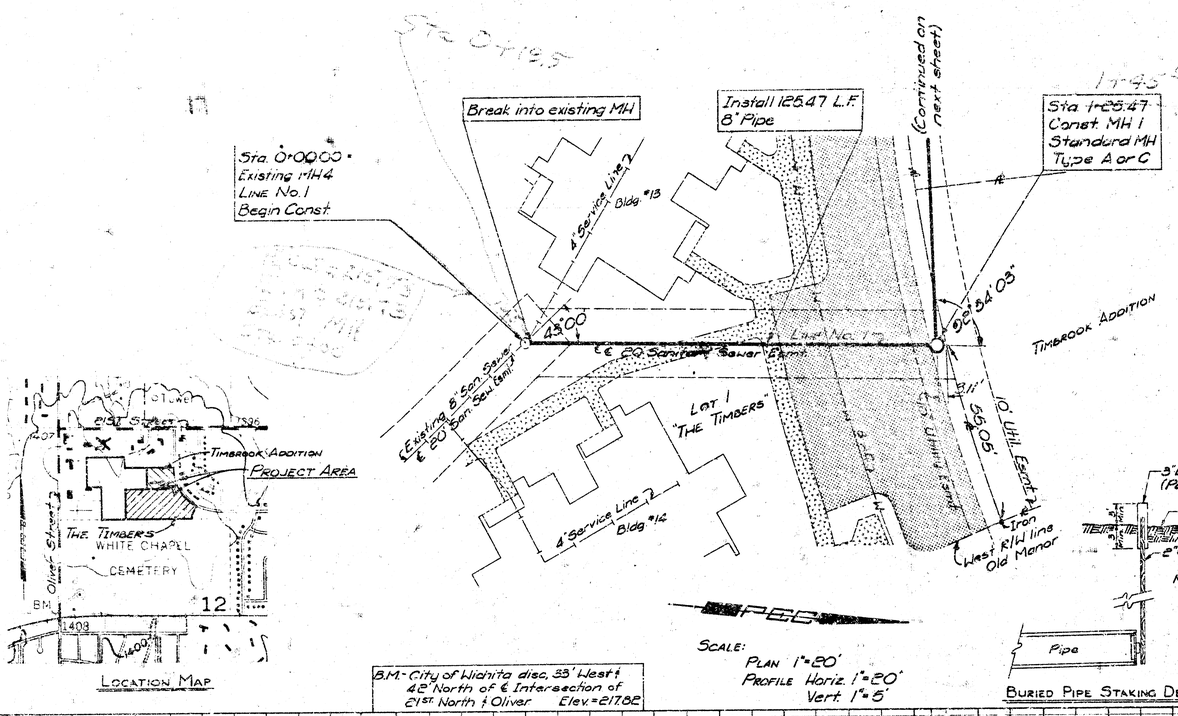


NOTES

1. All construction and materials to comply with standard City of Wichita Specifications.
2. Sewer line to be inspected by the Dept of Public Works Inspection.
3. Sidewalks, drives, and parking to be constructed under separate contract after completion of sanitary sewer construction.
   Sidewalk
   Bituminous parking and drive
4. The contractor will be required to notify each of the following utility companies prior to the beginning of construction and should request that any existing lines be flagged:

   City of Wichita Water Dept.
   455 N. Main St
   268-4557 Benny Gegen
5. The contractor is responsible for supporting and protecting the 8" A.C. Waterline during the period of time it is uncovered and for properly backfilling it in accordance with standard City of Wichita Specifications.
6. The existing 8" Sanitary Sewer and MH4 were constructed under City of Wichita Sanitary Sewer Project No. DBKW 707063.
7. All excavation shall be sand backfilled and flushed per City of Wichita Specifications.

NOTE TO CONTRACTOR
This project will be [illegible] the surveys on [illegible] and [illegible] to [illegible] Wichita [illegible] as inspection.

9-20-78
APPROVED AS NOTED
by CITY ENGINEER
Sanitary Sewers
Storm Sewers
Drainage Applications

PLAN
PROFILE
No. Revision By Date

KENNETH D. EVERITT LICENSED 4759 KANSAS PROFESSIONAL ENGINEER

CITY OF WICHITA
SEDGWICK COUNTY, KANSAS

TIMBERS / TIMBROOK SANITARY SEWER EXTENSION

C of W Project No. 468-76-245-60544-000-000-008

PROFESSIONAL ENGINEERING CONSULTANTS, P.A.
ENGINEERS
WICHITA, KANSAS

Designed by KDE | Job No. 78306 | Sht. 1 of 2
Drawn by RFJ | Date Aug. 1978

PLATE 1, PLAN-PROFILE
KUFFEL & ESSER CO.
46 7324 MADE IN U.S.A.

K-E PLATE 1, PLAN-PROFILE
KEUFFEL & ESSER CO.
46 7024 MADE IN U.S.A.

PROFILE
SCALES
HORIZ. 1" = 100'
VERT. 1" = 10'
NOTE ROOT
APPROVED
APPROVED
APPROVED
SPECIFICATION NOTATION CHECKED

KENNETH R. CERNEY
LICENSED
6759
KANSAS
PROFESSIONAL ENGINEER

CITY OF WICHITA
SEDGWICK COUNTY, KANSAS

SANITARY SEWER EXTENSION
TIMBERS / TIMBROOK

C of W Project No. 468-78-345-80544-000-000-089

PROFESSIONAL ENGINEERING CONSULTANTS, P.A.
ENGINEERS
WICHITA, KANSAS

Designed by: KDE | Job No. 78306 | Sht. 2 of 2
Drawn by: RFJ | Date: Aug. 1978

No.	Revision	By	Date

Note: Line No. 1, Sta. 4+24.8G to Sta. 5+93.8G shall be televised and air tested prior to installing plug at Sta. 5+93.8G.

Approx. location of abandoned 8" water line.

Install 1450.0 L.F 8" Pipe

Sta. 5+93.8G Install 1-8" Temp. Pipe Plug

Stake end of line See detail Sht No. 1

Sta. 4+24.8G Const. MH 3 Standard MH Type A or C

Install 930.0 L.F 8" Pipe

Sta. 3+31.8G Const. MH 2 Standard MH Type A or C

Install 609.35 L.F 8" Pipe

Sta. 1+25.47 MH 1

Install 1458.8 L.F 8" Pipe

Sta. 4+58.8G Const. MH 4A Standard MH Type A or C

Sta. 4+24.8G, Line No. 1A Sta. 0+00.0, Line No. 1A MH 3

Install 4-4" Stubs

Install 2-4" Stubs

Install 2-4" Stubs

Install 4-4" Stubs

Line No. 1

Line No. 1A

Line No. 2

Line No. 3

Line No. 4

Existing Ground

Edge of Mine

Approx. location of abandoned 8" water line

Easement

Utility Easement

10' Util Esmt

20'x5' Util Esmt

40'

STREET

20TH

30TH

"THE TIMBERS"

TIMBROOK ADDITION







