
9-9-74

APPROVED AS NOTED
By CITY ENGINEER OF WICHITA
Sanitary Sewers D.E.J.
Storm Sewers
Driveway Approaches

NOTE TO CONTRACTOR:
THIS PROJECT WILL BE CONSTRUCTED UNDER THE SUPERVISION OF THE CITY ENGINEER AND IN CONFORMANCE TO THE SPECIFICATIONS OF THE CITY OF WICHITA. THE CONTRACTOR MUST NOTIFY THE CITY OF WICHITA FOR INSPECTION AT LEAST 24 HOURS PRIOR TO THE BEGINNING OF CONSTRUCTION.

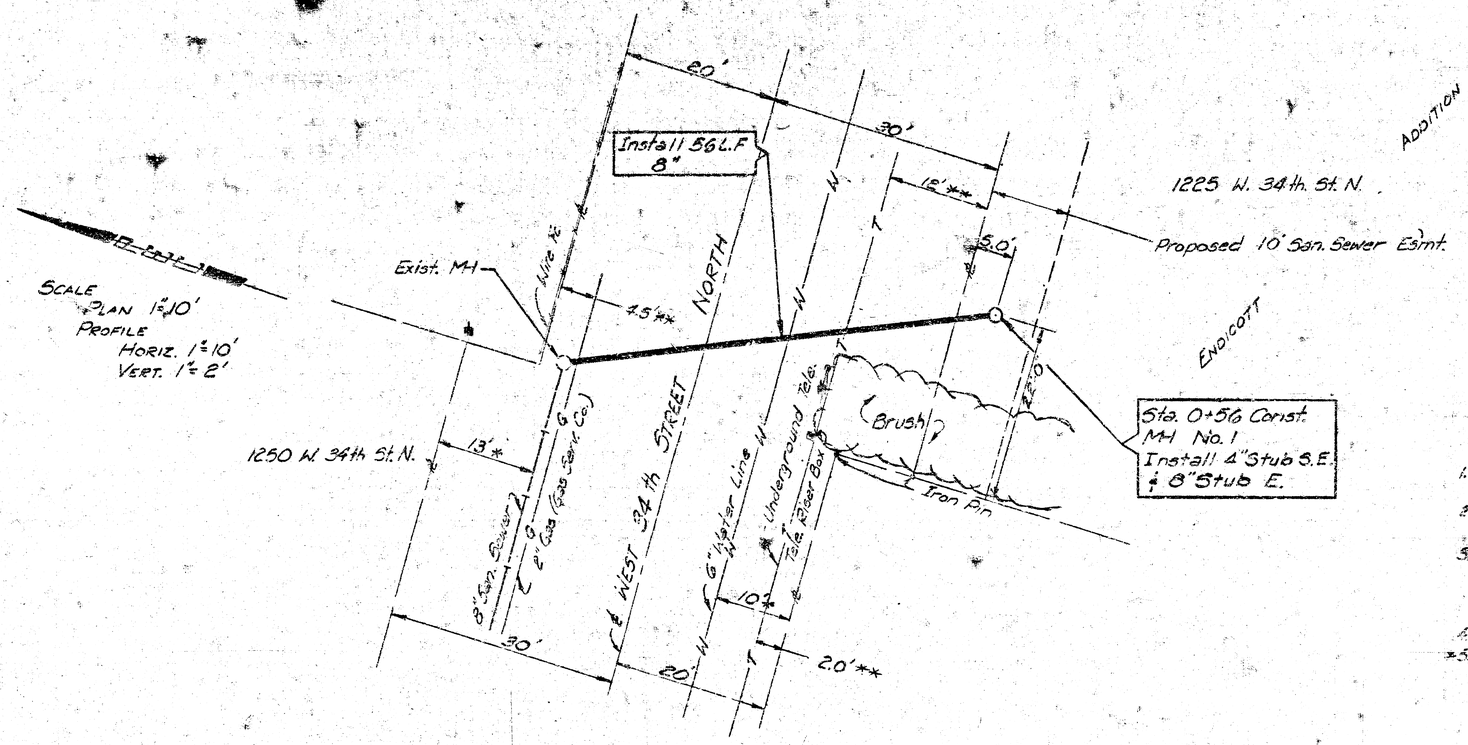


** Denotes approx. locations

GENERAL NOTES

1. All Manholes to be City of Wichita Type A & A Diameter Type A or C Manhole
2. Sewer lines to be inspected by the Dept of Public Works Inspection
3. All Manholes & Sewers will be constructed in accordance with City of Wichita Specifications for these items
4. Sand backfill & flush all sewer excavations
5. Excavate exist san sewer Manhole and Utilities prior to beginning work so the field engineer may adjust grade if necessary

B.M.-E Exist MH Elev. 124.86

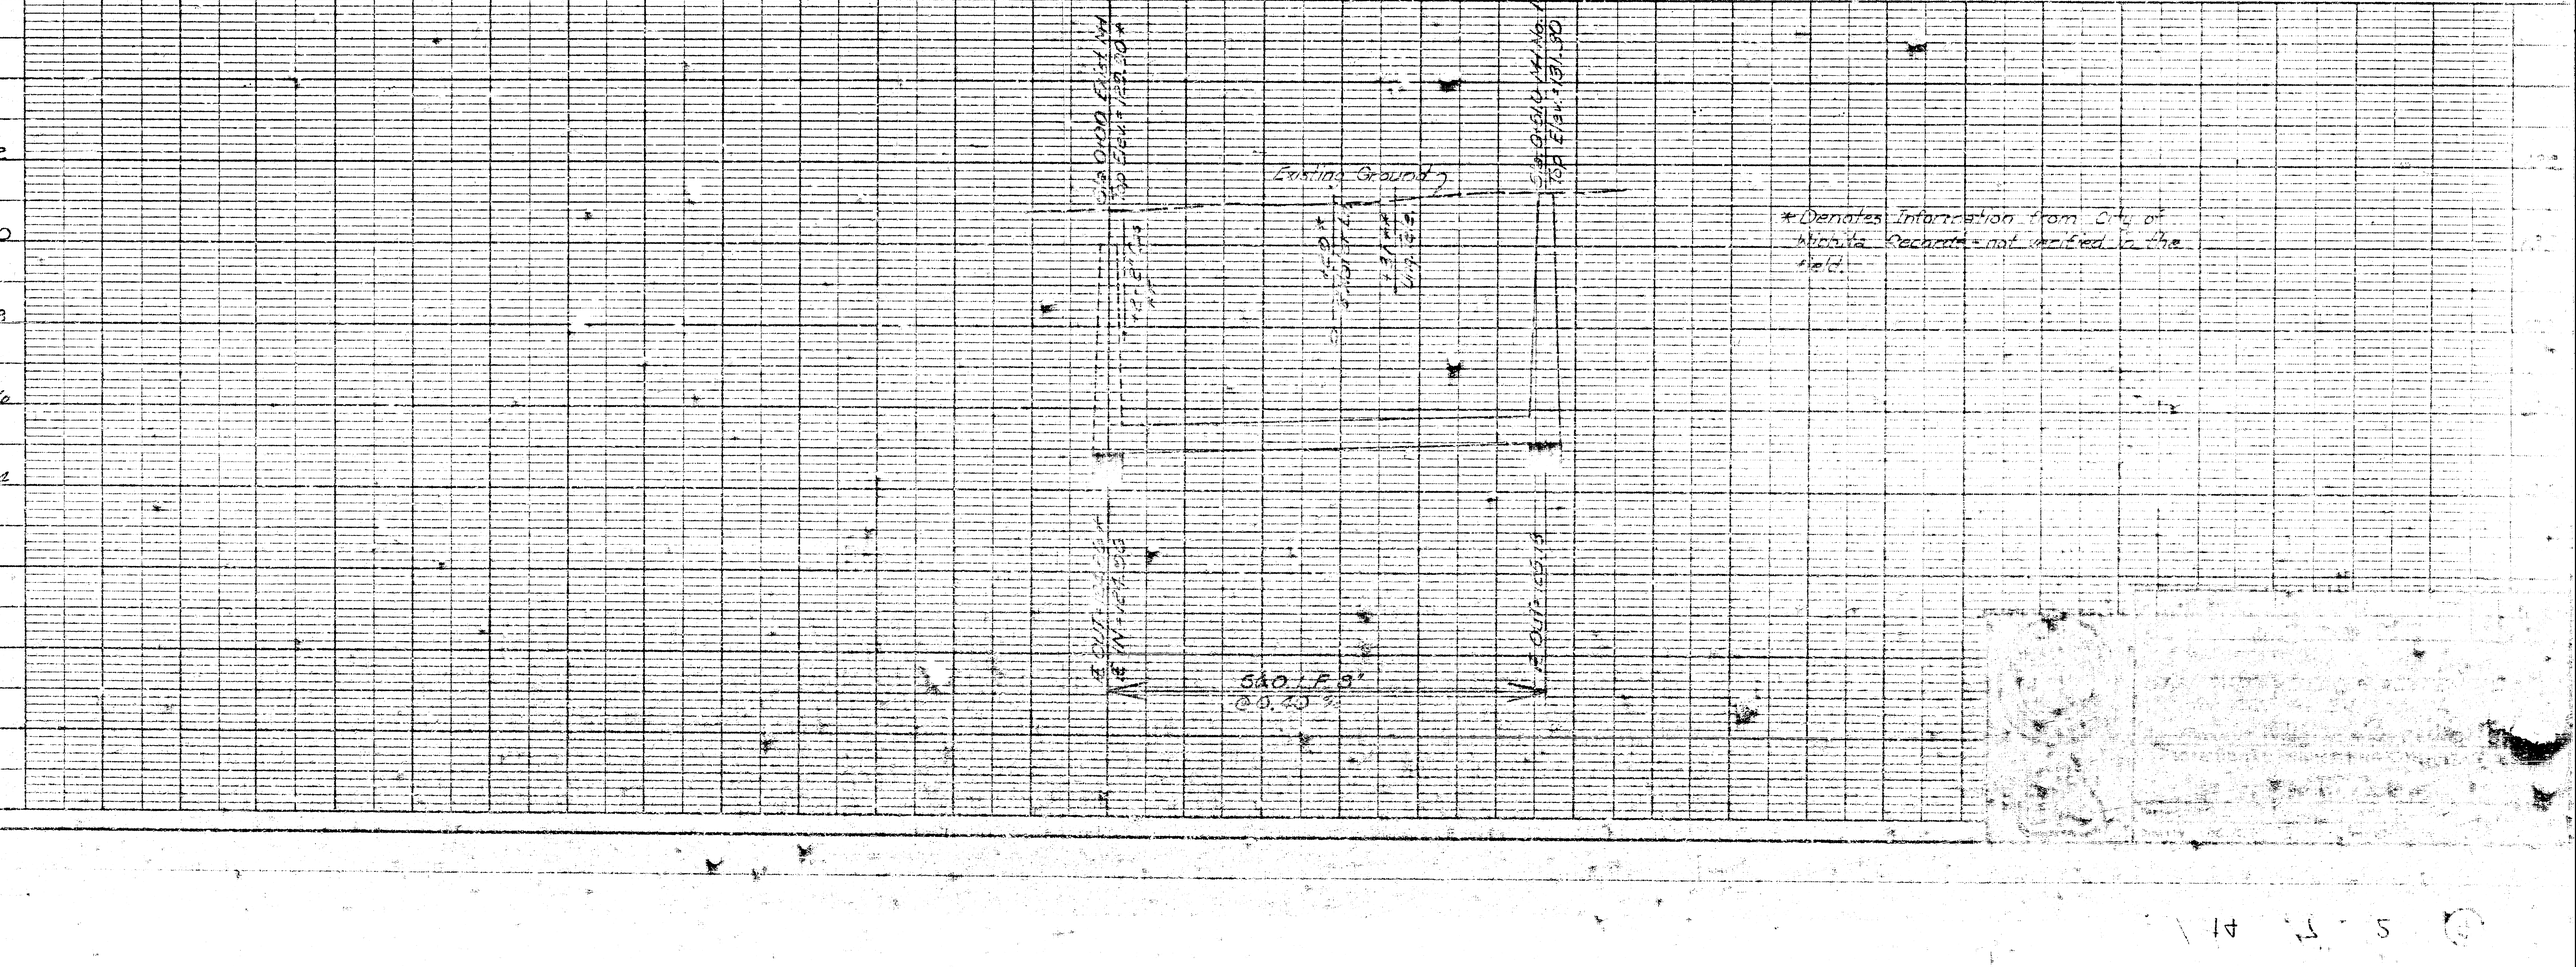

* Denotes Information from City of Wichita Records not verified in the field.