


Easement Grading Cross-Section

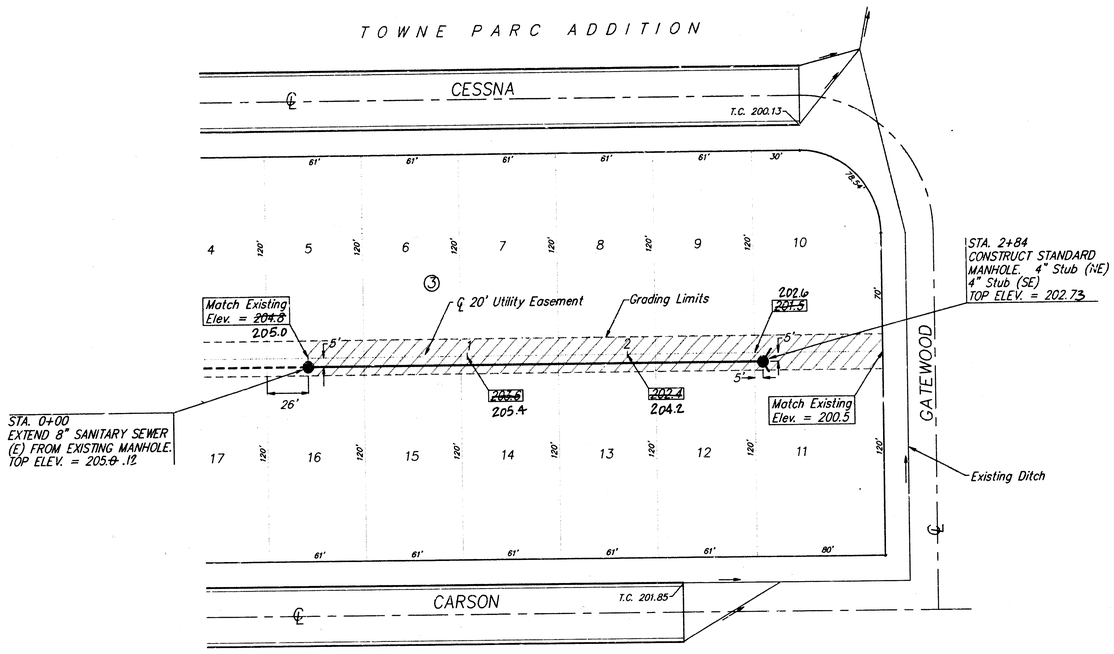

SCALE: 1" = 40' Horizontal
1" = 5' Vertical
• = Iron

APPROVED AS NOTED
BY CITY ENGINEER OF WICHITA

Sanitary Sewers VRH 1/7/92

Storm Sewers _____

Driveway Approaches _____

Water Mains _____


Paving _____

NOTE TO CONTRACTORS

Inspection and testing for this project is to be provided by a Licensed Consulting Engineering Firm under contract with the Owner/Developer. Said inspection to be in accordance with the City of Wichita standard construction engineering practices and certified by a Licensed Professional Engineer. No work shall be performed in dedicated easements or public right-of-way by the Contractor without such inspection nor shall any work be commenced without written authorization by the City Engineer.

BENCH MARKS: Standard City Disk 2 feet east and 48 feet south of the N.W. Corner, N.E. Quarter, Section 5-8-2E Elevation = 192.20 City Datum.

'a' Cut top of curb on the south side of Carson and west R/W of Linden. Elevation = 201.71 City Datum.

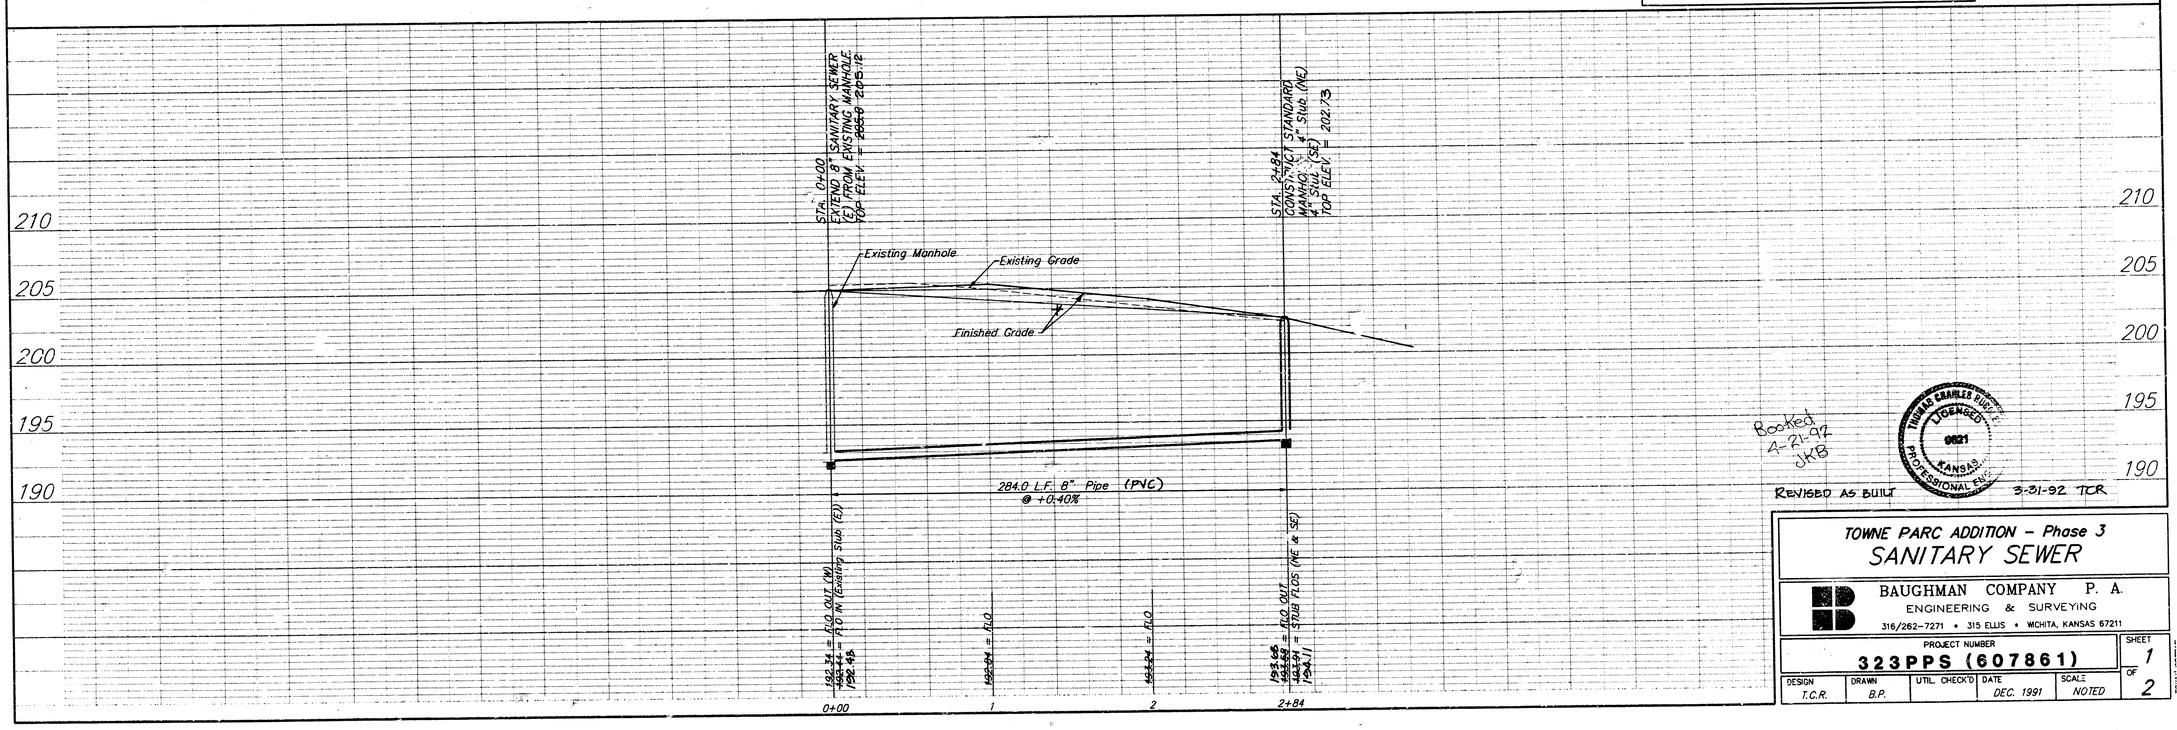

Booked 4-21-92 JKB

REVISED AS BUILT 3-31-92 TCR


TOWNE PARC ADDITION - Phase 3
SANITARY SEWER

BAUGHMAN COMPANY P. A.
ENGINEERING & SURVEYING
316/262-7271 • 315 ELLIS • WICHITA, KANSAS 67211

PROJECT NUMBER				SHEET
323PPS (607861)				1 OF 2
DESIGN	DRAWN	UTIL. CHECK'D	DATE	SCALE
T.C.R.	B.P.		DEC. 1991	NOTED