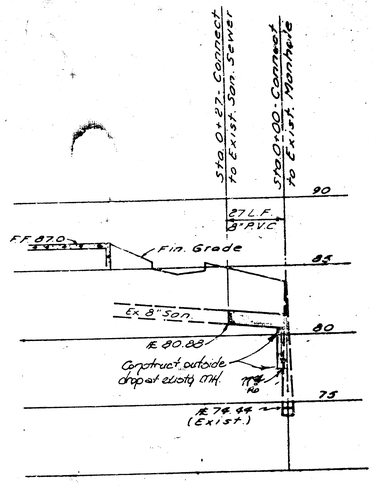


SANITARY SEWER PROFILE

GENERAL NOTES

Construction within 5' of the building shall be in compliance with the City Plumbing Code and will be inspected by Central Inspection.


Televising and air testing will not be required.

APPROVED AS NOTED
By CITY ENGINEER OF WICHITA
Sanitary Sewers 4/22/85
Storm Sewers
Driveway Approaches

NOTE TO CONTRACTOR:

This project will be constructed under the supervision of the CITY ENGINEER and conforming to the SPECIFICATIONS of the CITY OF WICHITA. The CONTRACTOR will pay the City of Wichita for all costs of plan review, inspection and booking per contract.

47th STREET SOUTH

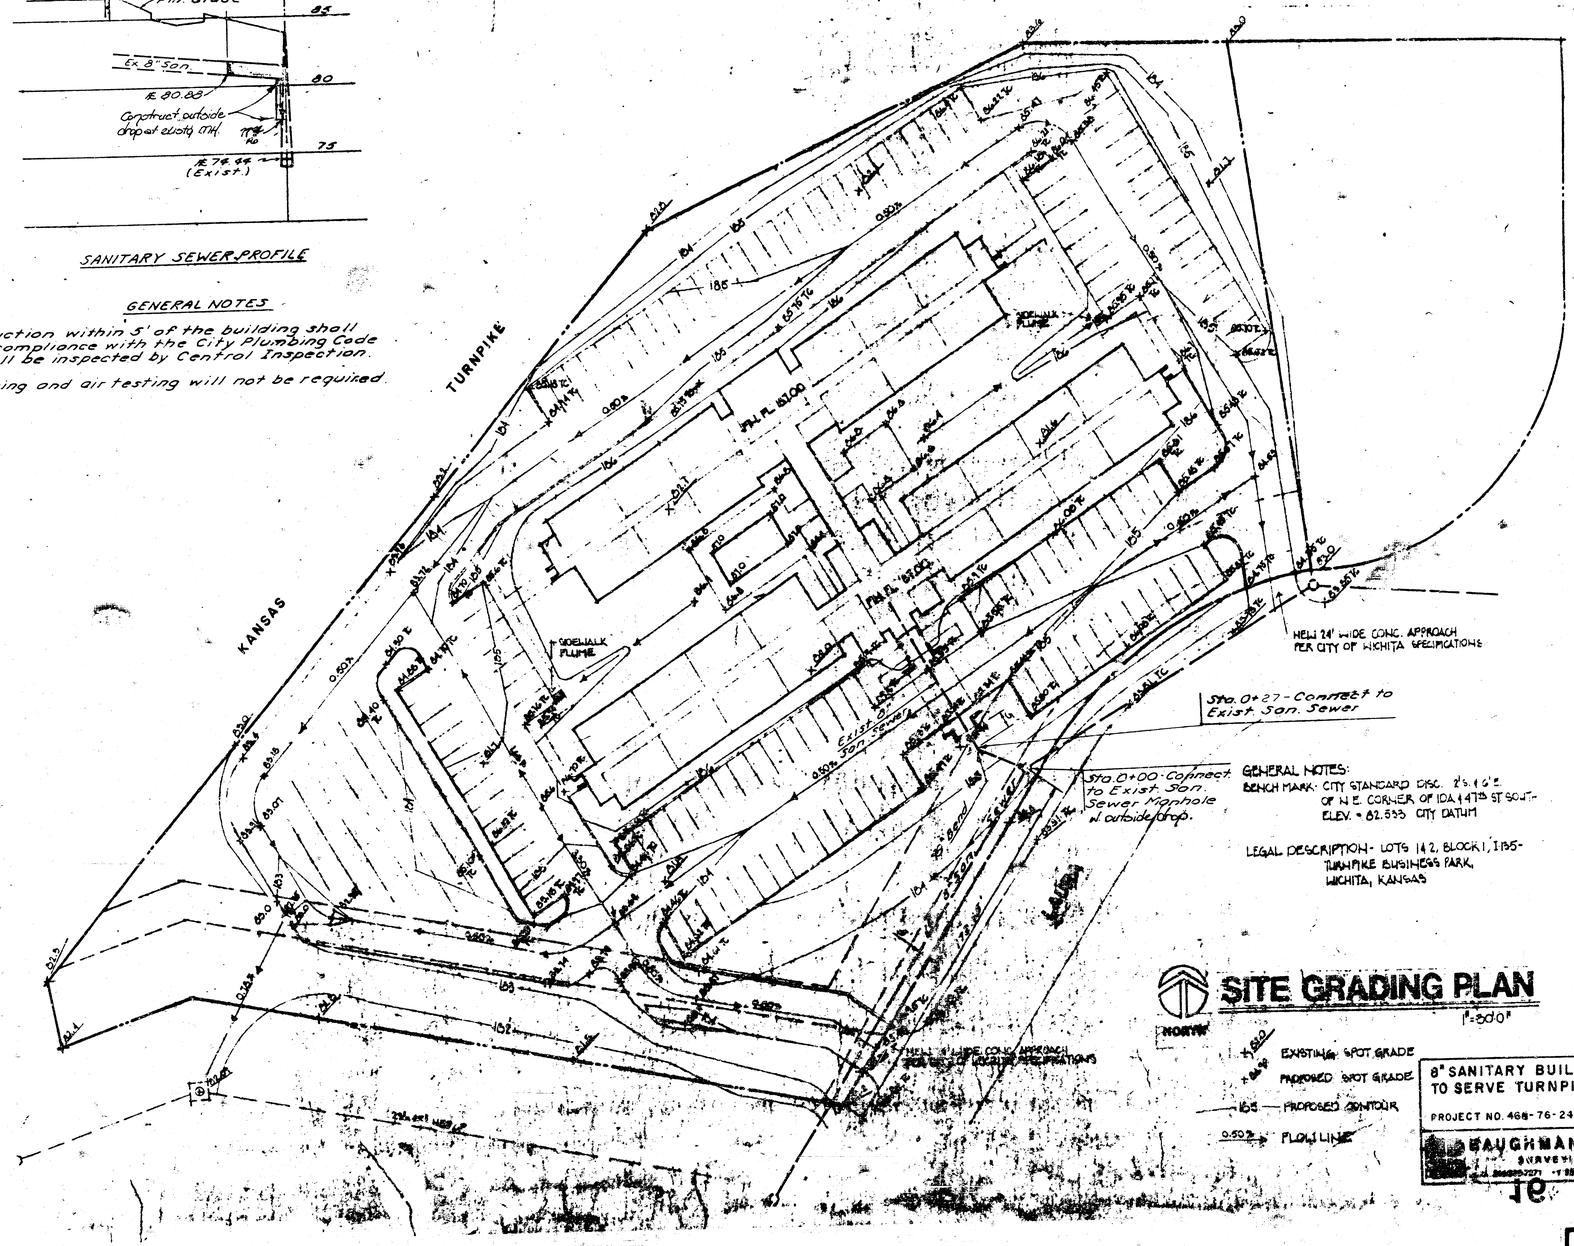

GENERAL NOTES:
BENCH MARK: CITY STANDARD DISC. 2'S, 1 6'E OF N.E. CORNER OF IDA & 47TH ST SOUTH ELEV. = 82.595 CITY DATUM

LEGAL DESCRIPTION - LOTS 1 & 2, BLOCK 1, TURNPIKE BUSINESS PARK, WICHITA, KANSAS

SITE GRADING PLAN

1"=30'-0"

NORTH

X 850 EXISTING SPOT GRADE
X 84.50 PROPOSED SPOT GRADE
155 PROPOSED CONTOUR
0.50% FLOW LINE

8" SANITARY BUILDING SERVICE LINE TO SERVE TURNPIKE INN

PROJECT NO. 468-76-245-80001-000-000-016

VAUGHAN COMPANY, P.A.
SURVEYING & ENGINEERING
[illegible] WICHITA, KANSAS 67211

N. BRENT WOOTEN LICENSED 8470 KANSAS PROFESSIONAL ENGINEER

OIL LEASE REVIEW 10 25 5
PERMIT 1-9-85
TO BID 1-25-85

revisions
4-29-85 - Rev. Sewer

date drawn

JEFF KRUISEL ASSOCIATES, inc.
architecture planning
1300 east lewis wichita, kansas 67211
(316) 267-9123

TURNPIKE INN
47th STREET SOUTH and LAURA
WICHITA, KANSAS

sheet title: SITE GRADING PLAN

sheet SG-1 of 1 1/1 sheets

FILMED FROM THE BEST AVAILABLE COPY