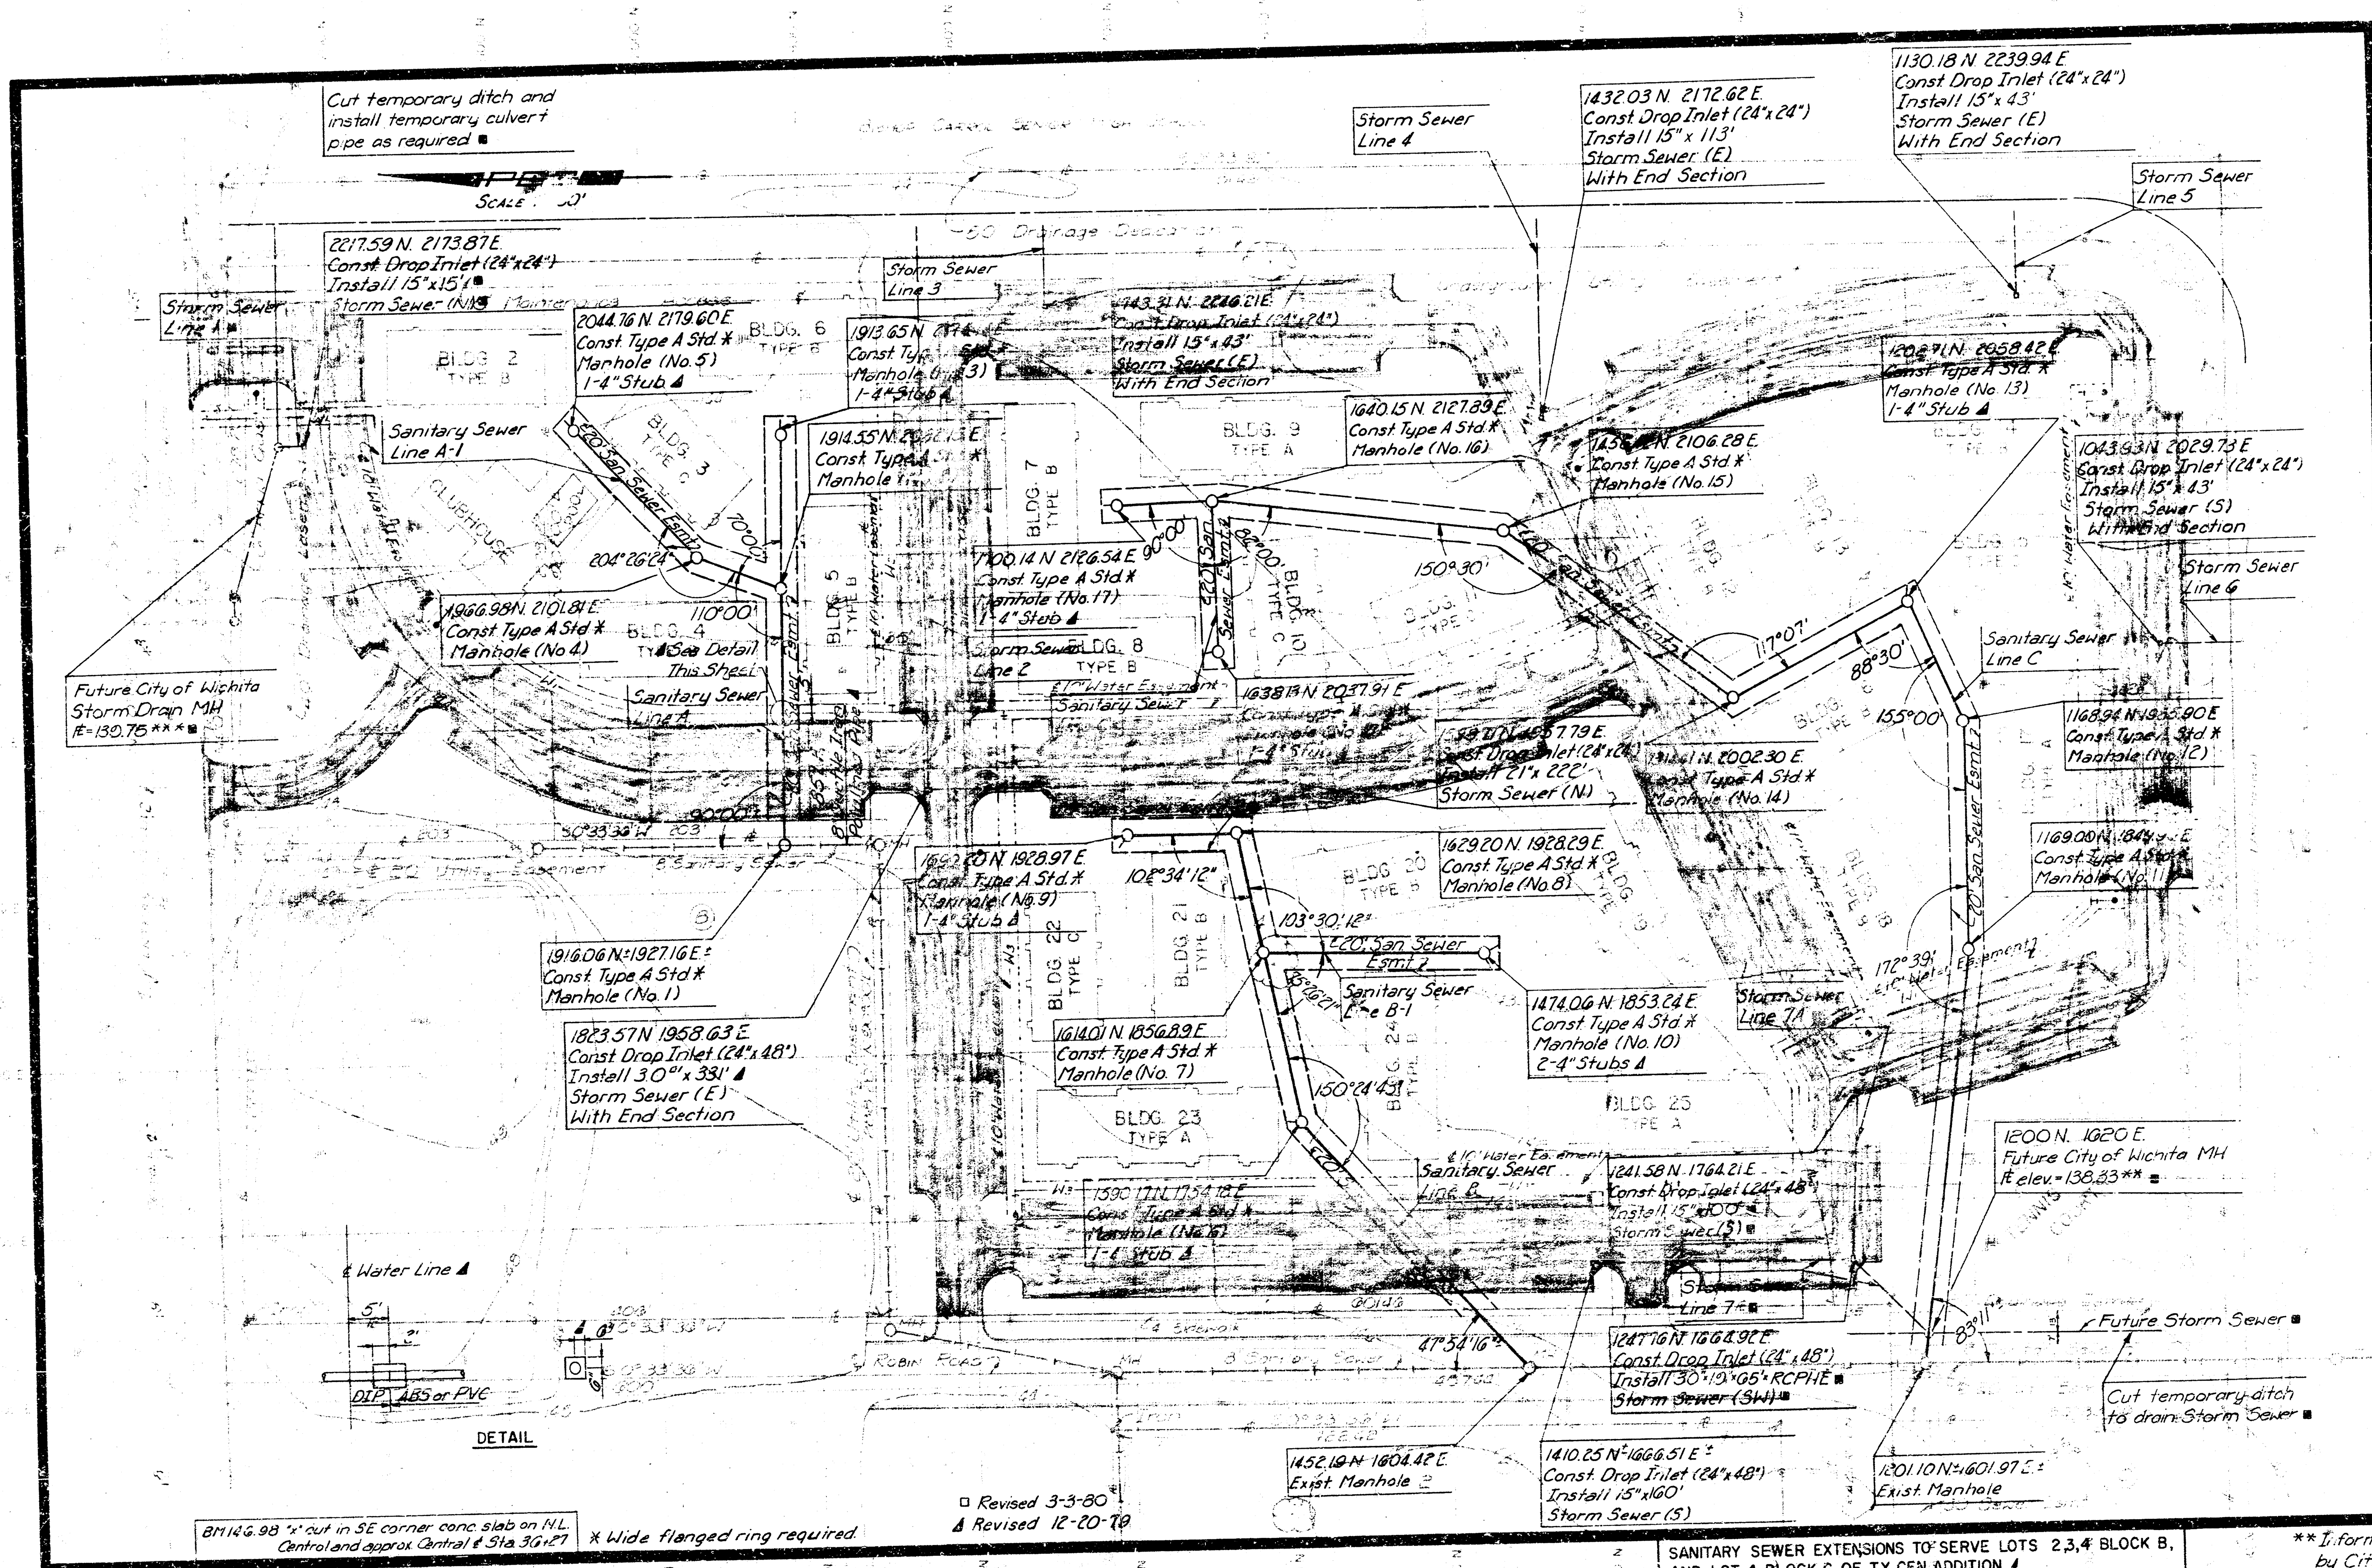


SANITARY SEWER EXTENSIONS TO SERVE LOTS 2,3,4 BLOCK B, AND LOT 4 BLOCK C OF TY CEN ADDITION. ▲

** Information provided by City of Wichita ■

*** Information provided by consultant designing Storm Drain for City of Wichita ■

12-21-79

J. E. S.

MICHAEL D. SCHOMAKER LICENSED 6779 KANSAS PROFESSIONAL ENGINEER

CITY OF WICHITA PROJECT NO. 468-76-245-80889-000-000-008 ▲


PROFESSIONAL ENGINEERING CONSULTANTS, P.A.


ENGINEERS

WICHITA, KANSAS

Designed by	Job No.	Sht. of
Drawn by	Date	

S-8 1/6

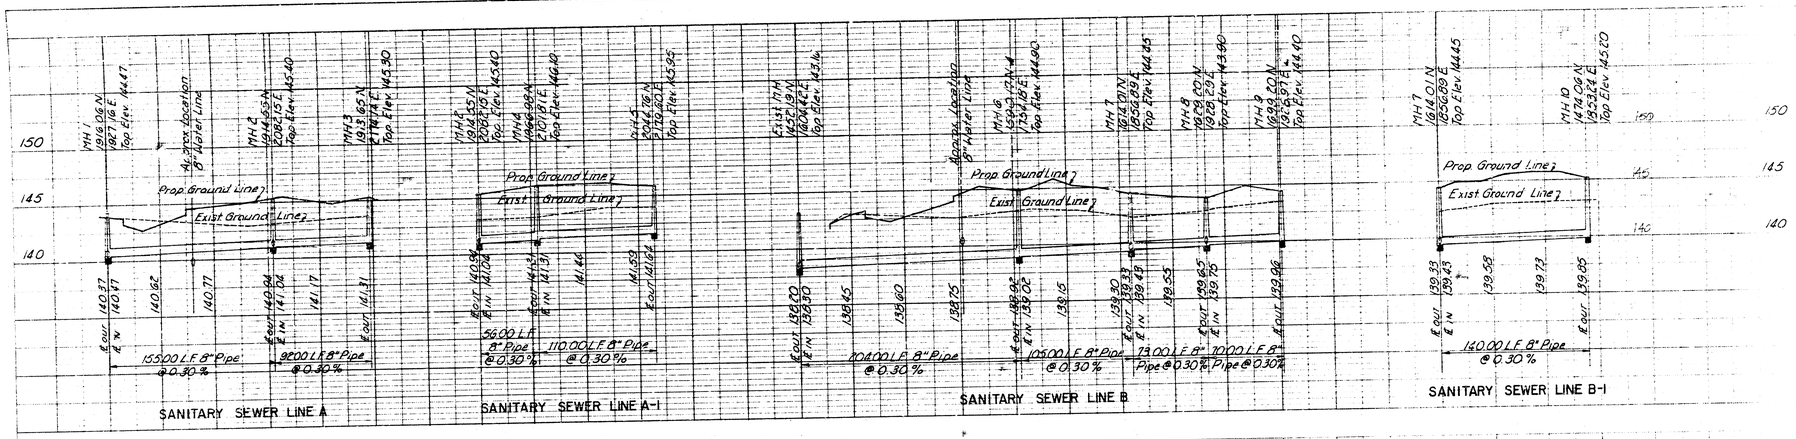

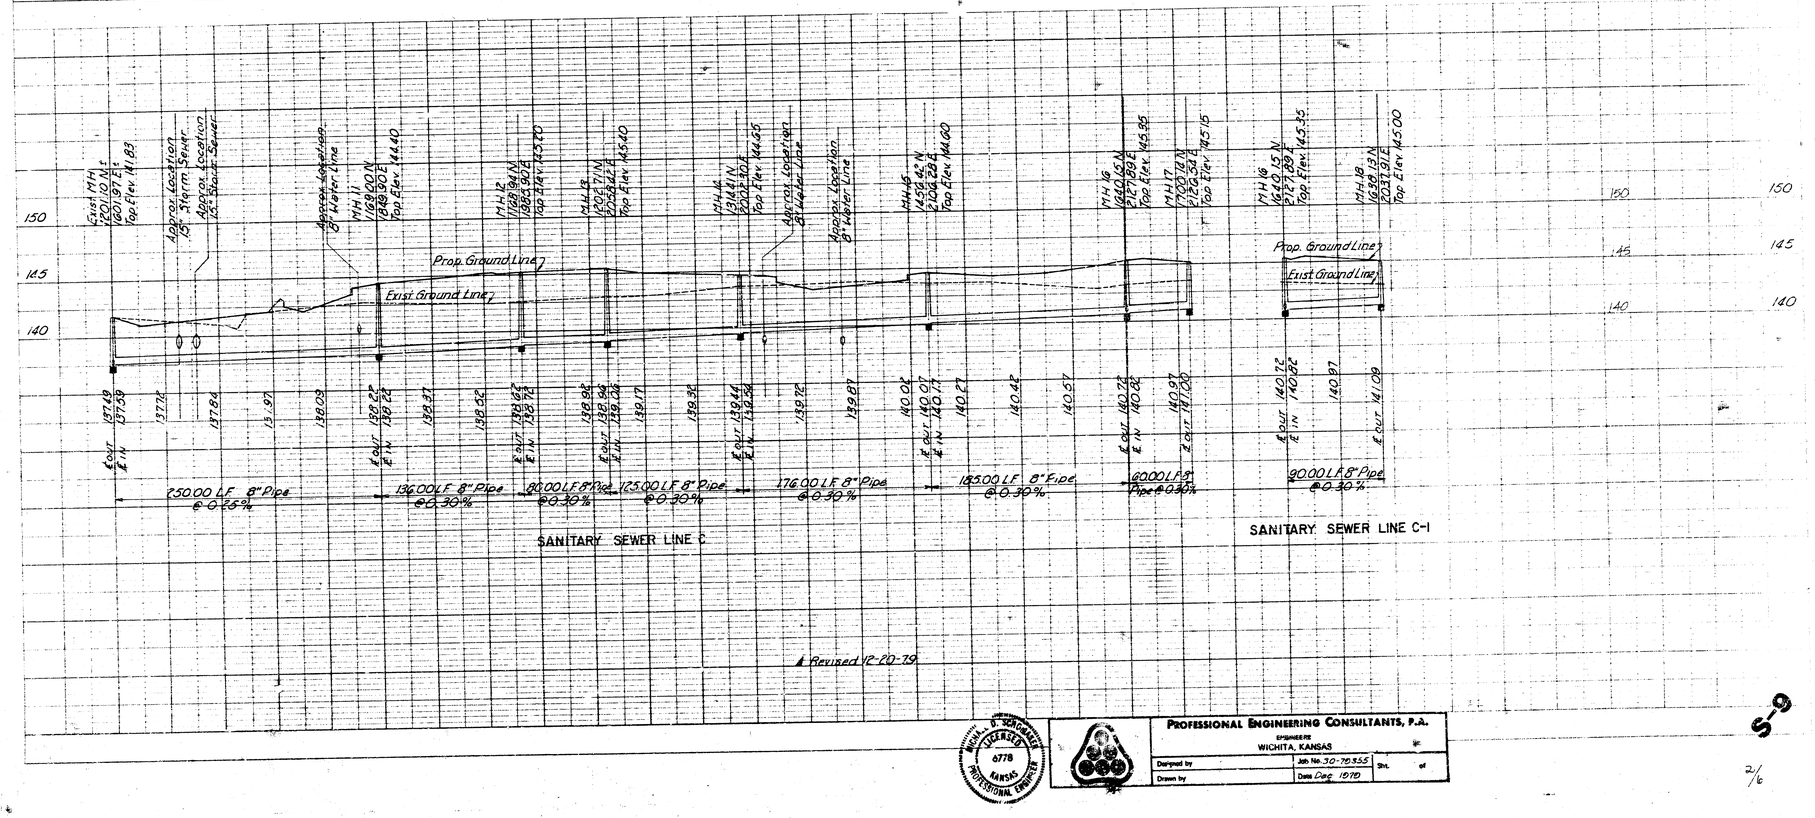

Revised 12-20-79

MICHAEL D. SCHUMACHER
LICENSED
6778
KANSAS
PROFESSIONAL ENGINEER


PROFESSIONAL ENGINEERING CONSULTANTS, P.A.
ENGINEERS
WICHITA, KANSAS

Designed by
Drawn by
Job No. 30-76.855
Date Dec. 1978
Sht. of

S-9

2/6

FILMED FROM THE BEST AVAILABLE COPY

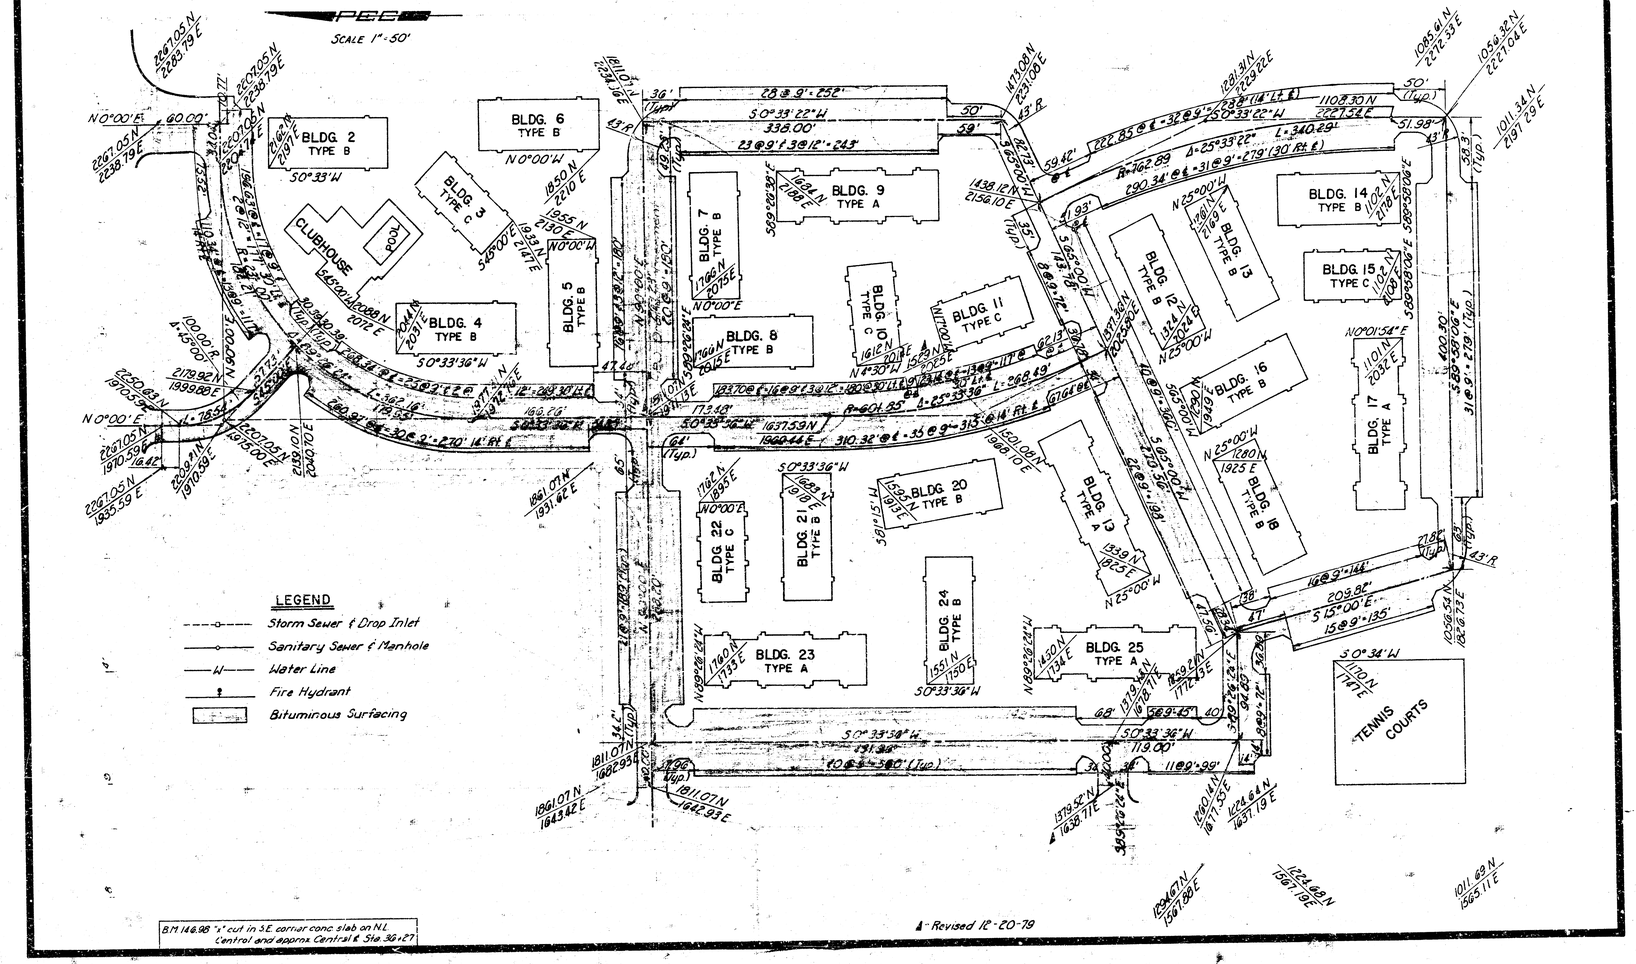


PROFESSIONAL ENGINEERING CONSULTANTS, P.A.
ENGINEERS
WICHITA, KANSAS
Designed by M.D.S. | Job No. 30-78355 | Sht. of
Drawn by R.F.J., G.D.R., D.S.H. | Date Nov. 1979

3/4

S-2

FILMED FROM THE BEST

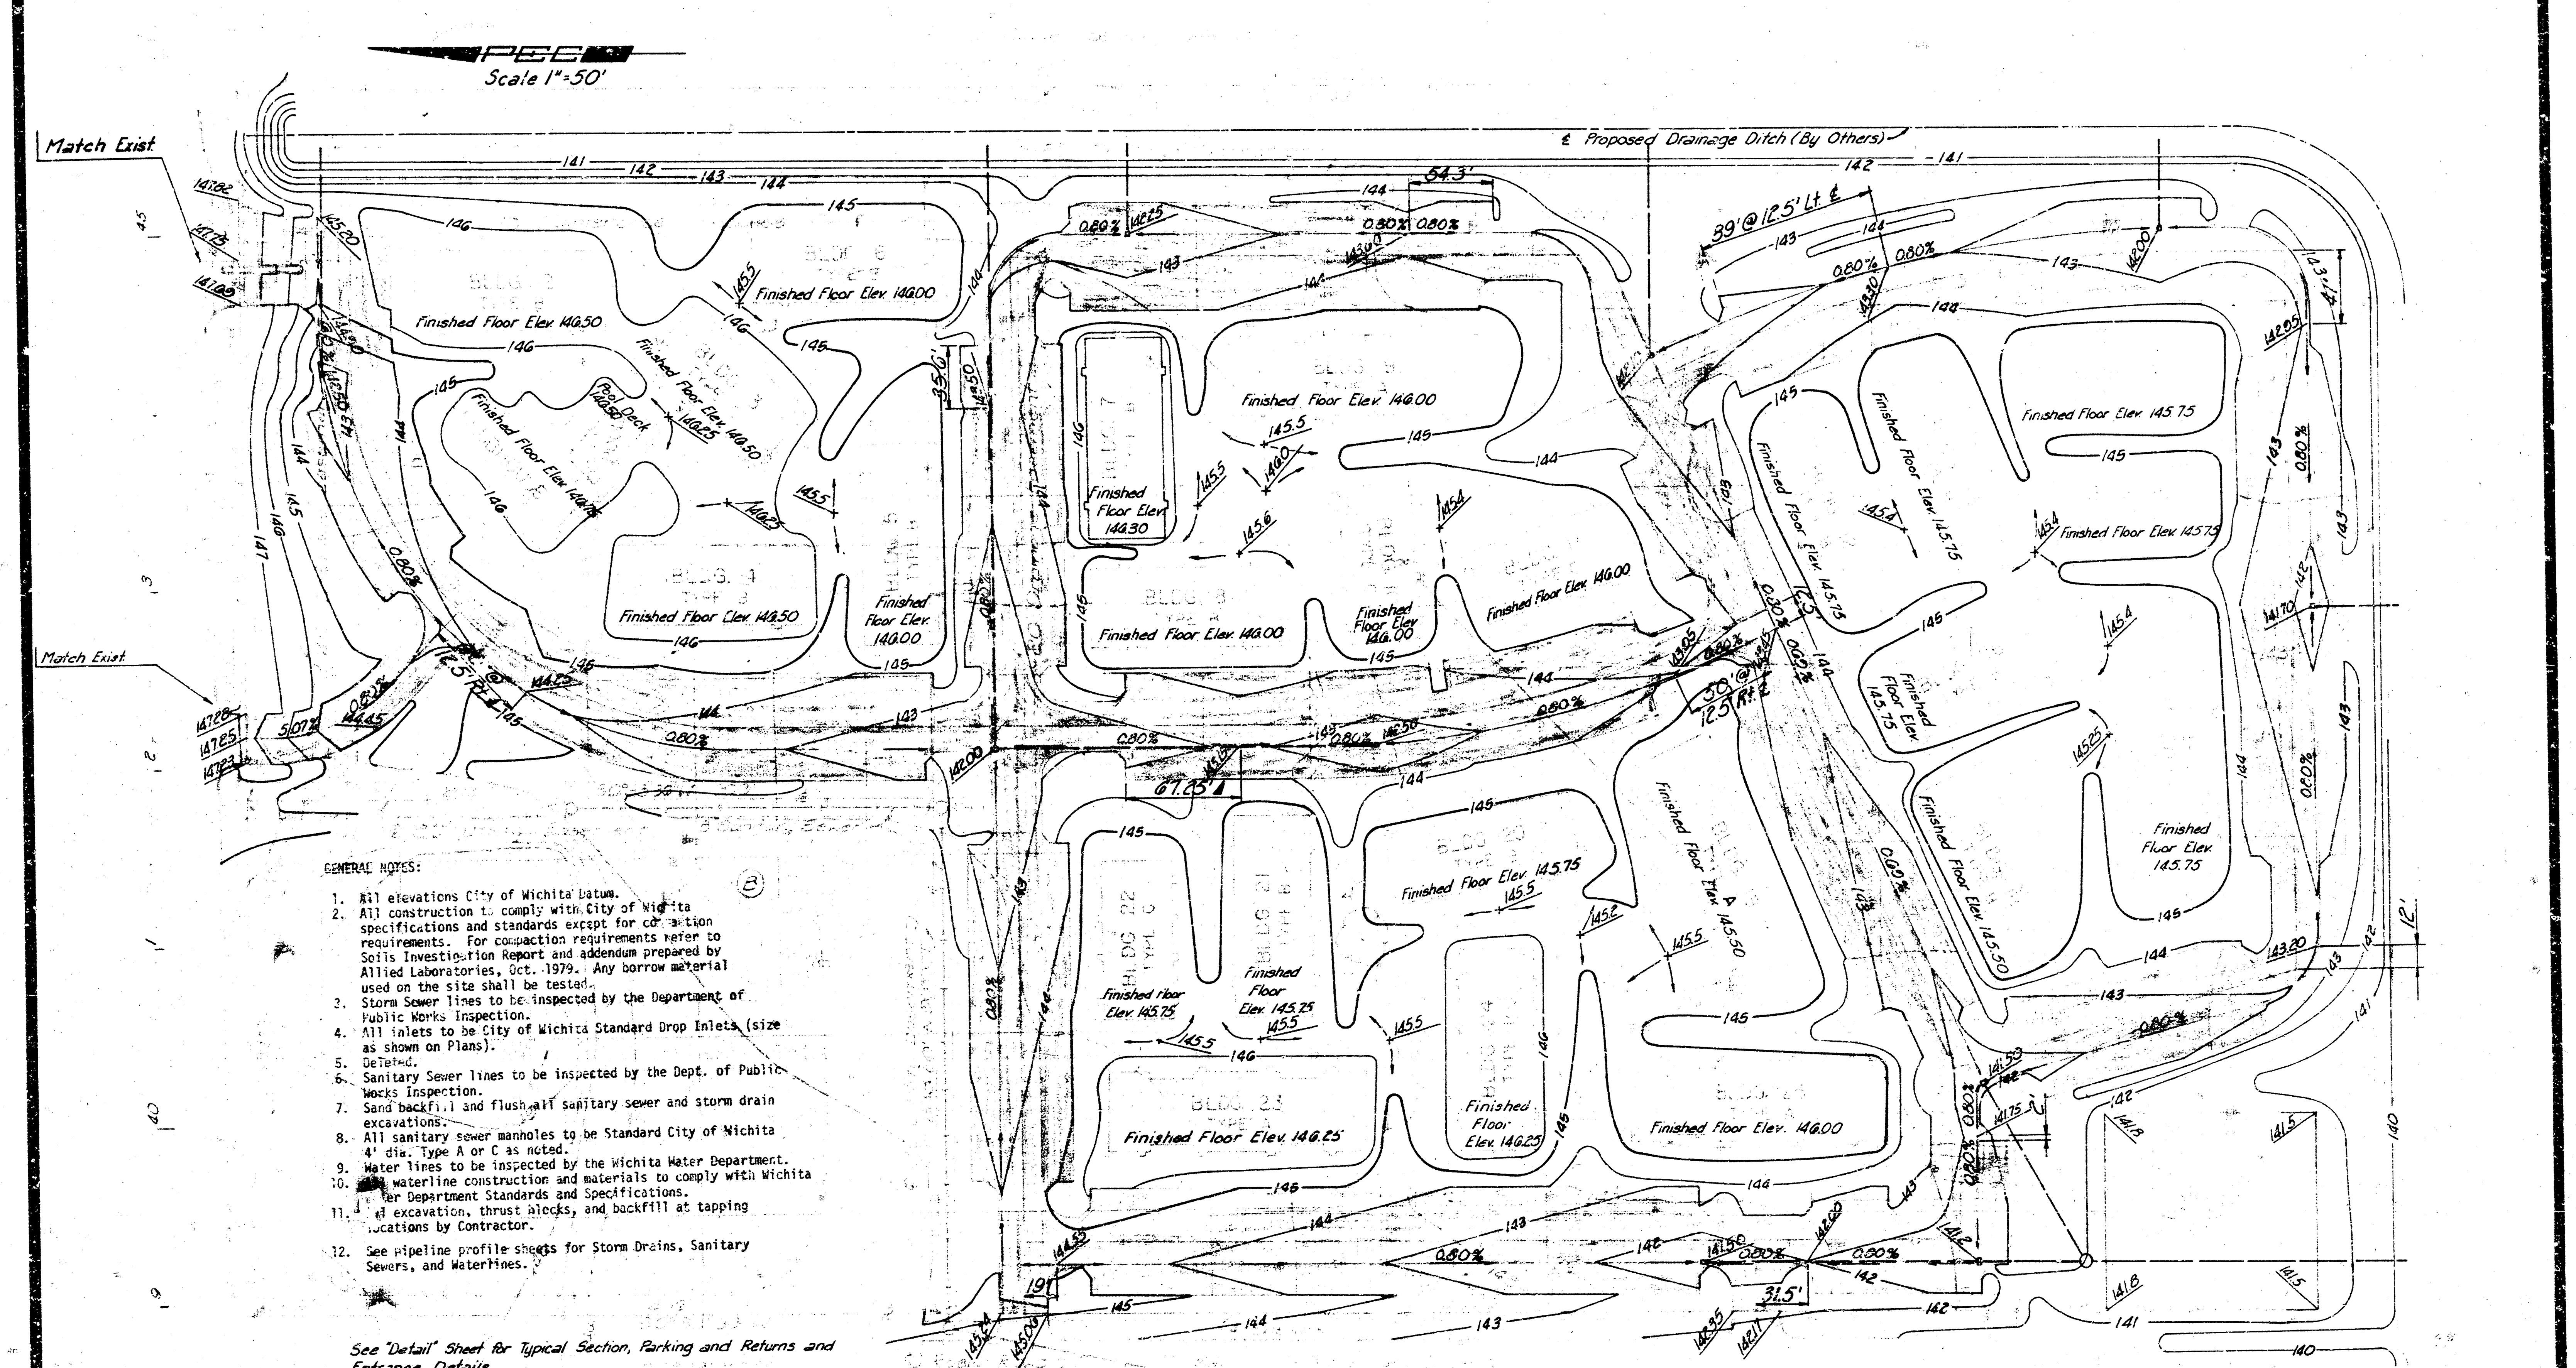

GENERAL NOTES:

1. All elevations City of Wichita Datum.
2. All construction to comply with City of Wichita specifications and standards except for compaction requirements. For compaction requirements refer to Soils Investigation Report and addendum prepared by Allied Laboratories, Oct. 1979. Any borrow material used on the site shall be tested.
3. Storm Sewer lines to be inspected by the Department of Public Works Inspection.
4. All inlets to be City of Wichita Standard Drop Inlets (size as shown on Plans).
5. Deleted.
6. Sanitary Sewer lines to be inspected by the Dept. of Public Works Inspection.
7. Sand backfill and flush all sanitary sewer and storm drain excavations.
8. All sanitary sewer manholes to be Standard City of Wichita 4' dia. Type A or C as noted.
9. Water lines to be inspected by the Wichita Water Department.
10. All waterline construction and materials to comply with Wichita Water Department Standards and Specifications.
11. All excavation, thrust blocks, and backfill at tapping locations by Contractor.
12. See pipeline profile sheets for Storm Drains, Sanitary Sewers, and Waterlines.

See "Detail" Sheet for Typical Section, Parking and Returns and Entrance Details
For Inlet Coordinates see Storm Sewer Sheet

B.M. 146.98 "x" cut in S.E corner conc. slab on N.L. Central and approx. Central ℄ Sta. 36+27

▲ - Revised 12-20-79


MICHAEL D. SCHOMAKER LICENSED 6778 KANSAS PROFESSIONAL ENGINEER

PROFESSIONAL ENGINEERING CONSULTANTS, P.A.
ENGINEERS
WICHITA, KANSAS

Designed by MDS	Job No. 30-79385	Sht.
Drawn by RFJ, DJM & GDR	Date Nov. 1979	


4/6


S-3

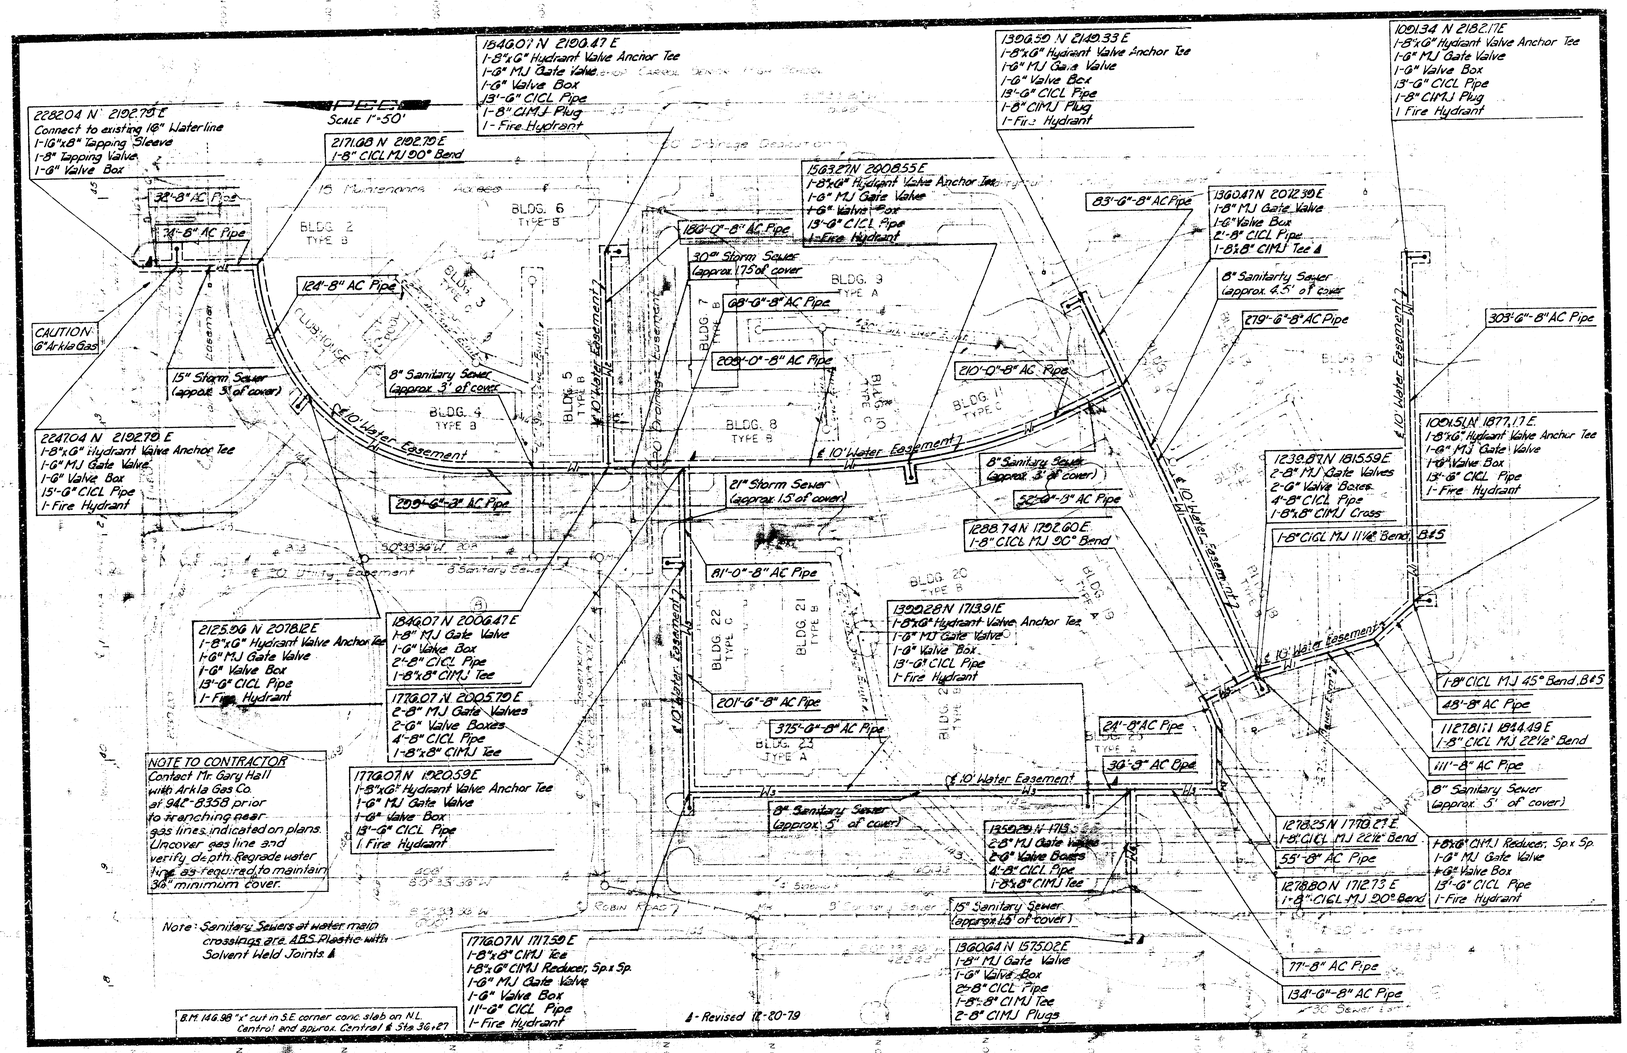

S-4
5/6

FILMED FROM THE BEST

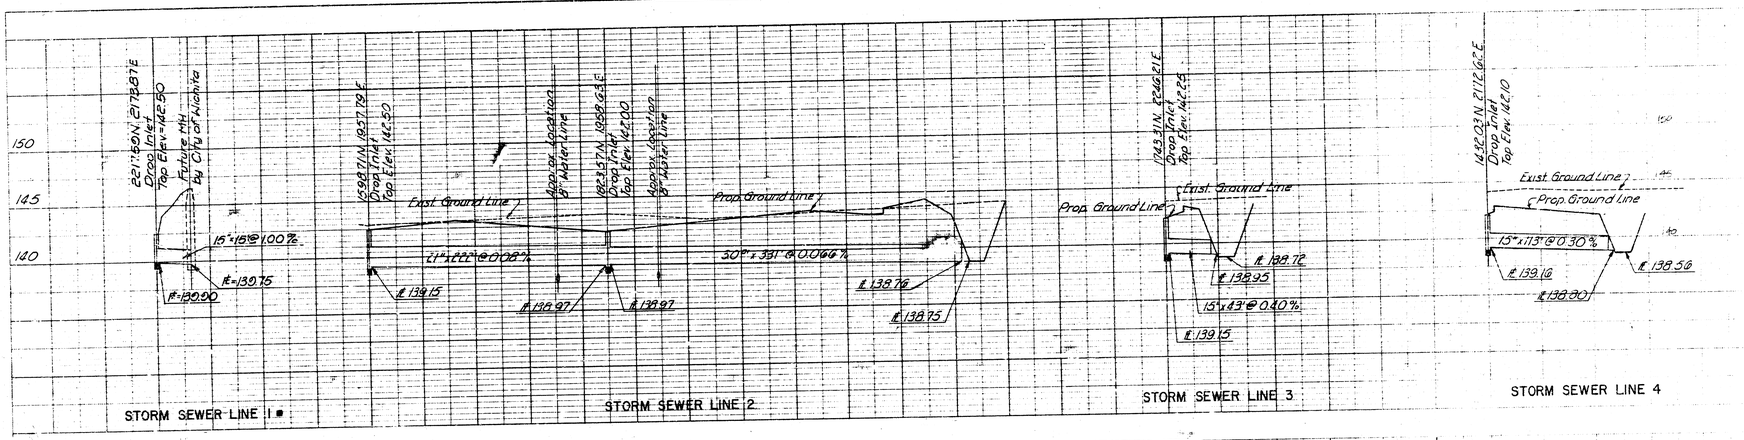

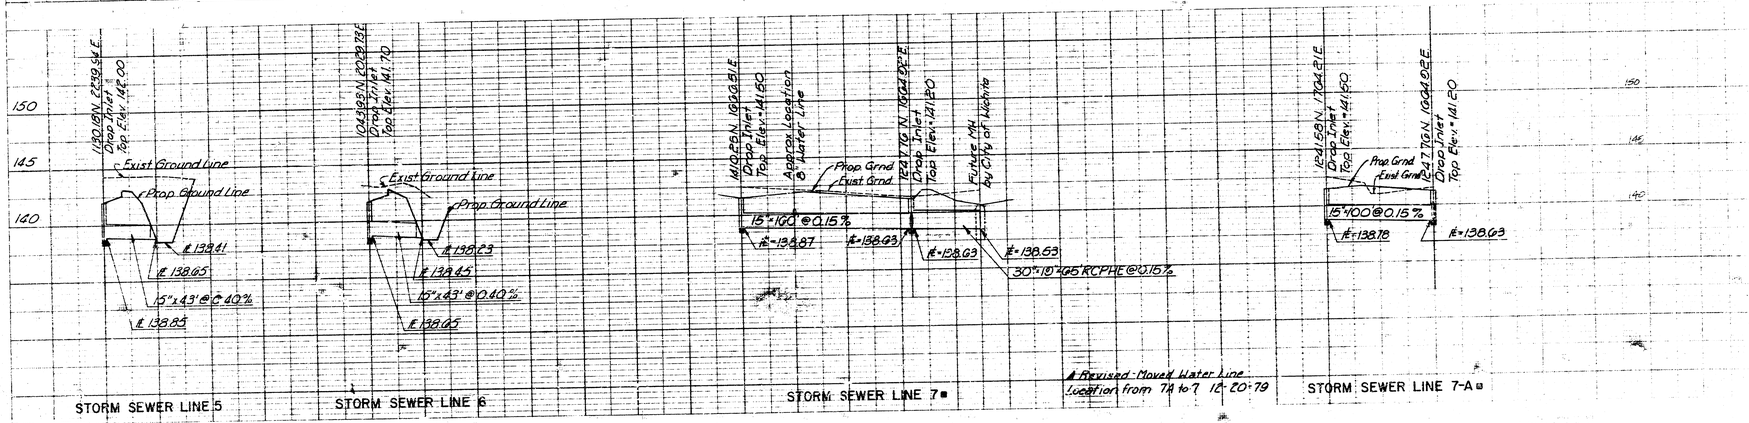

PROFESSIONAL ENGINEERING CONSULTANTS, P.A.
ENGINEERS
WICHITA, KANSAS

Designed by | Job No. | Sh. | of
Drawn by | Date

S-10

FILMED FROM THE BEST AVAILABLE COPY....