


1-27-76


APPROVED AS NOTED
By CITY ENGINEER OF WICHITA
Sanitary Sewers O.E.S.
Storm Sewers
Driveway Approaches

Sanitary Sewer U.S. Postal Facility on West Harry
Proj. No. 08KW705062

Inset #1

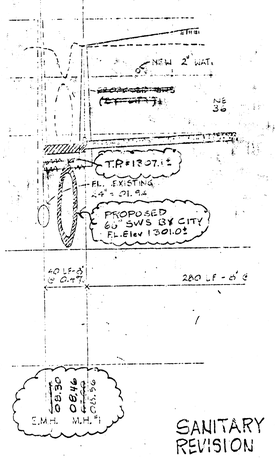

SANITARY SEWER
REVISION Sh. # SU-2
RDF 1-16-75

 

Flow Elev. are sea level datums

SANITARY SEWER PROFILES



MANHOLE SCHEDULE

REVISIONS

NUMBER	DESCRIPTION	DATE APPROVED