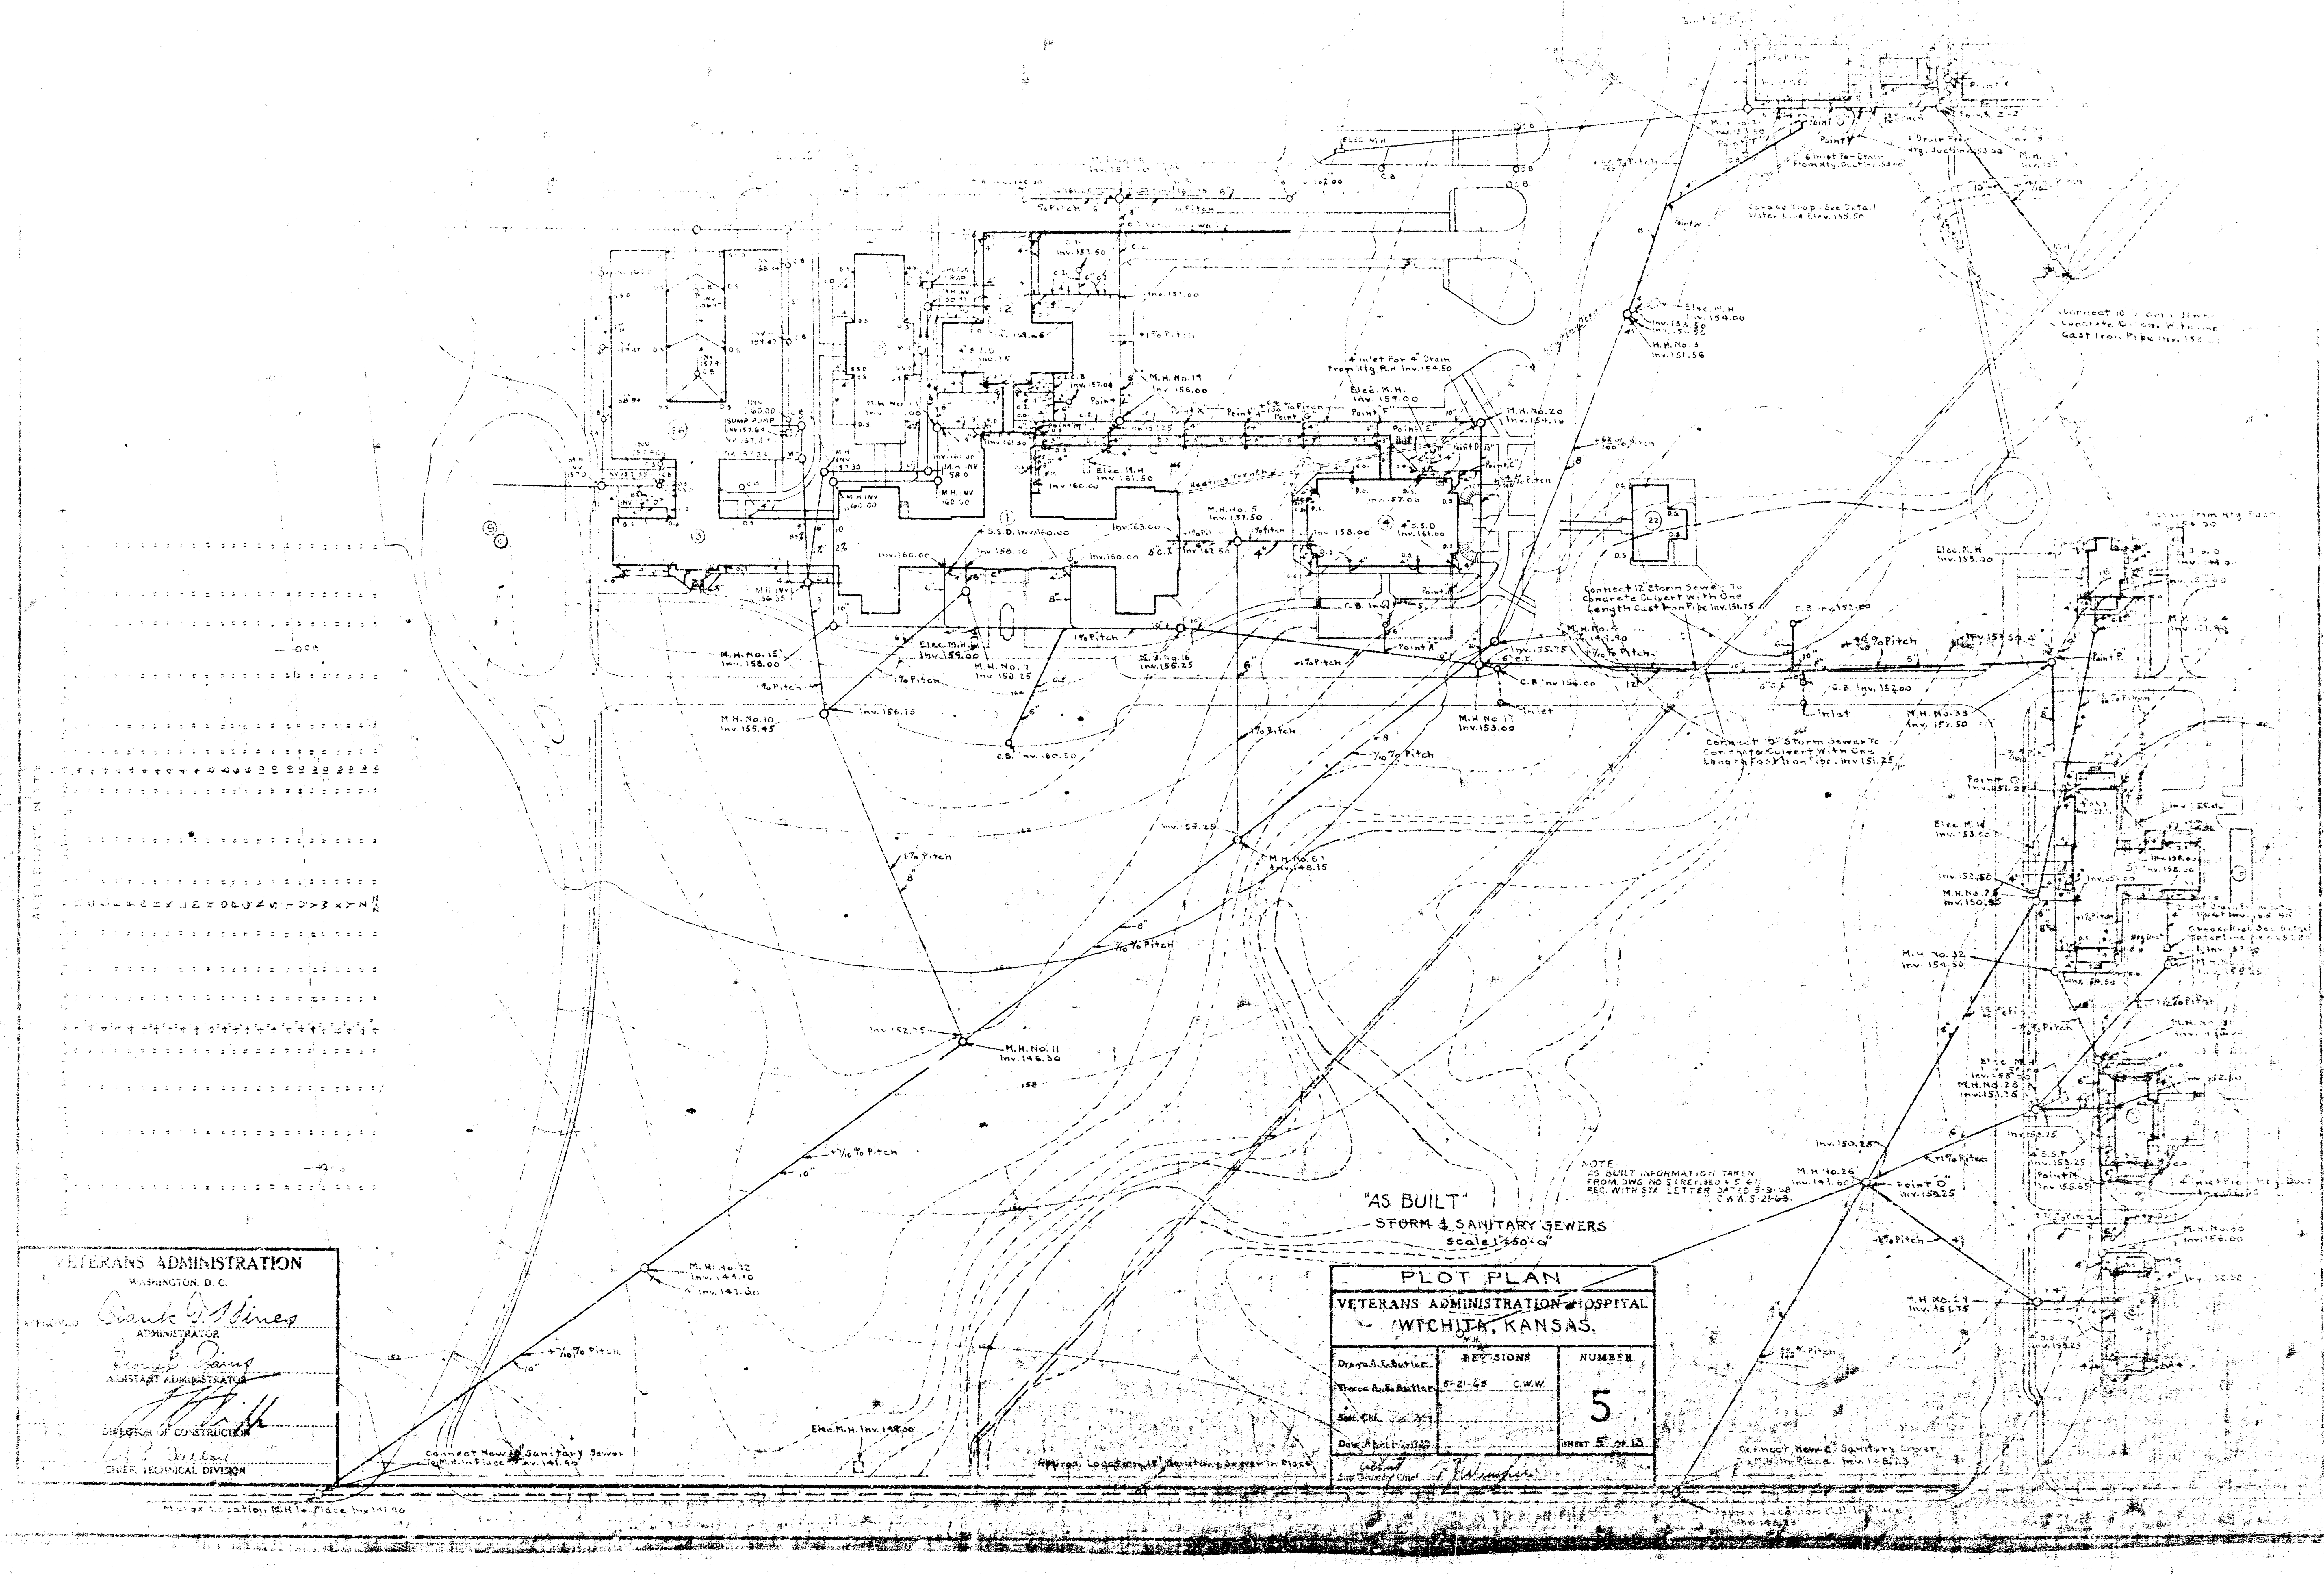

"AS BUILT"
STORM & SANITARY SEWERS
Scale 1"=50'-0"
PLOT PLAN
VETERANS ADMINISTRATION HOSPITAL
WICHITA, KANSAS.
Drawn A. E. Butler
Traced A. E. Butler
REVISIONS
5-21-65 C.W.W.
NUMBER
5
SHEET 5 OF 13
VETERANS ADMINISTRATION
WASHINGTON, D. C.
APPROVED
ADMINISTRATOR
ASSISTANT ADMINISTRATOR
DIRECTOR OF CONSTRUCTION
CHIEF, TECHNICAL DIVISION
NOTE:
AS BUILT INFORMATION TAKEN FROM DWG. NO. 5 (REVISED 4-5-61) REC. WITH STA. LETTER DATED 5-3-65
C.W.W. 5-21-65
M.H. No. 11
Inv. 146.30
M.H. No. 6
Inv. 148.15
M.H. No. 10
Inv. 155.45
M.H. No. 17
Inv. 153.00
M.H. No. 26
Point "O"
Inv. 152.25
M.H. No. 33
Inv. 152.50
M.H. No. 32
Inv. 154.50
Connect 12" Storm Sewer To Concrete Culvert With One Length Cast Iron Pipe Inv. 151.75
Connect 10" Storm Sewer To Concrete Culvert With One Length Cast Iron Pipe Inv. 151.75
Elec. M.H. Inv. 149.00

Hard And Soft Water May Be Installed In Same Trench

4" Gas

Hard & Gas Lines To Be Laid Below Heating Trenches

Heating Trench

8" Hard Water
3" Soft Water

Valve B/L
Check Valve
Gate Valve

4" Gas

Regulator

F.H. No. 2

F.H. No. 1

F.H. No. 4

F.H. No. 3

6" Hard Water

Hard And Soft Water May Be Installed In Same Trench

F.H. No. 5

F.H. No. 11

F.H. No. 12

6" Capped Outlet

8" Hard Water

Meter And Meter Pit Furnished And Installed By Water Co.

Connect 8" Hard Water To 8" City Water At Curb

8" Water Main Installed By Water Co.

NOTE
AS BUILT INFORMATION TAKEN FROM DWG. NO. 6 (REVISED 6-6-67) REC. WITH STA. LETTER DATED 8-9-68 C.W.W. 6-3-68.

"AS BUILT"

WATER & GAS

VETERANS ADMINISTRATION
WASHINGTON, D. C.

APPROVED
Grant D. Stines
ADMINISTRATOR

Everett Davis
ASSISTANT ADMINISTRATOR

DIRECTOR OF CONSTRUCTION

CHIEF, TECHNICAL DIVISION

PLOT PLAN
VETERANS ADMINISTRATION HOSPITAL
WICHITA, KANSAS

	REVISIONS	NUMBER
Drawn Ribbler		6
Traced Ribbler		
Sect. Chief		
Date April 7, 1952		Sheet 6 of 13

Sub-Division Chief

FILE FOLDER NO.