


FOR CONSTRUCTION: 11/1/8



LAW/KINGDON, INC.
ARCHITECTS & ENGINEERS

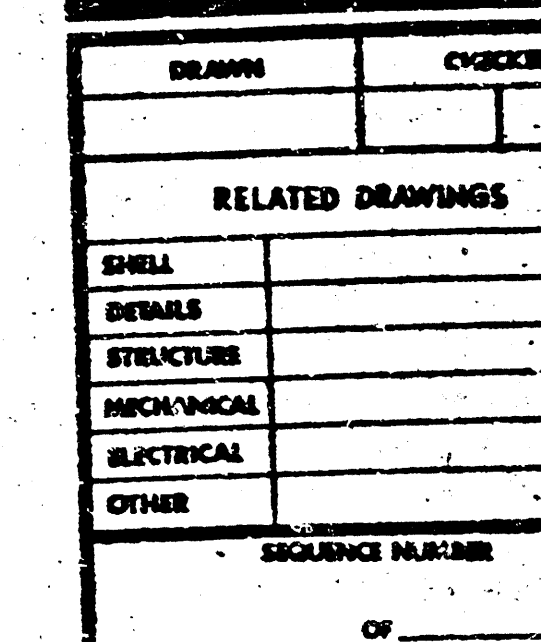


2



SHEET TITLE
SITE UTILITY DET

SHEET NUMBER
SL

OF 2/4

FILMED FROM THE BEST
AVAILABLE COPY


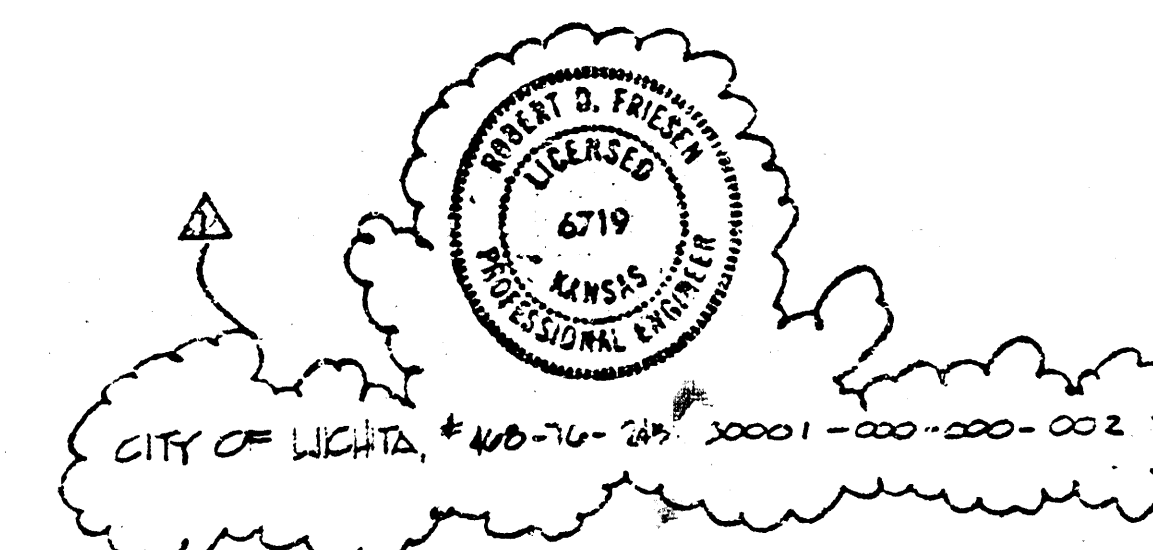


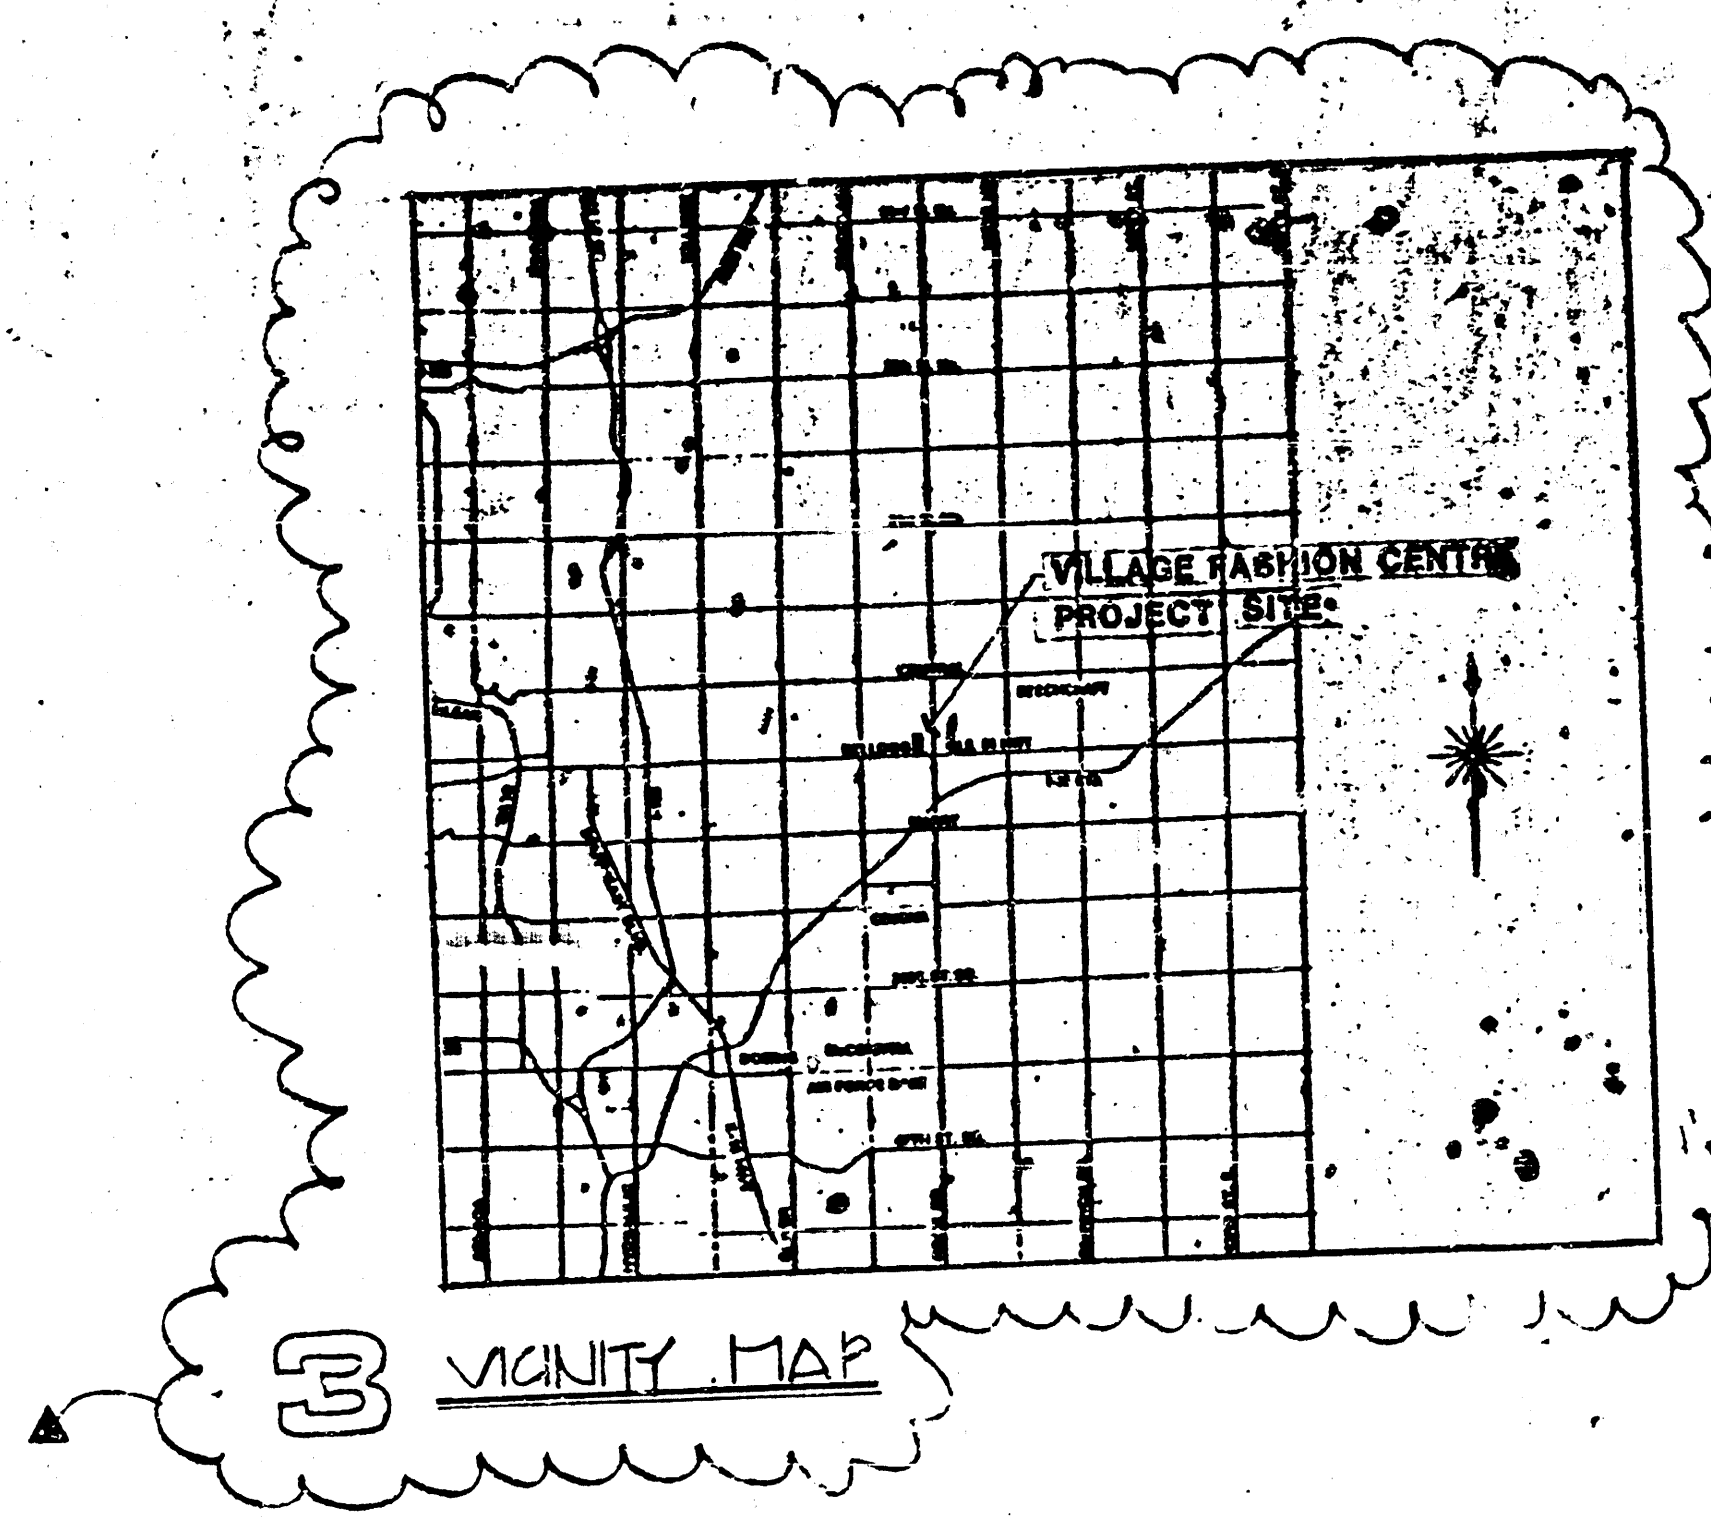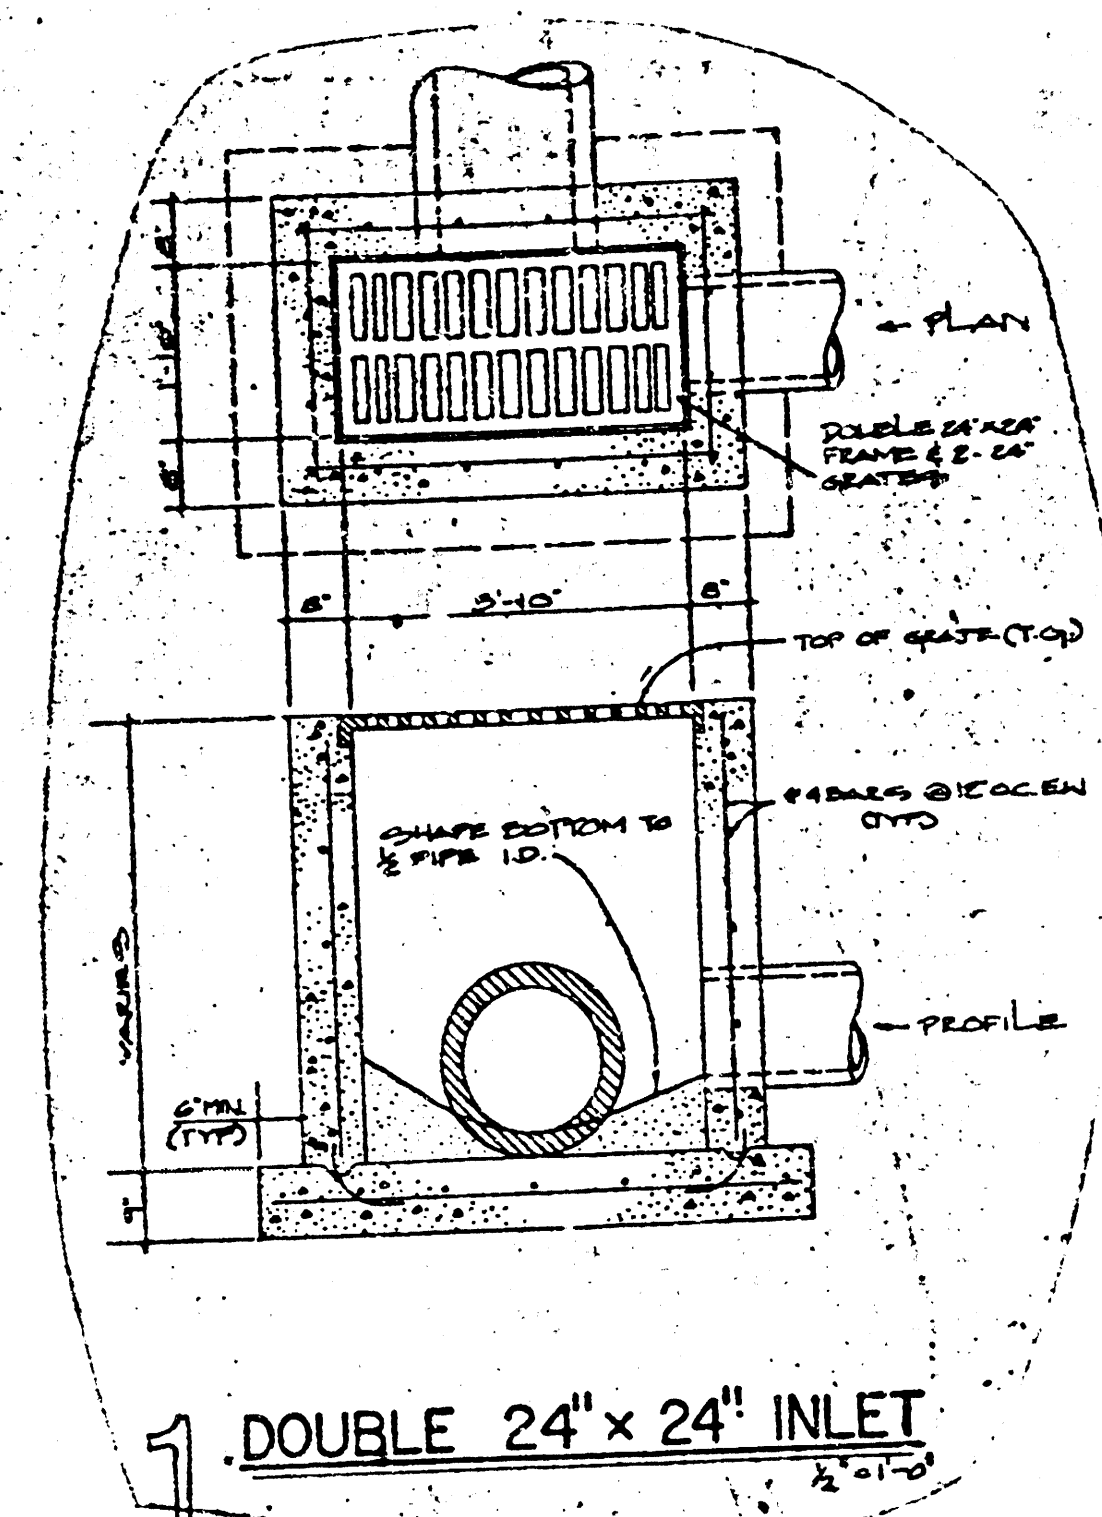


NOTES

- REFER TO SHEET SA-2 FOR EXACT ELEVATIONS OF SIDEWALKS, SERVICE COURTS, COURTYARDS, ETC. ADJACENT TO BUILDINGS.
- REFER TO PLUMBING PLANS FOR CONTINUATION OF COURTYARD DRAINS, ROOF DRAINS, ETC.
- DO NOT ALLOW HEAVY TRUCKS TO CROSS PIPE WITH LESS THAN 12" COVER. DAMAGED PIPE WILL NEED TO BE REMOVED AND REPLACED PRIOR TO PAVING.

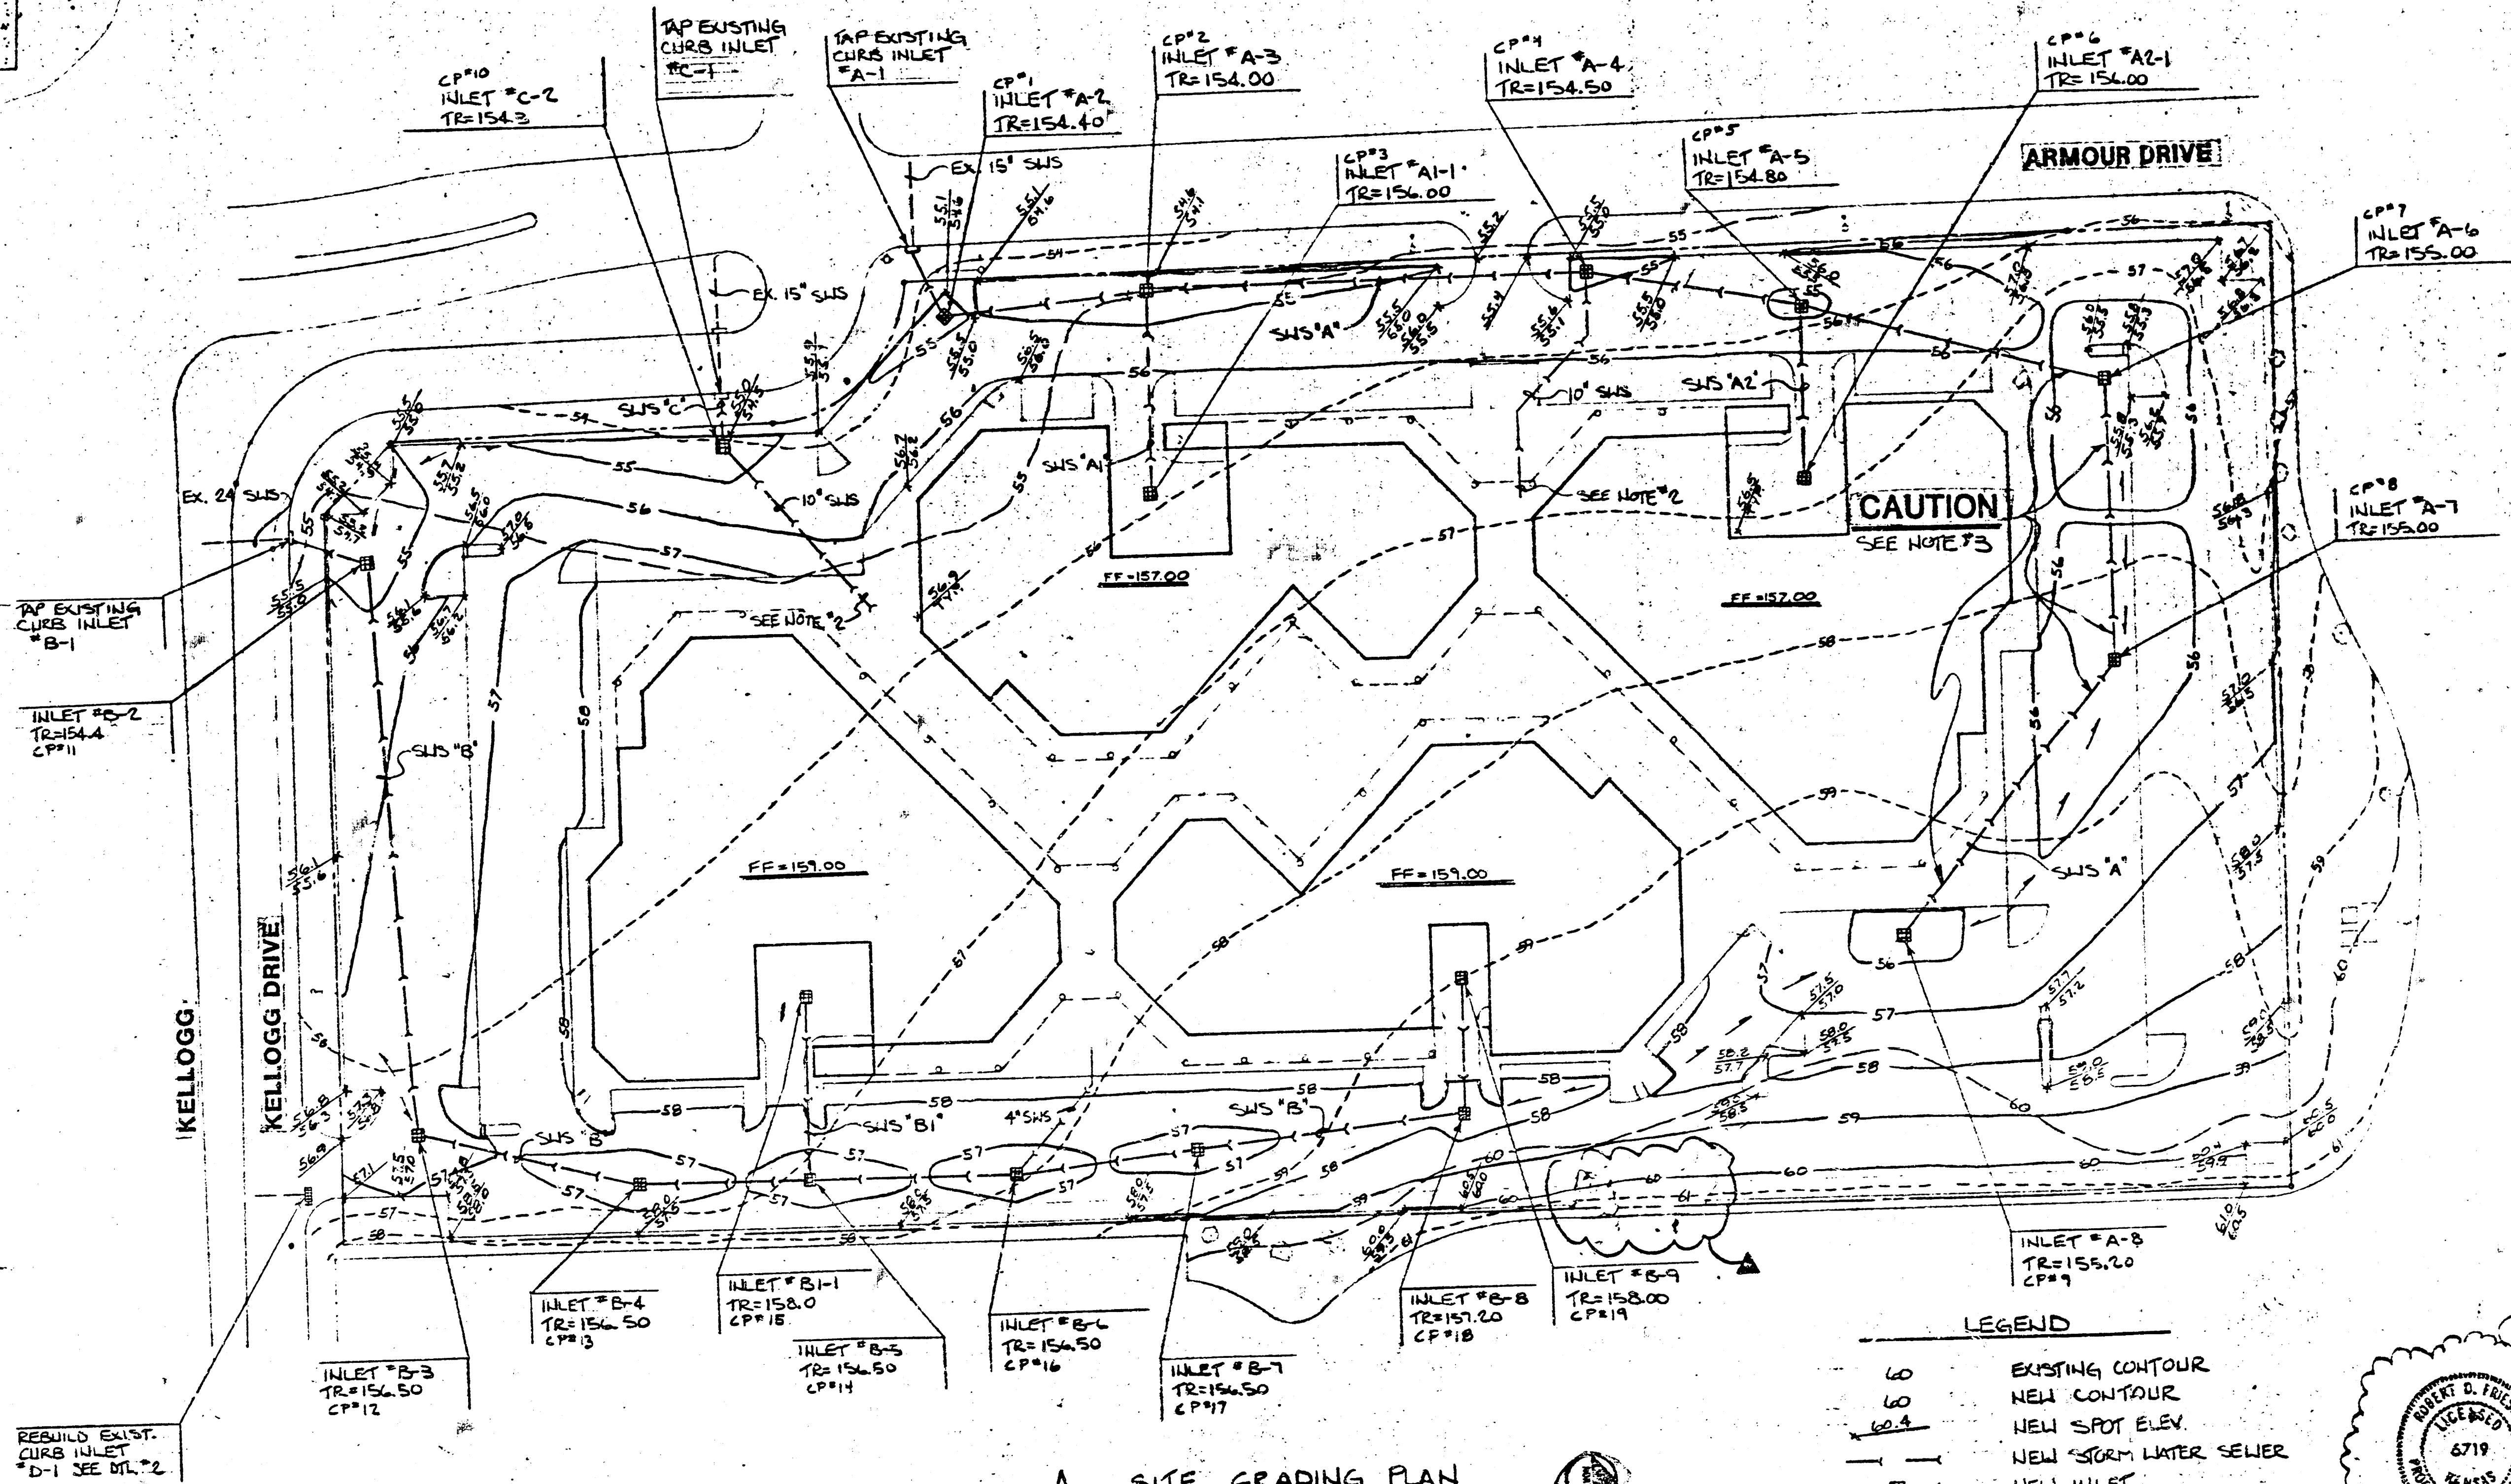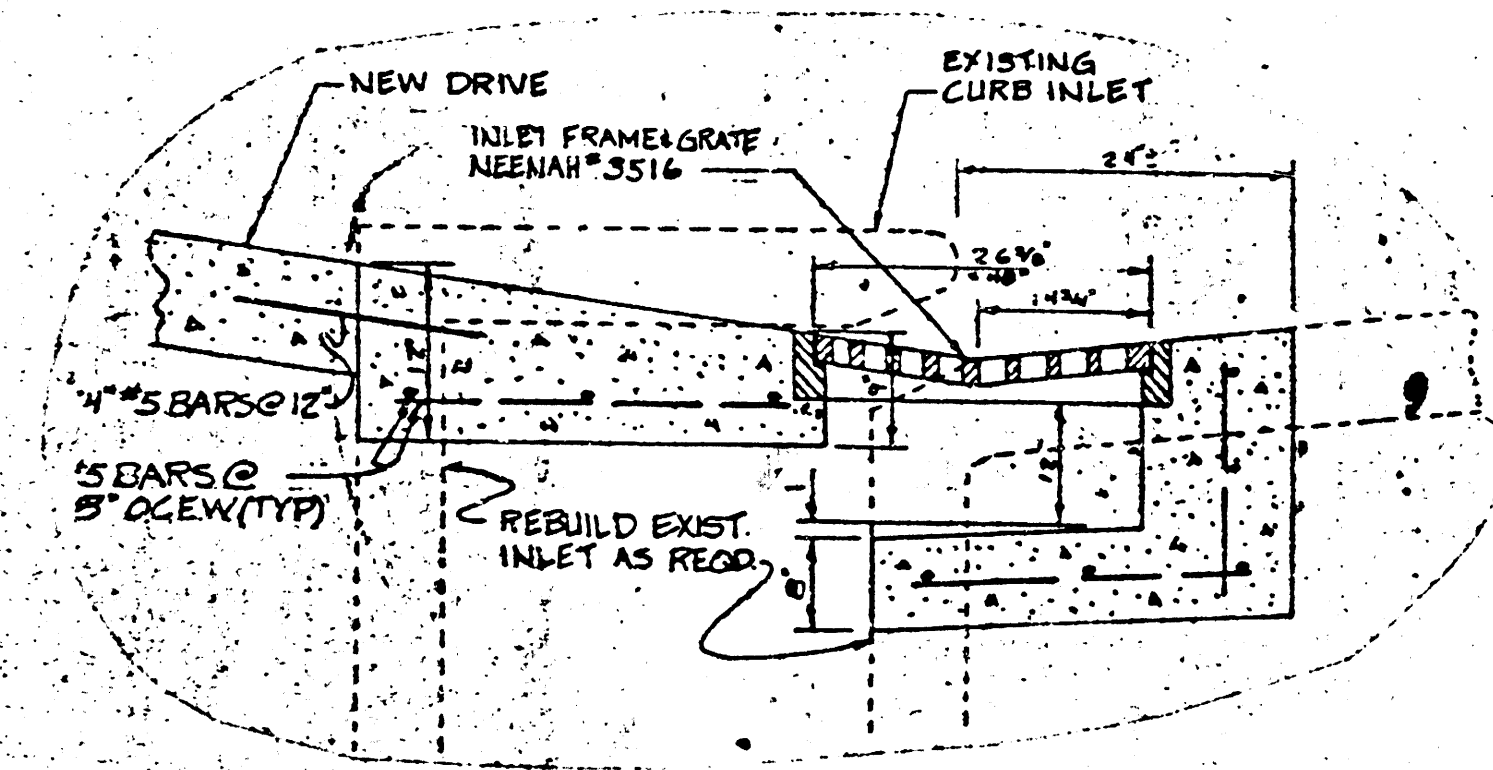

A SITE GRADING PLAN
SCALE: 1" = 40'
HAS BEEN REDUCED TO 1" = 50'

- LEGEND**
- EXISTING CONTOUR
 - - - NEW CONTOUR
 - - - NEW SPOT ELEV.
 - - - NEW STORM WATER SEWER
 - - - NEW INLET
 - - - DRAINAGE


PRINTS ISSUED	
DATE	AMOUNT
11/1/84	FOR CONSTRUCTION
11/1/84	REV. FOR CONSTRUCTION

FOR CONSTRUCTION: 11/1/84

REVISIONS	
DATE	ITEM
11/1/84	DELETED DRIVE
11/1/84	REV. FOR CIV. REVIEW



LAW/KINGDON, INC.
ARCHITECTS & ENGINEERS

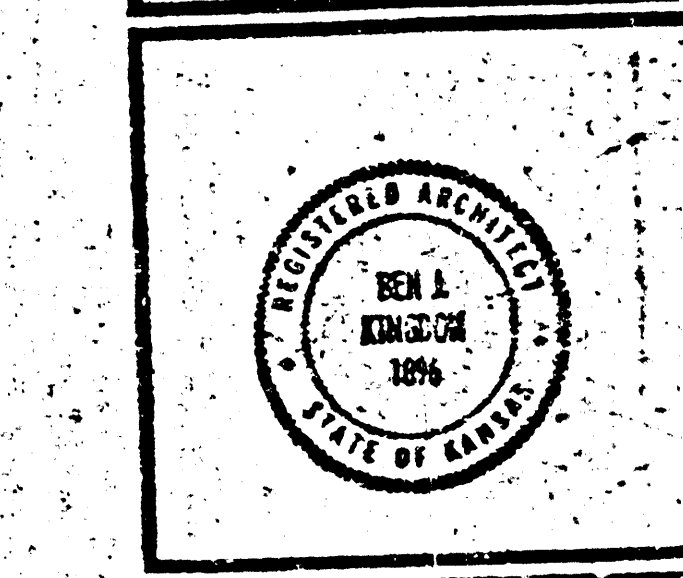



REVISION	CHECKED
1	

Village Fashion Centre
Armour Drive & Kellogg Drive
Wichita, Kansas
PROJECT NUMBER: 7422

KEY PLAN

SITE GRADING PLAN
SHEET TITLE: SG1
SHEET NUMBER: 1 OF 1

FILMED FROM THE BEST AVAILABLE COPY....

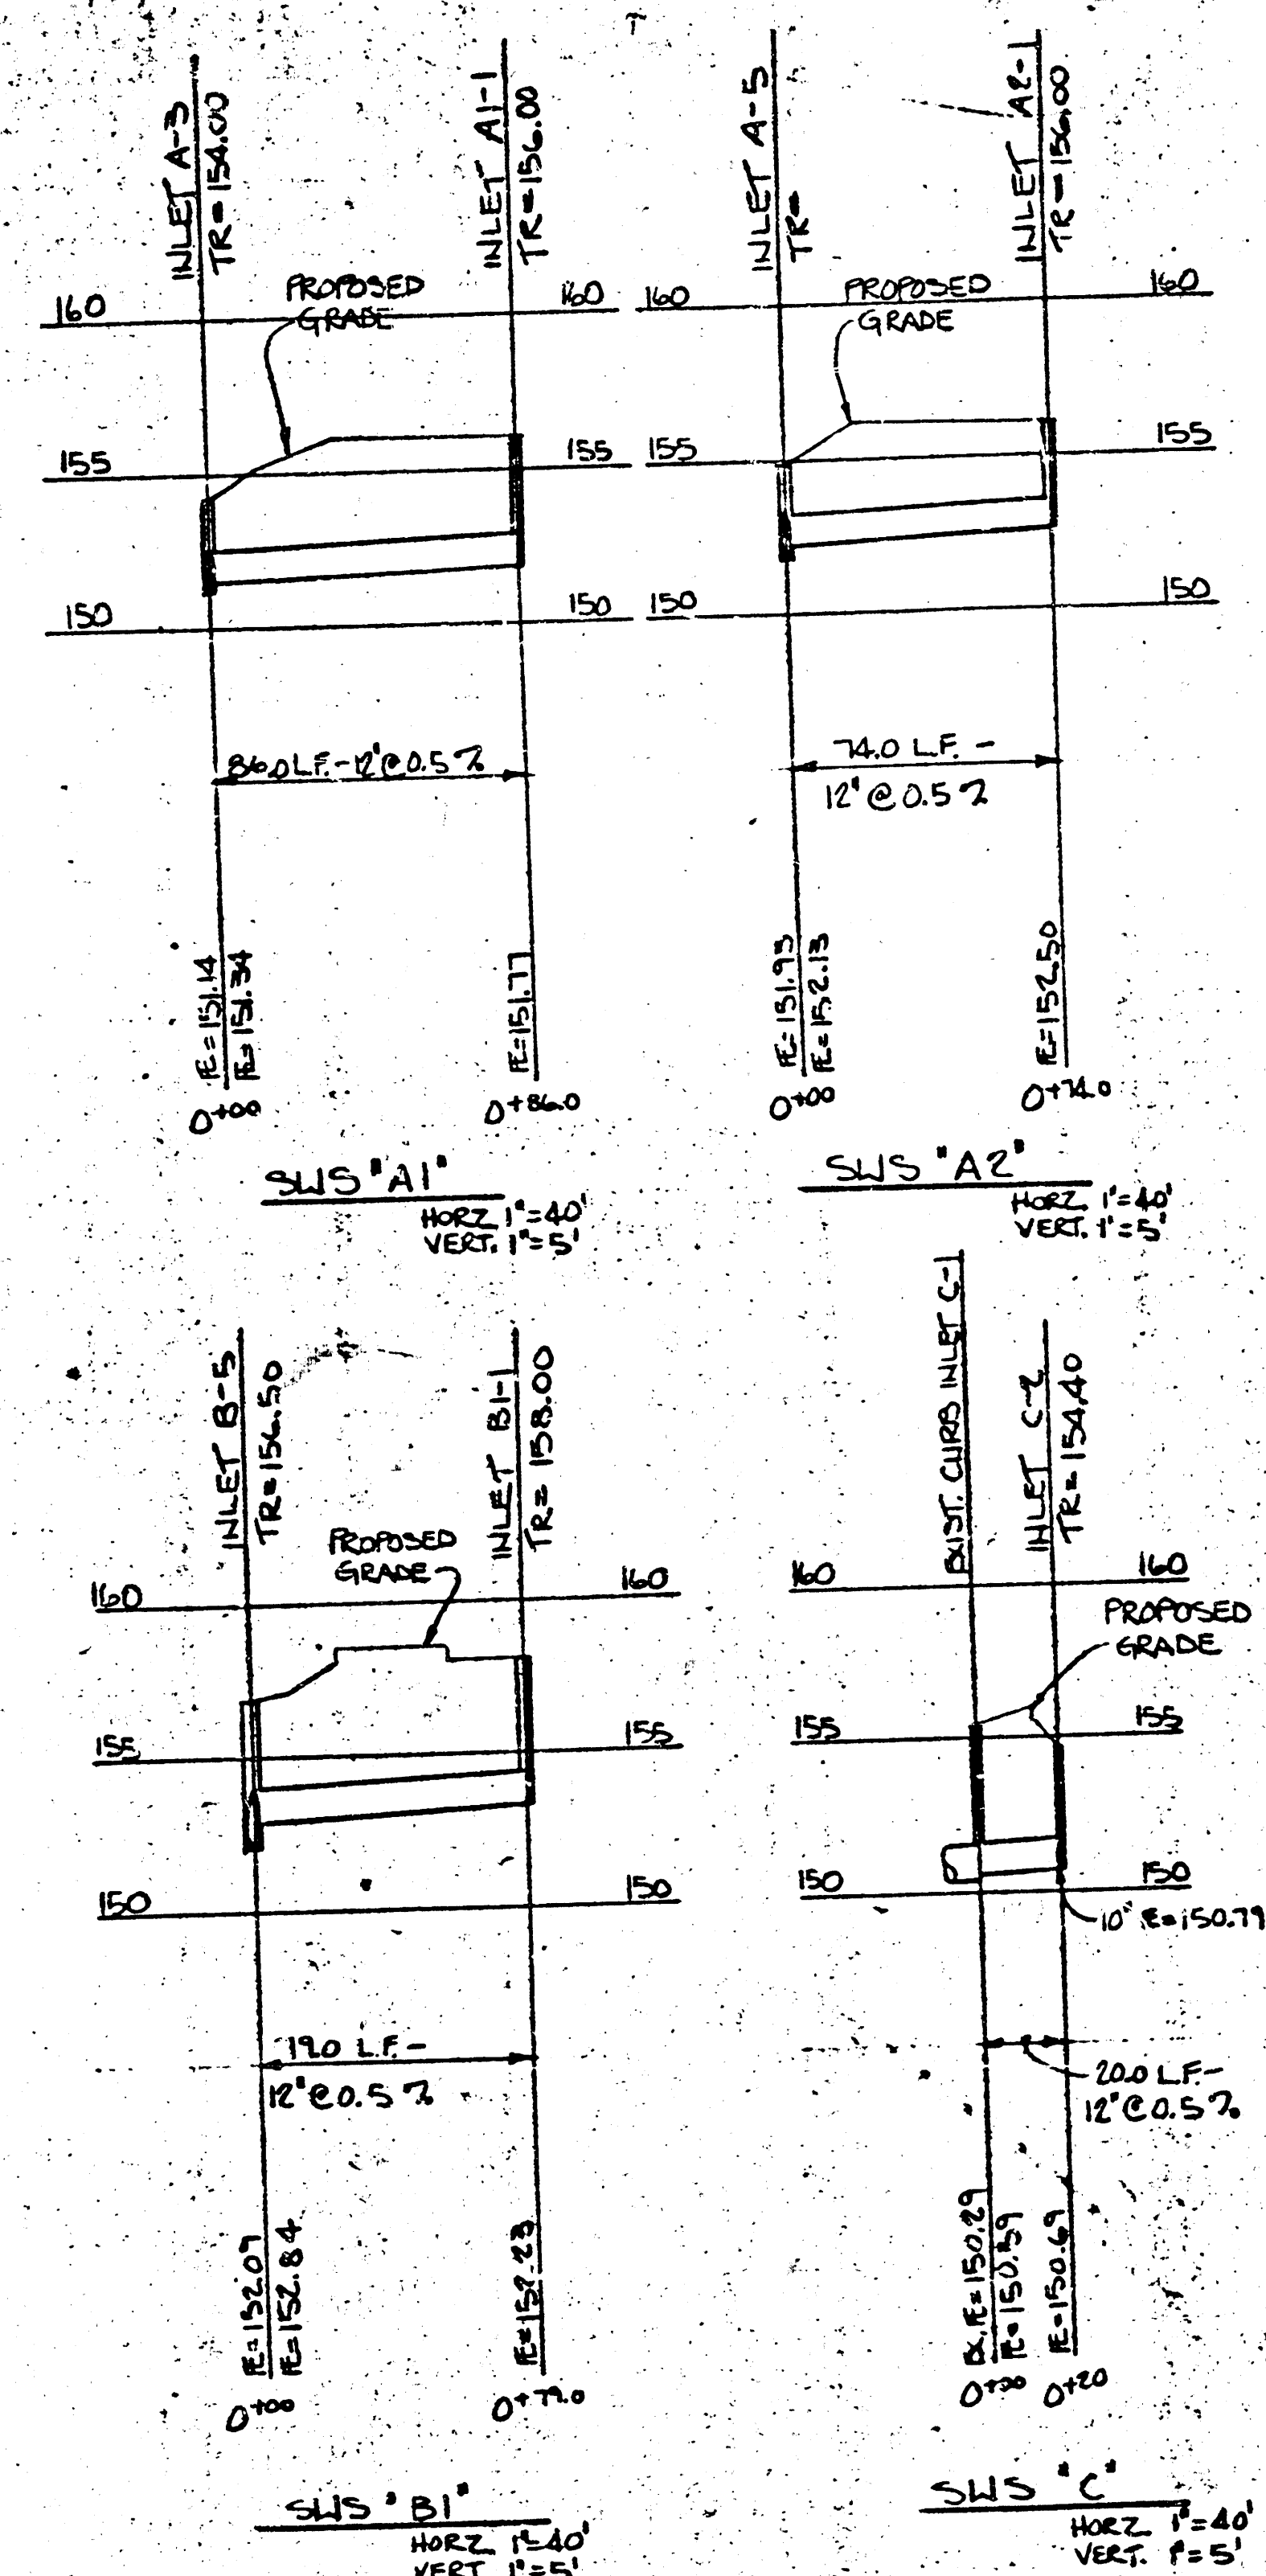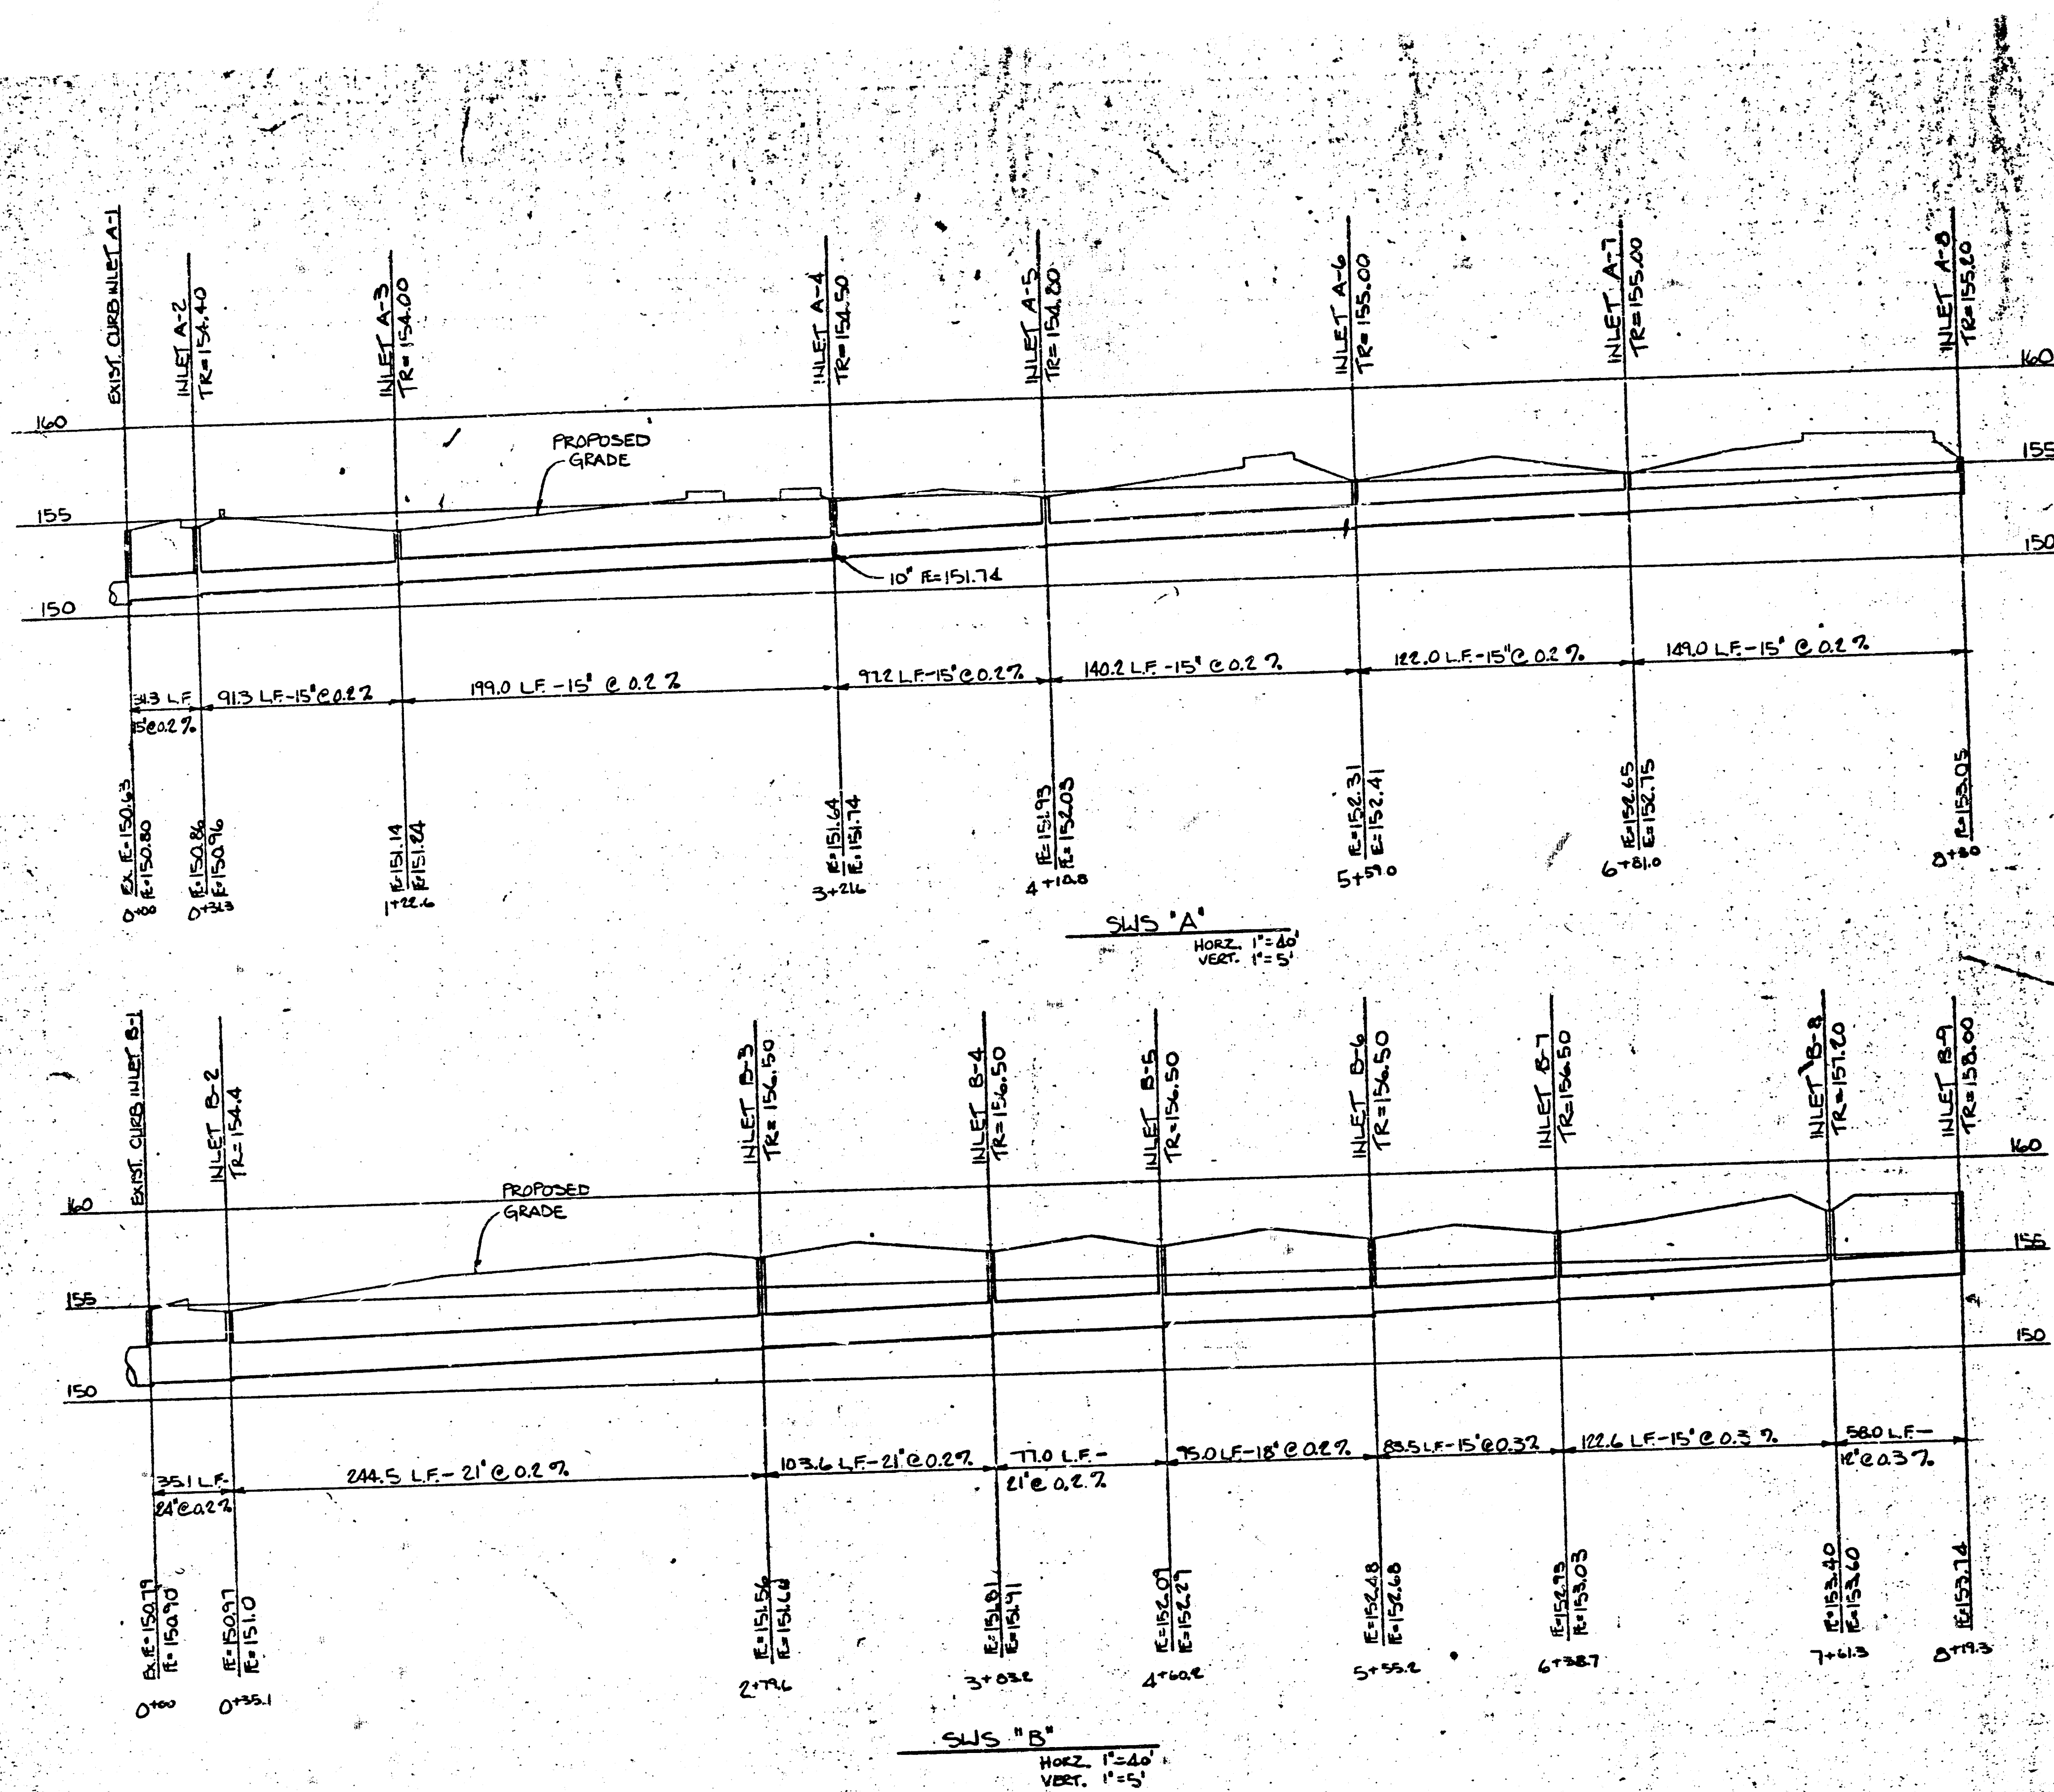

PRINTS ISSUED		
DATE	PURPOSE	NO.
11/1/84	FOR CONSTRUCTION	1
11/1/84	REV. FOR CONSTRUCTION	2

FOR CONSTRUCTION: 11/1/84

REVISIONS		
DATE	ITEM	NO.
11/1/84	REV. FOR CONSTRUCTION	1

LAW/KINGDON, INC.
 ARCHITECTS & ENGINEERS

REGISTERED ARCHITECT
 LAW/KINGDON
 STATE OF KANSAS



SEQUENCE NUMBER: 1 OF 1 SHEETS

Village Fashion Centre
 Armour Drive & Kellogg Drive
 Wichita, Kansas
 PROJECT NUMBER: 1422

KEY PLAN

STORM WATER SEWER PROFILES
 SHEET TITLE: SWS
 SHEET NUMBER: 1422

SG2
 11/1/84

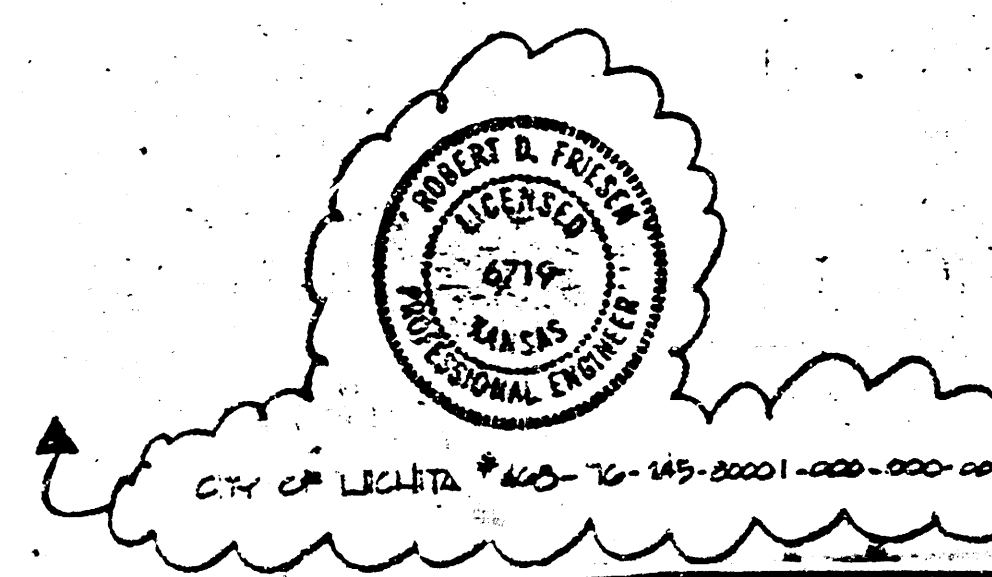

FILMED FROM THE BEST AVAILABLE COPY.....