


PLAN	DATE	
	BY	
	REVIEWED	
	NOTED	
NOTE: BOOK NO. 1000-1		

PROFILE	DATE	
	BY	
	REVIEWED	
	NOTED	
NOTE: BOOK NO. 1000-1		

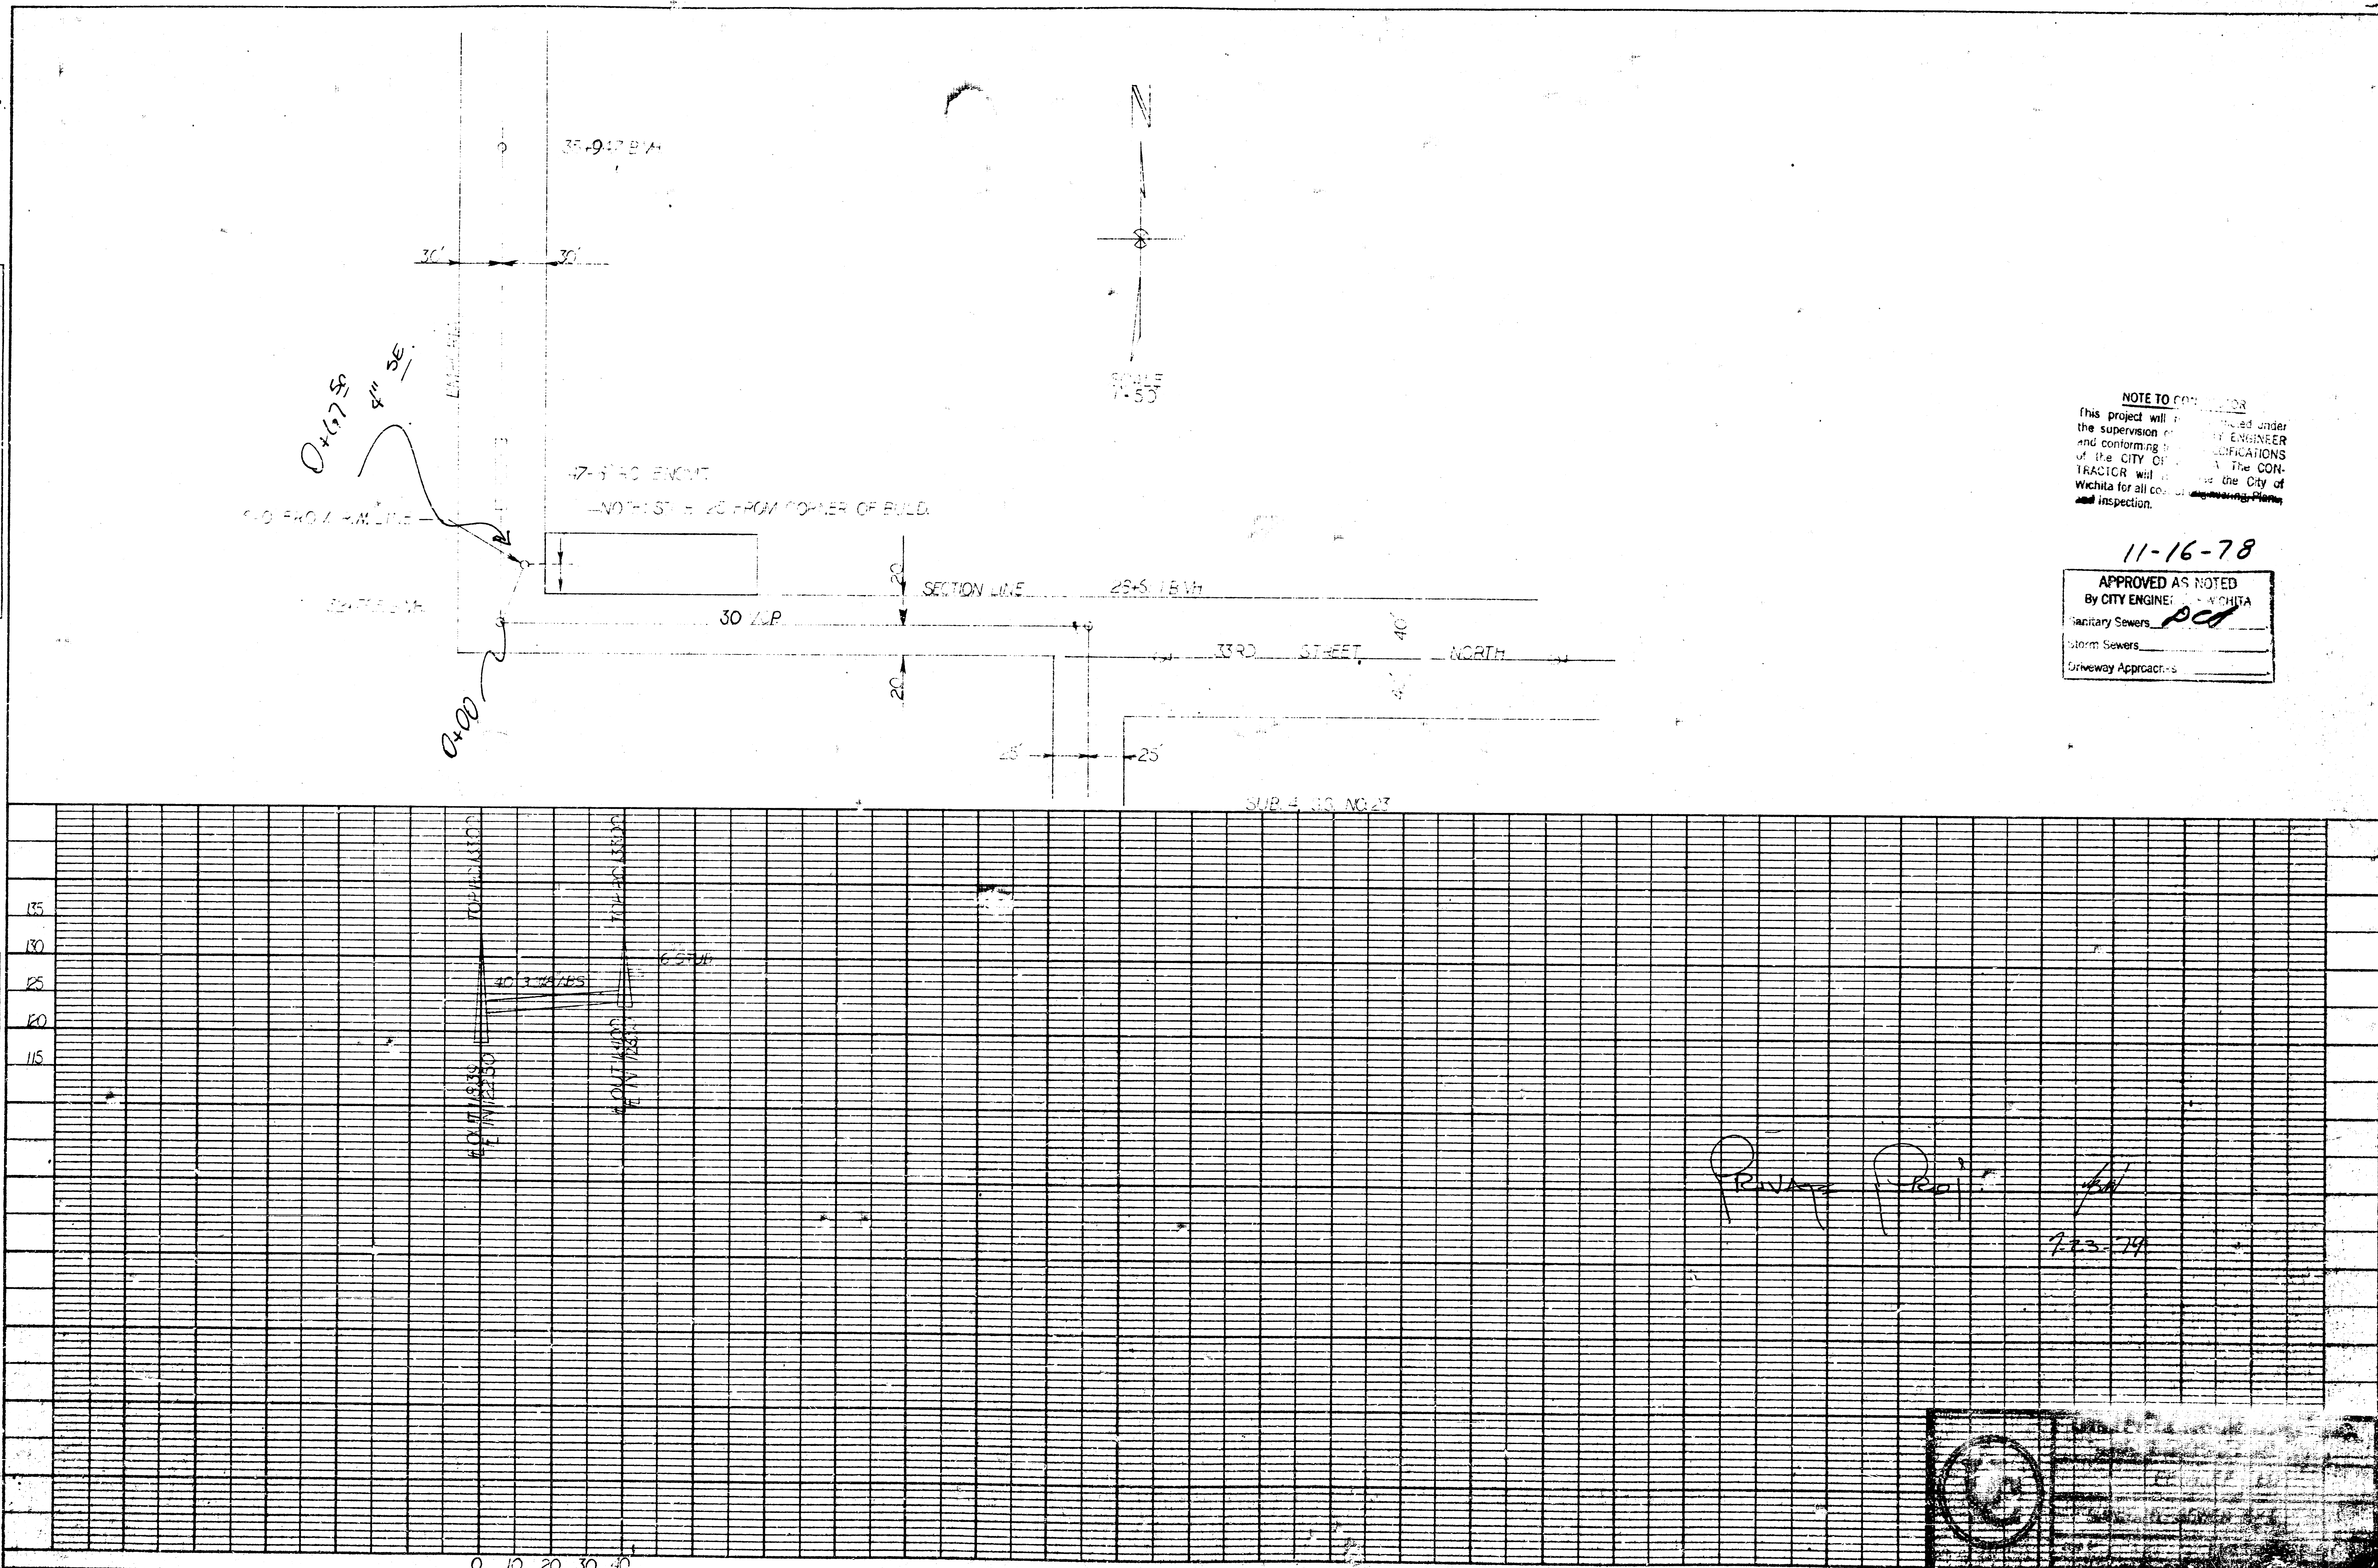

NOTE TO CONTRACTOR
This project will be completed under the supervision of the CITY ENGINEER and conforming to the specifications of the CITY OF WICHITA. The CONTRACTOR will be responsible for the City of Wichita for all costs of engineering, plans and inspection.

11-16-78
APPROVED AS NOTED
By CITY ENGINEER WICHITA
Sanitary Sewers *PC*
Storm Sewers
Driveway Approaches

14 10 3 15