



REINFORCING PER 8/S-6 SPANNING ACROSS ROOF

TUNNEL CROSSING SECTION

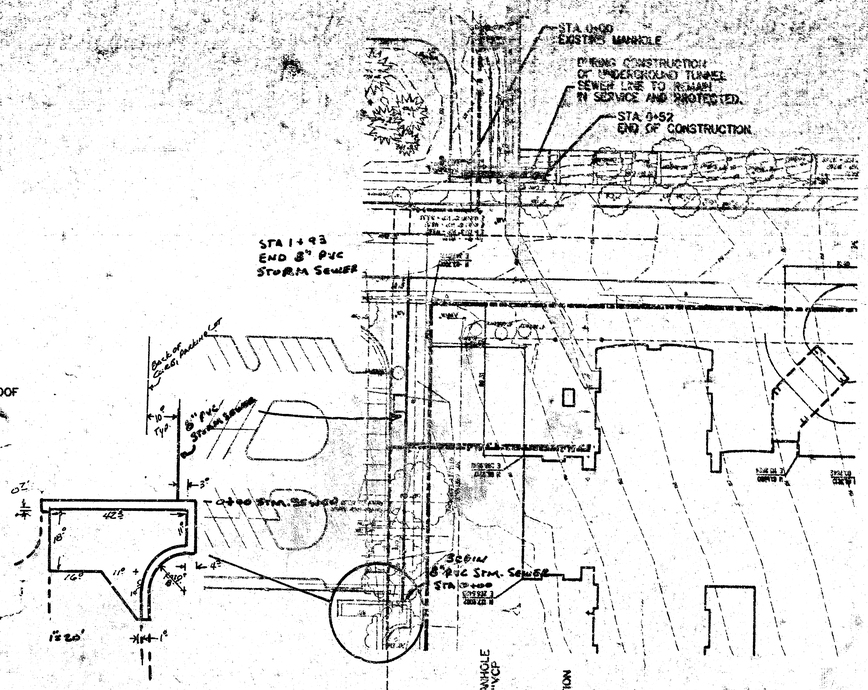

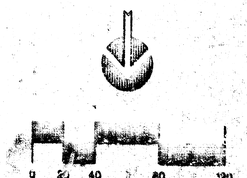

STEVEN S. ANDERSON
LICENSED
9253
KANSAS
PROFESSIONAL ENGINEER

As Built Plans
S.S. Anderson, PE/LS
December, 1995

SANITARY SEWER PLAN AND PROFILE