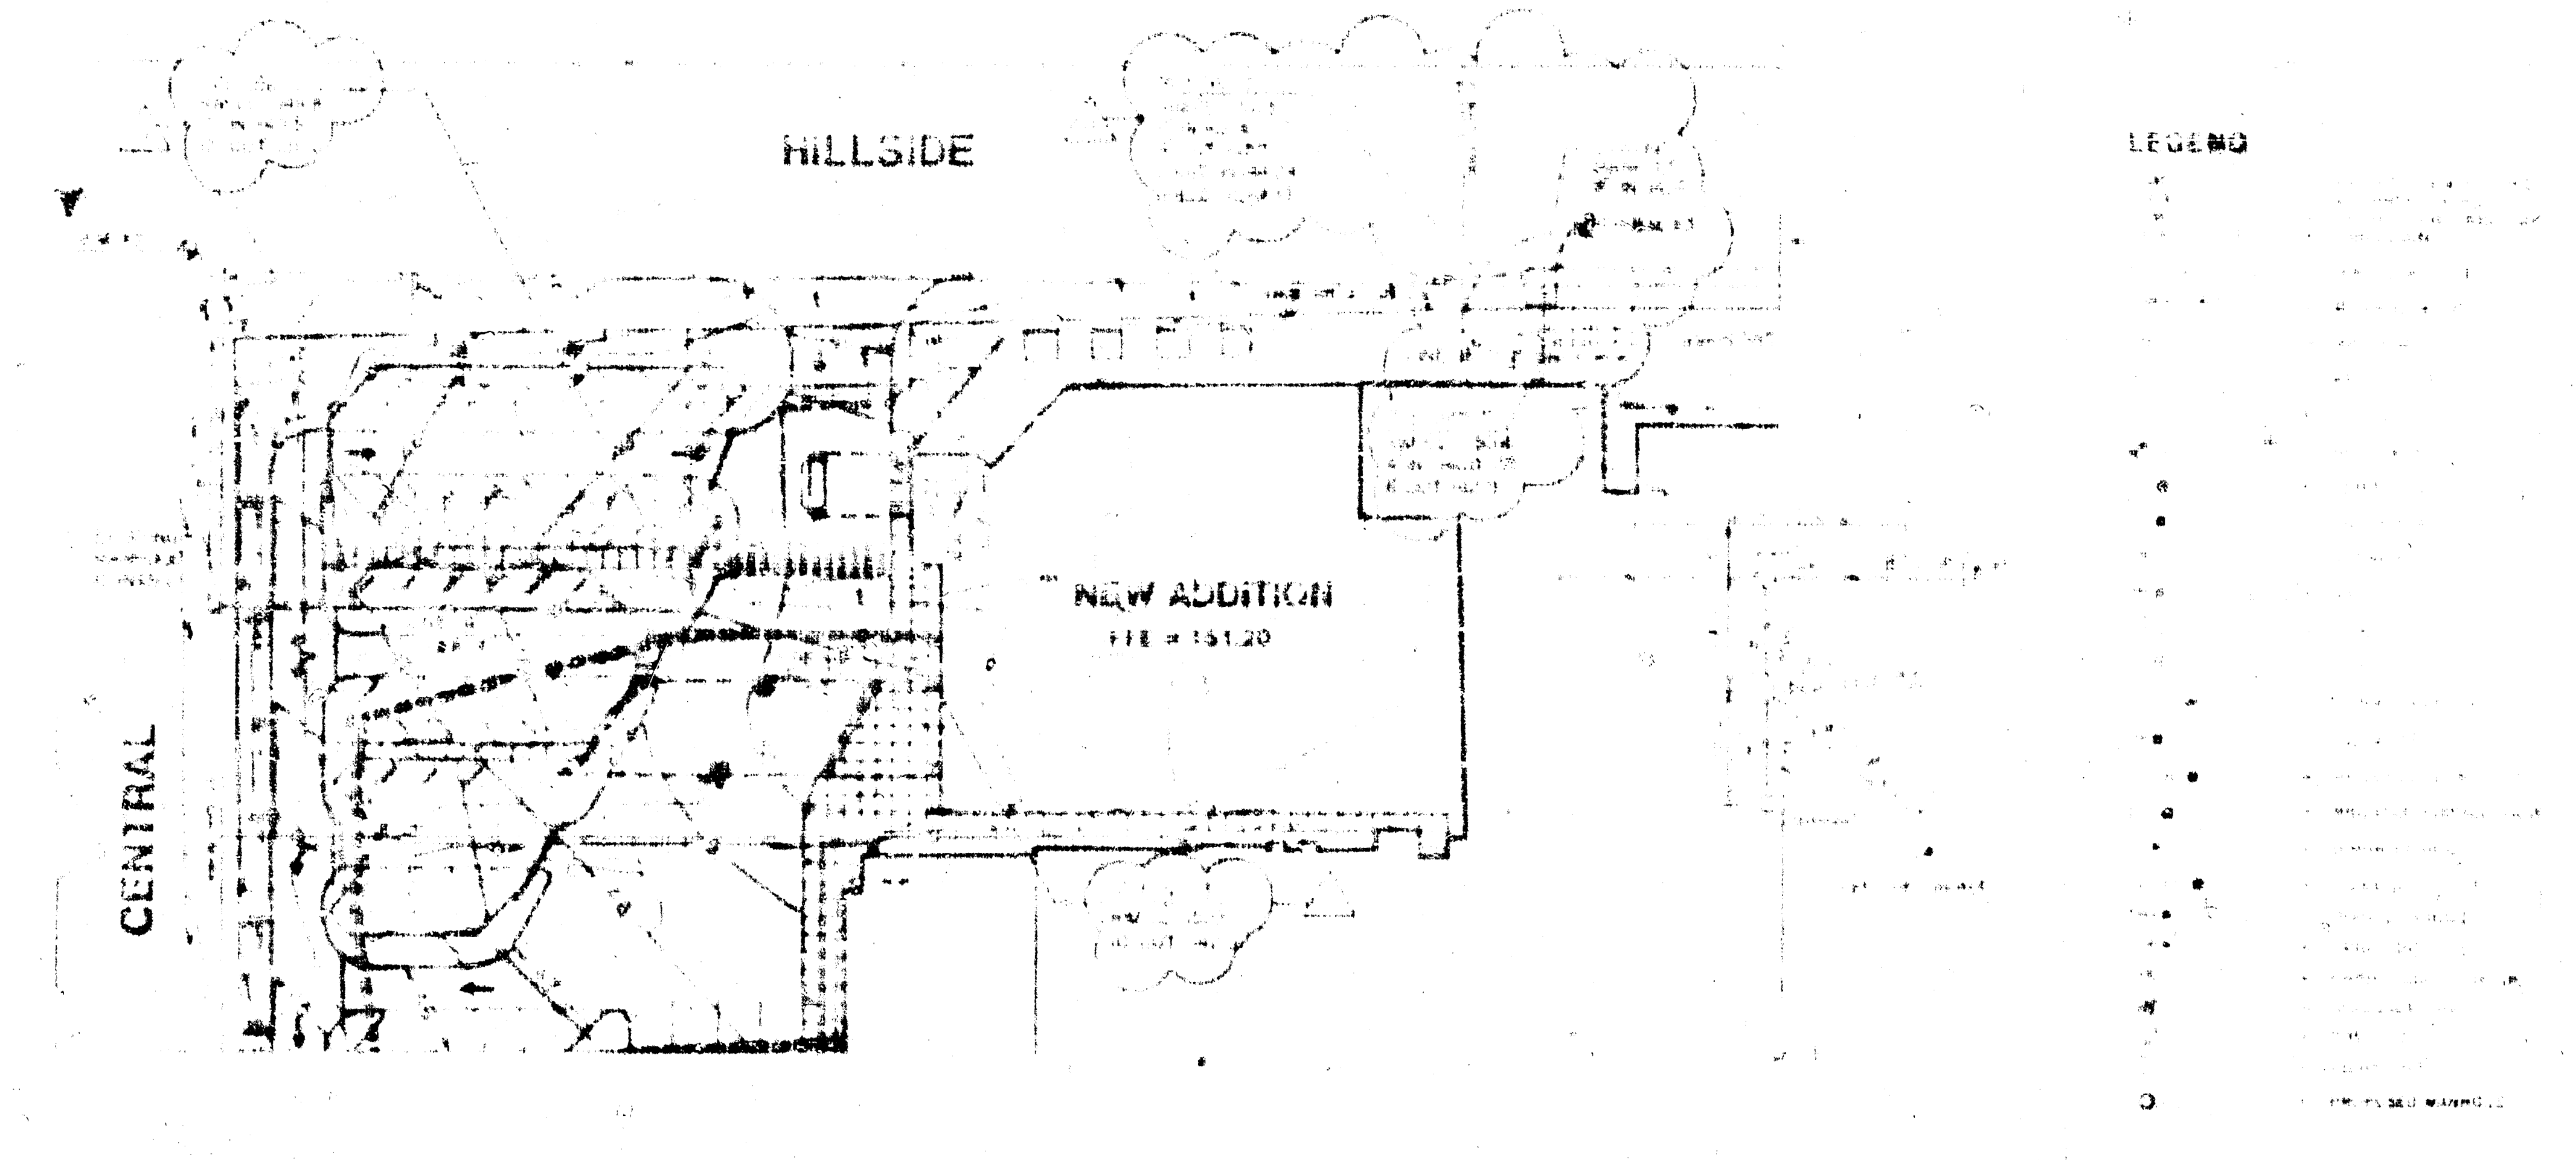

GENERAL NOTES

1. PROPOSED SANITARY SEWER TO BE BUILT TO CITY OF WICHITA STANDARD SPECIFICATIONS.
2. ALL LINES TO BE TV & AIR TESTED.
3. ALL MANHOLES TO BE VACUUM TESTED.

[illegible]

INSPECTION AND TESTING FOR THIS PROJECT IS TO BE PROVIDED BY A LICENSED CONSULTING ENGINEERING FIRM UNDER CONTRACT WITH THE OWNER/DEVELOPER. SAID INSPECTION TO BE IN ACCORDANCE WITH THE CITY OF WICHITA STANDARD CONSTRUCTION AND DESIGN PRACTICES AND CERTIFIED BY A LICENSED PROFESSIONAL ENGINEER. NO WORK SHALL BE PERFORMED IN DEDICATED EASEMENTS OR THE PUBLIC RIGHT-OF-WAY BY THE CONTRACTOR WITHOUT SUCH INSPECTION NOR SHALL ANY WORK BE COMMENCED IN DEDICATED EASEMENTS OR PUBLIC RIGHT-OF-WAY WITHOUT WRITTEN AUTHORIZATION BY THE CITY ENGINEER.

APPROVED AS NOTED
BY CITY ENGINEER OF WICHITA

Sanitary Sewer [illegible]
Storm Sewers ______
Driveway Approaches ______
Water Mains ______
Paving ______

BENCH MARK INFORMATION

BM #1 [illegible] ON N.E. CORNER CENTRAL & HILLSIDE. ELEV= 144.[illegible]

BM #2 [illegible] HILLSIDE [illegible] ELEV= [illegible]

PLAN SCALE: 1" = 40'
PROFILE SCALE: HORIZ. [illegible]
VERT. [illegible]

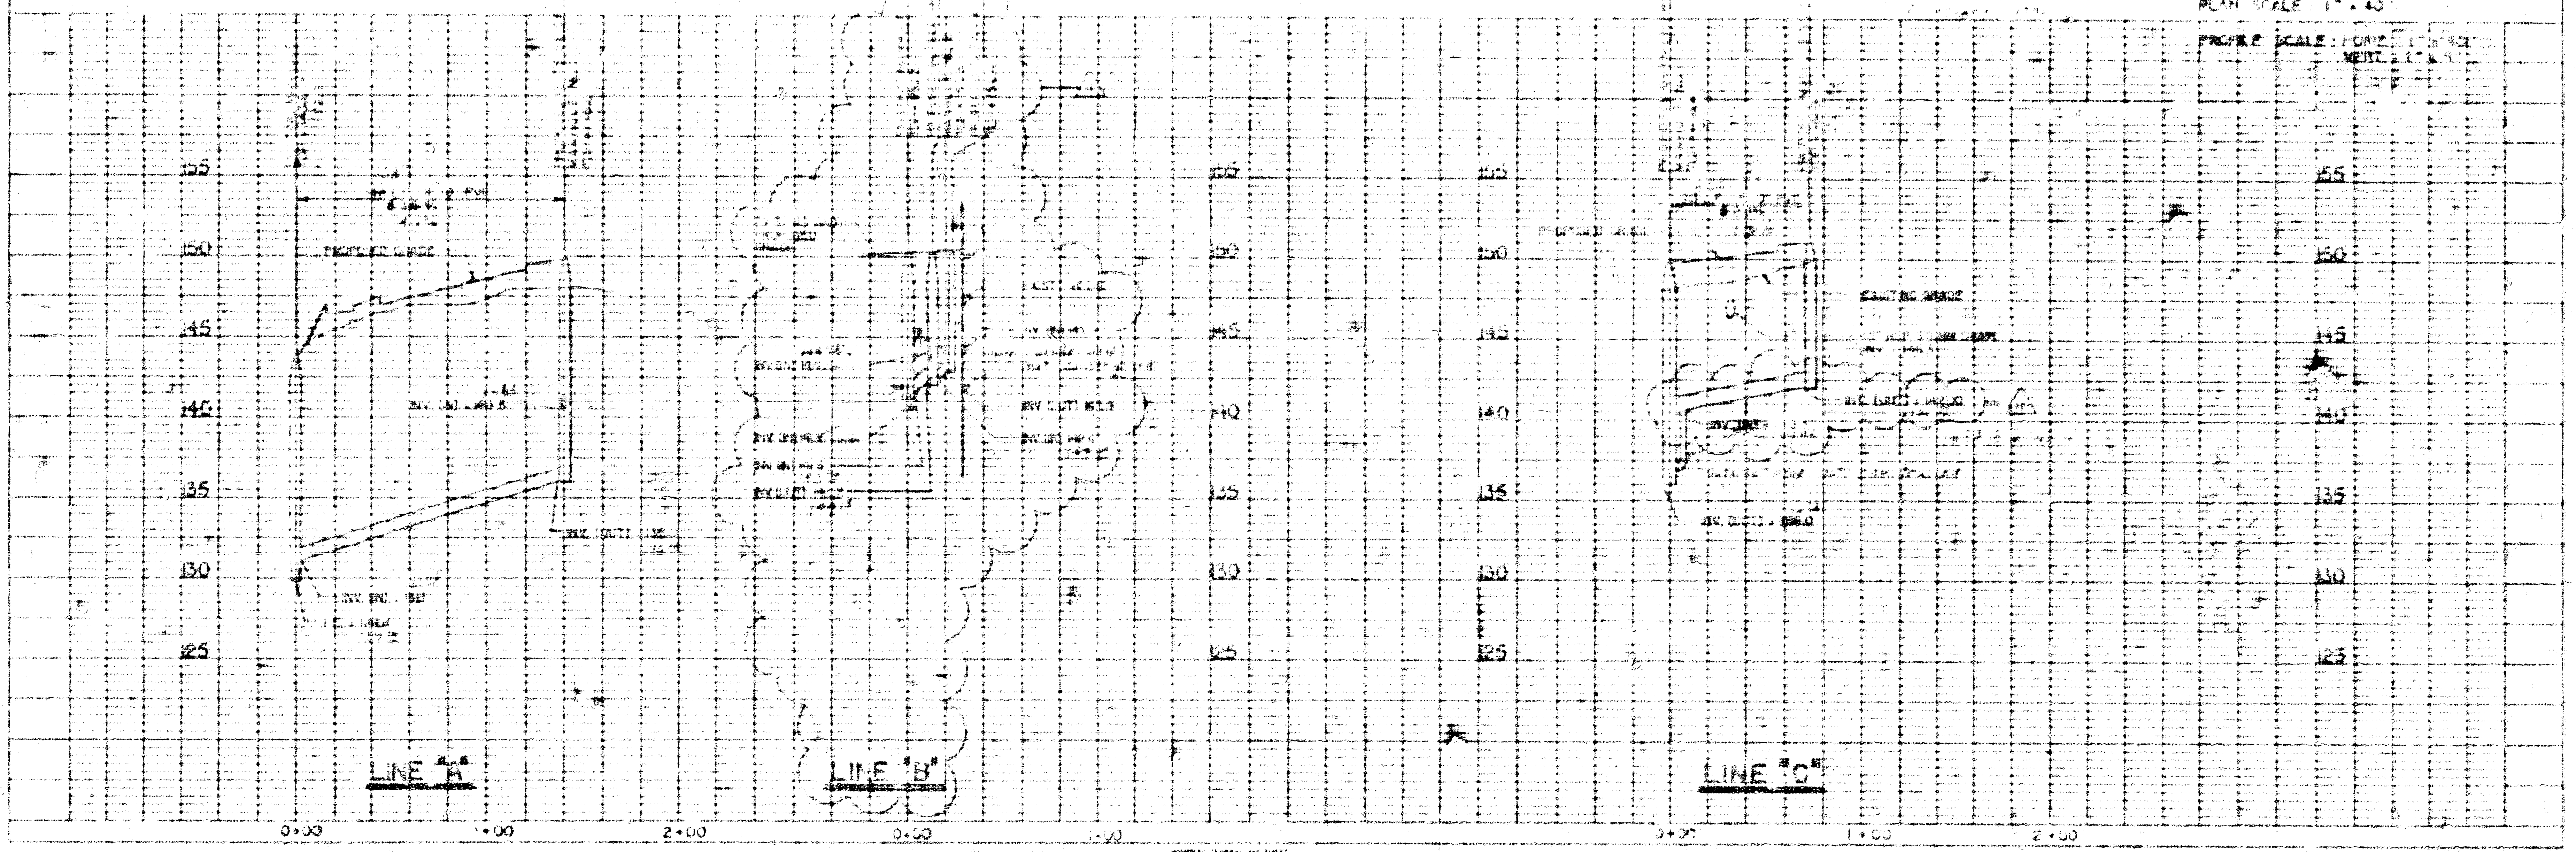

CITY OF WICHITA PRIVATE PROJECT NO. 3[illegible]2PPS(607AS1)

VOLUME TWO

GOULD TURNER GROUP, P.C.
ARCHITECTS & PLANNERS
4300 HARDING ROAD, SUITE 1000
NASHVILLE, TN 37205

WESLEY MEDICAL CENTER
ADDITIONS AND RENOVATIONS
WICHITA, KANSAS

HCA The Healthcare Company

SANITARY SEWER PLAN AND PROFILE

C4.03

FILMED FROM THE BEST