

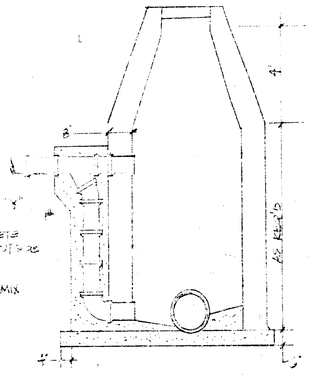


OUTSIDE DROP MANHOLE
TYPE "A" or "C"

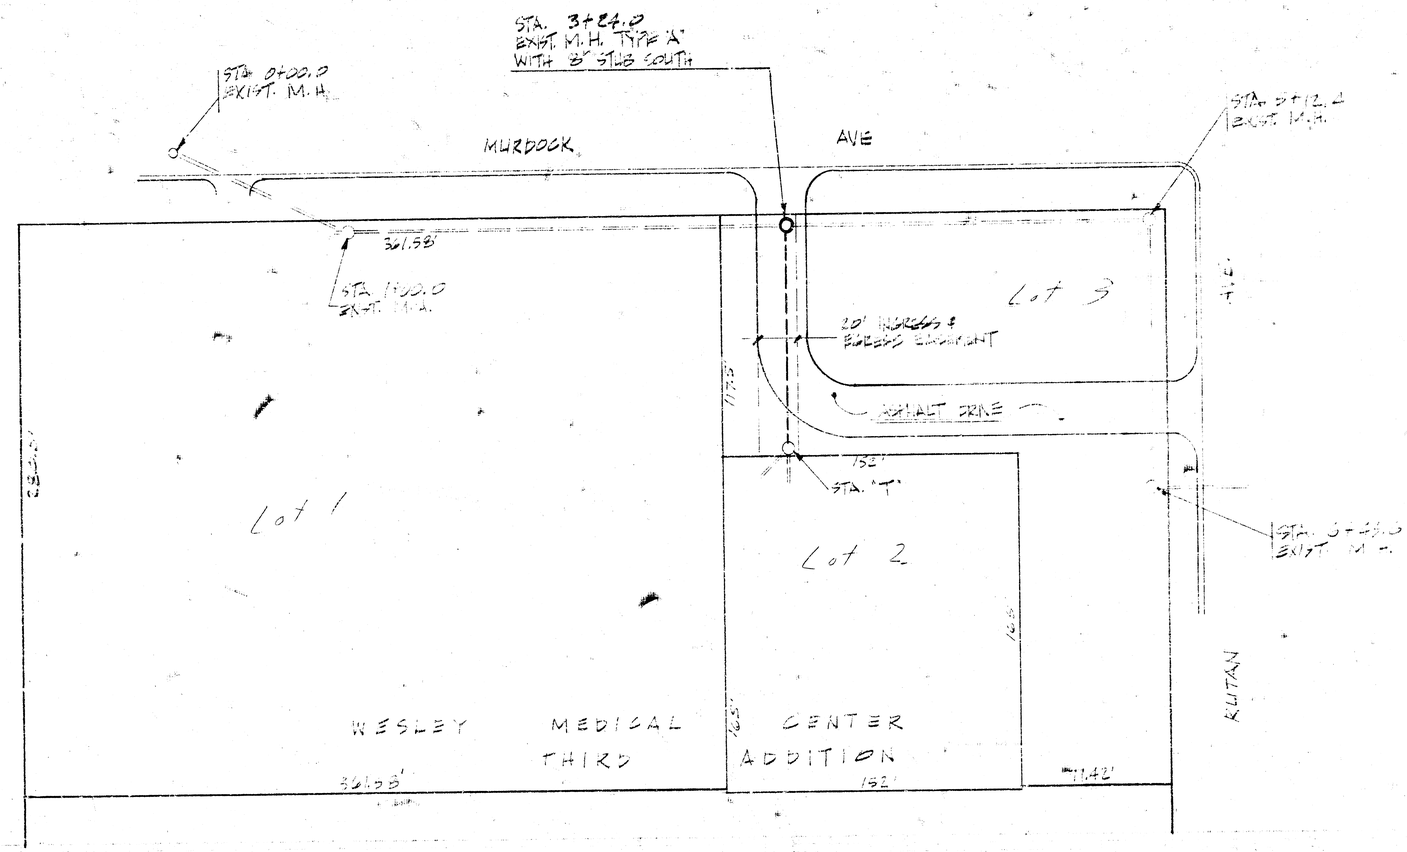

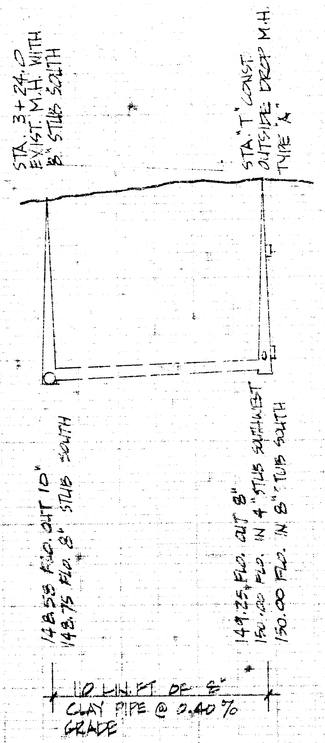

7-7-75
APPROVED AS NOTED
by CITY ENGINEER OF WICHITA
Sanitary Sewers D. E. S.
Storm Sewers
Driveway Approaches

Central
Air Conditioning Co., Inc.
Mechanical Contractors

GENERAL NOTES:
1. ALL PIPING PER CITY OF WICHITA STANDARDS
2. ALL EXCAVATION PER OSHA STANDARDS
3. ALL BACKFILL PER CITY OF WICHITA STANDARDS

ADDITION TO A PART OF
DIST. M. S. S. NO. 12
CITY OF WICHITA KANSAS
PROJECT NO. DBRW 205 7 0