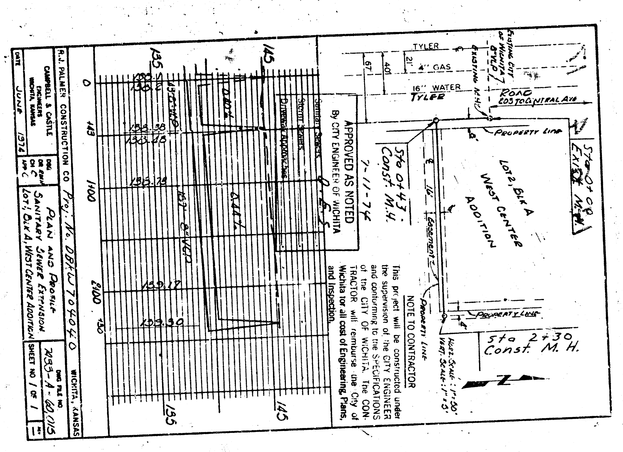
TYLER
21'
4" GAS
40'
6"
16" WATER
TYLER
PROPERTY LINE
Sta 0+00 Exist. M.H.
LOTS 2, BLK A
WEST CENTER
ADDITION
PROPERTY LINE
PROPERTY LINE
Sta 2+30 Const. M.H.
Horiz. Scale: 1"=50'
Vert. Scale: 1"=5'
7-11-74
APPROVED AS NOTED
By CITY ENGINEER OF WICHITA
NOTE TO CONTRACTOR
This project will be constructed under the supervision of the CITY ENGINEER and inspection of the CITY ENGINEER of the CITY OF WICHITA. The CONTRACTOR will reimburse the City of Wichita for all cost of Engineering, Plans, and Inspection.
145
145
145