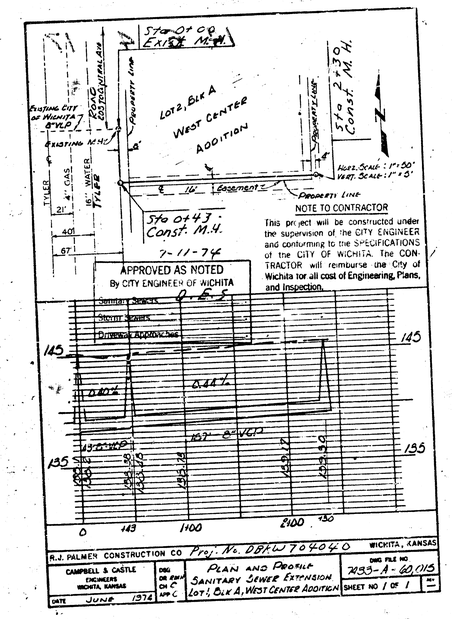


NOTE TO CONTRACTOR

This project will be constructed under the supervision of the CITY ENGINEER and conforming to the SPECIFICATIONS of the CITY OF WICHITA. The CONTRACTOR will reimburse the City of Wichita for all cost of Engineering, Plans, and inspection.

R.J. PALMEN CONSTRUCTION CO Proj. No. DBFW 704040 WICHITA, KANSAS

CAMPBELL & CASTLE ENGINEERS WICHITA, KANSAS

DRG. OR REV. OR C. APP. C.

DATE JUNE 1974

PLAN AND PROFILE
SANITARY SEWER EXTENSION
LOT 1, BLK A, WEST CENTER ADDITION

DWG FILE NO 733-A-80113

SHEET NO 1 OF 1