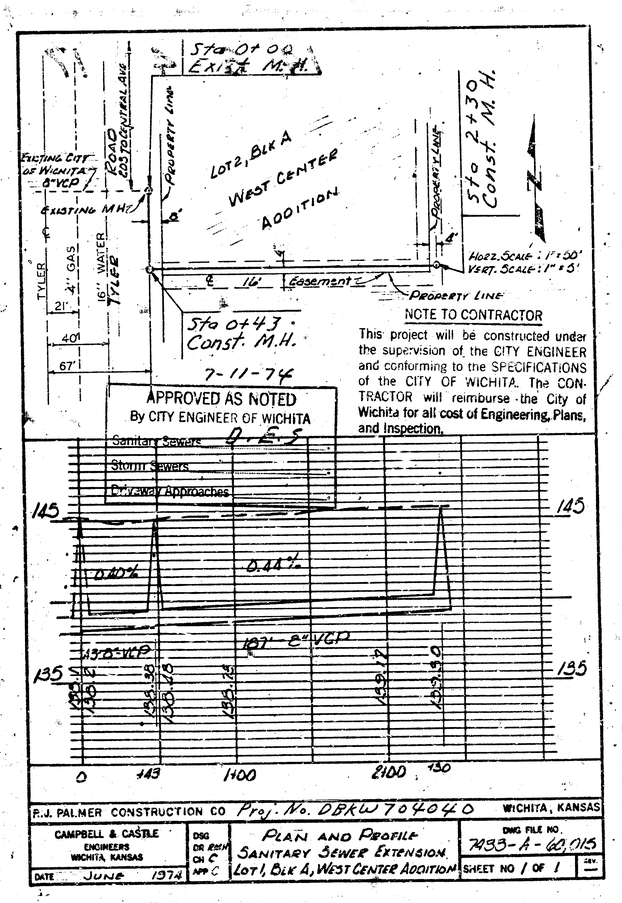

Sta 0+00
Existing M.H.
Existing City of Wichita 8" VCP
Existing MH
Road Cost Industrial Ave
Property Line
Lot 2, Blk A
West Center
Addition
Sta 2+30
Const. M.H.
Horz. Scale: 1" = 50'
Vert. Scale: 1" = 5'
Tyler
21'
40'
67'
4" Gas
16" Water
Tyler
16' Easement
Property Line
Sta 0+43
Const. M.H.
7-11-74
APPROVED AS NOTED
By CITY ENGINEER OF WICHITA
Sanitary Sewers
Storm Sewers
Driveway Approaches
NOTE TO CONTRACTOR
This project will be constructed under the supervision of the CITY ENGINEER and conforming to the SPECIFICATIONS of the CITY OF WICHITA. The CONTRACTOR will reimburse the City of Wichita for all cost of Engineering, Plans, and Inspection.
145
135
0.40%
0.44%
197' 8" VCP
0
149
1400
2100
150
R.J. PALMER CONSTRUCTION CO
Proj. No. DBKW 704040
WICHITA, KANSAS
CAMPBELL & CASTLE
ENGINEERS
WICHITA, KANSAS
DSG
DR RCH
CH C
APP C
DATE JUNE 1974
Plan and Profile
Sanitary Sewer Extension
Lot 1, Blk A, West Center Addition
DWG FILE NO.
7493-A-60,015
SHEET NO 1 OF 1