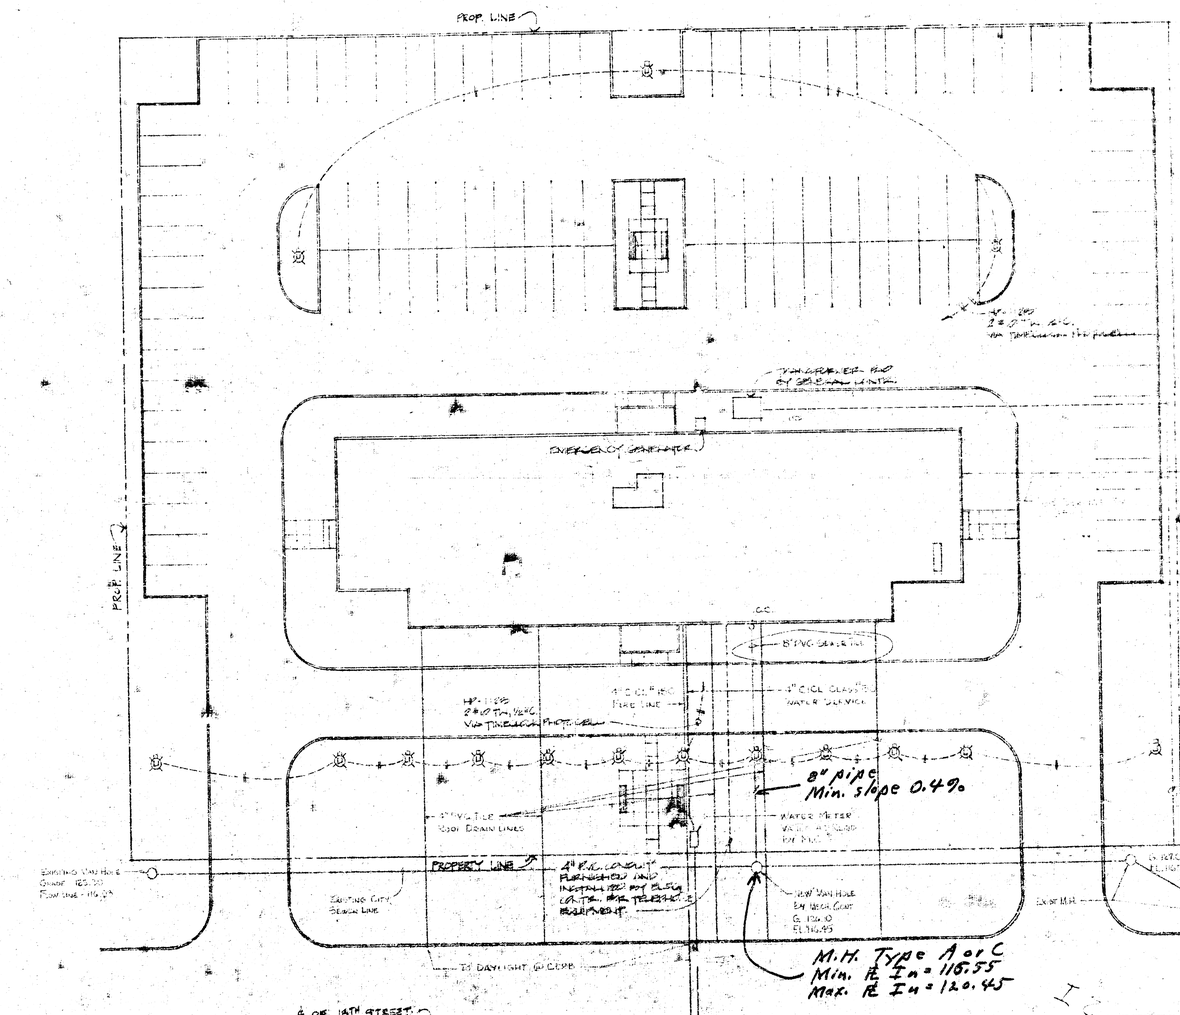


NOTE TO CONTRACTOR

This project will be inspected under the supervision of the CITY ENGINEER and conformance to the specifications of the CITY will be required. The Contractor will be responsible for City of Wichita inspection fees.

1-24-17

APPROVED AS NOTED
By CITY ENGINEER OF WICHITA
Sanitary Sewers D.E.S.
Storm Sewers
Driveway Approaches

WEST PARK TOWER
WEST 13TH STREET
WICHITA, KANSAS

sheet title
SITE UTILITY PLAN

sheet number