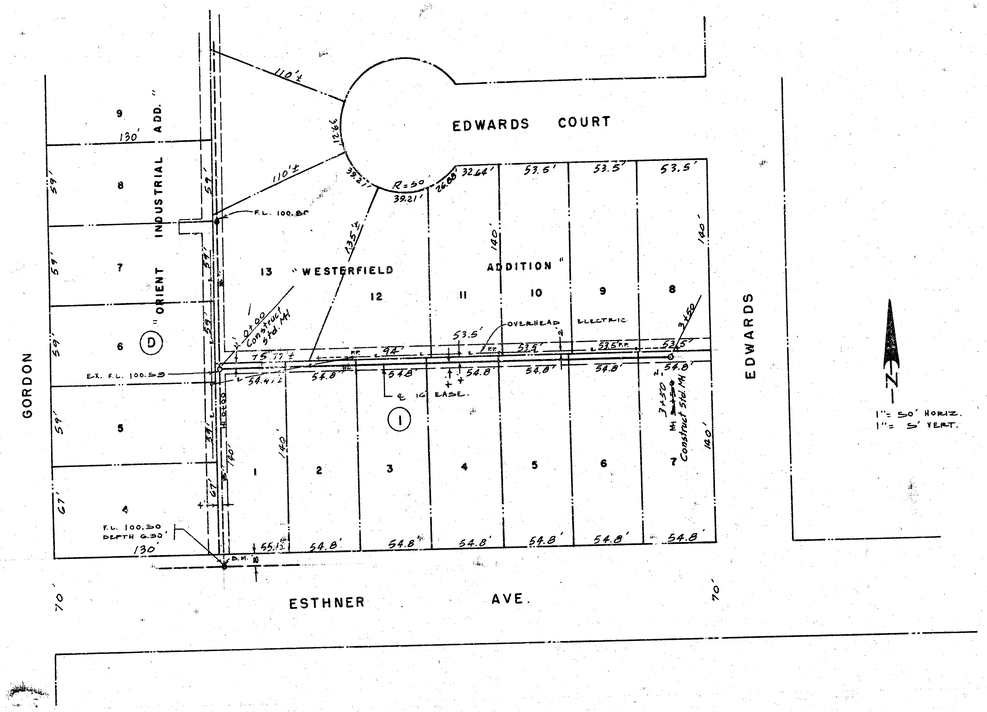

NOTE TO CONTRACTOR

This project will be constructed under the supervision of the CITY ENGINEER and conforming to the SPECIFICATIONS of the CITY OF WICHITA. The CONTRACTOR will reimburse the City of Wichita for all cost of ~~Engineering, Plans, and~~ Inspection.

10-19-79

APPROVED AS NOTED
by CITY ENGINEER OF WICHITA
Sanitary Sewers PEJ
Storm Sewers
Driveway Approaches

SANITARY SEWER EXTENSION TO SERVE LOTS 1 THRU 13, BLOCK 1, WESTERFIELD ADDITION.

KENNETH O. TAYLOR, P.E.
OCT. 15, 1979

KENNETH O. TAYLOR LICENSED 1858 KANSAS PROFESSIONAL ENGINEER

B.M. - ELEV. 107.20 : NORTH RIM OF MH 8' SOUTH AND 4' EAST OF THE SW CORNER OF LOT 1, BLOCK 1, WESTERFIELD ADDITION.

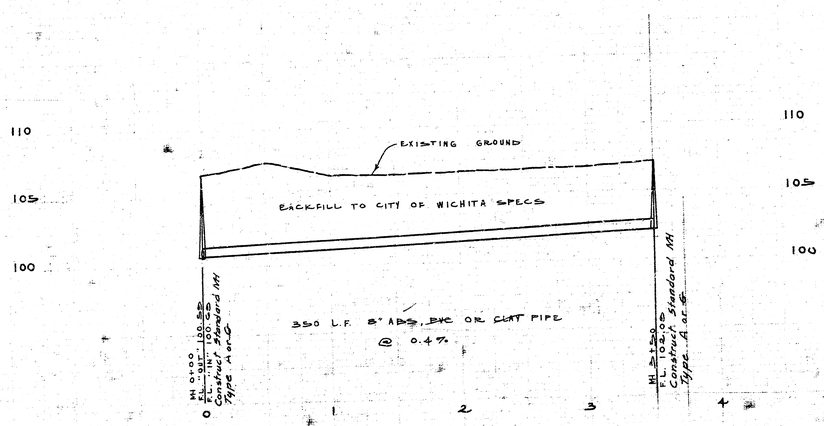

As Built
3/31/80

PROJECT NO. 468-76-245-80865-000-000-008

1/1