
BENCH MARK: City Disc @ Pawnee and Sheridan, Elev = 103.29 City Datum

"X" Cut on High Edge West Side of Sheridan 107' South Line of Lot 1, Block 1, Westport Industrial Park First Addition = 102.68

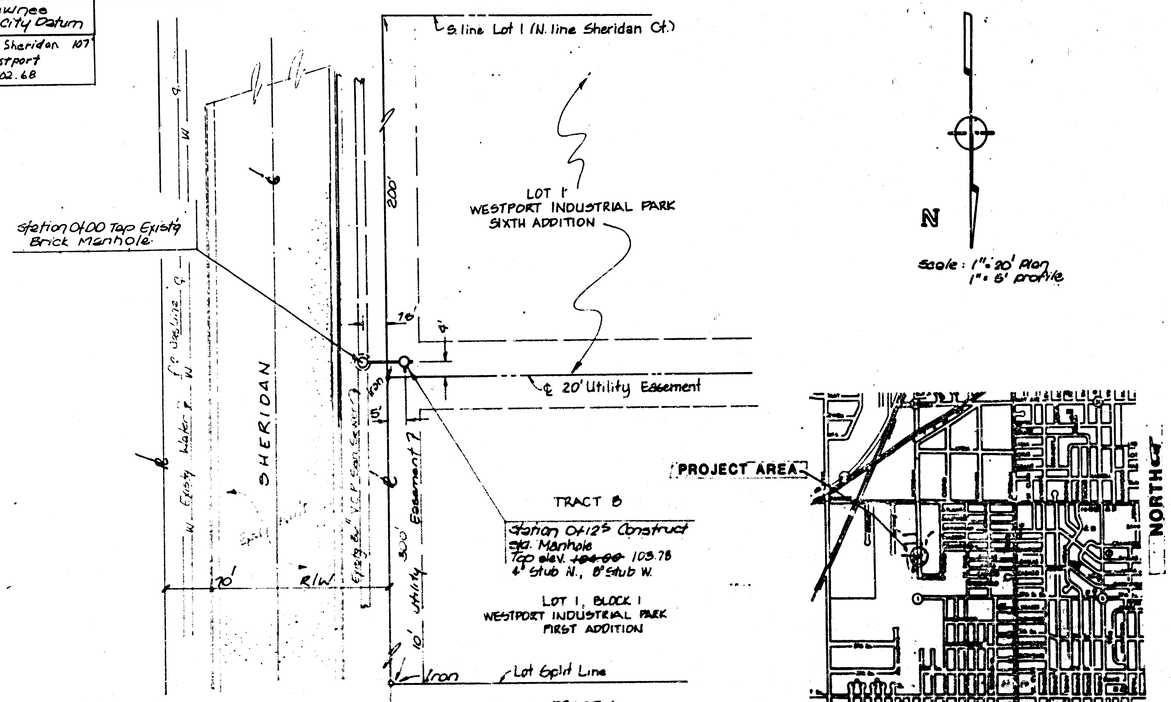

GENERAL NOTES

1. Contractor will be required to provide a minimum advance notice of twenty-four (24) hours to utility companies prior to starting any excavation as follows:

Kansas One-Call	1-800-344-7233

The Contractor must notify the following in case of an emergency:


Cable vision	262-4270 or 263-2061
K.P.& L. Gas Service Company	263-7511
Kansas Gas & Electric	264-1141
Arkla Gas Company	942-8350 or 263-8161
Southwest Bell Telephone Company	1-571-2611
City of Wichita Water Department	268-4908
City of Wichita Sewer Maintenance	268-4071

2. Underground utility service lines and overhead utility pole lines are to be adjusted as necessary by others prior to construction unless the plans specifically call for their adjustment by the Contractor. Existing utilities and their location, as shown on the plans, represent the best information obtainable for design. The Contractor will be required to work around existing utilities within the right-of-way which do not conflict with proposed construction.

3. The Contractor shall be responsible for maintaining continuous flow of sewage through construction. Contractor's proposed method for maintaining sewage flow shall be approved by the Engineer. Cost of maintaining flow of sewage through construction will not be paid for directly and this cost shall be considered as subsidiary to the other pay items of work.

4. The Contractor shall be responsible for preserving property irons. The Contractor will be required to re-establish any property irons which are damaged or destroyed by his construction operations. Such irons shall be re-established by a licensed land surveyor or a licensed professional engineer in accordance with state laws.

5. Contractor to verify the top of manhole elevation and the need for service line stubs prior to construction. Contact Dan Lies at 942-9592.

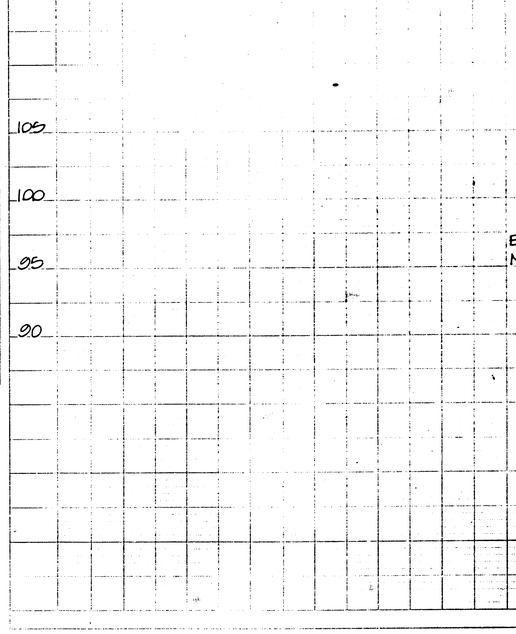

APPROVED AS NOTED
By CITY ENGINEER OF WICHITA.

Sanitary Sewers [signature] 2-11-90

Storm Sewers _____

Driveway Approaches _____

Water Mains _____

Paving _____

NOTE TO CONTRACTOR

INSPECTION AND TESTING FOR THIS PROJECT IS TO BE PROVIDED BY A LICENSED CONSULTING ENGINEERING FIRM UNDER CONTRACT WITH THE OWNER/DEVELOPER. SAID INSPECTION TO BE IN ACCORDANCE WITH THE CITY OF WICHITA STANDARD CONSTRUCTION ENGINEERING PRACTICES AND CERTIFIED BY A LICENSED PROFESSIONAL ENGINEER. NO WORK SHALL BE PERFORMED IN DEDICATED EASEMENTS OR PUBLIC RIGHT-OF-WAY BY THE CONTRACTOR WITHOUT SUCH INSPECTION NOR SHALL ANY WORK BE COMMENCED WITHOUT WRITTEN AUTHORIZATION BY THE CITY ENGINEER.

Revised as built 10-8-90 TCR

M. BRENT WOOTEN LICENSED 0470 KANSAS PROFESSIONAL ENGINEER

Aug 1990

PRIVATE SANITARY SEWER EXTENSION TO SERVE S. 300' OF LOT 1, BLK. 1, WESTPORT INDUSTRIAL PARK FIRST ADDN.

CITY OF WICHITA, KS

PROJECT NO. 259 PPS 607861

BAUGHMAN COMPANY, P.A.
SURVEYING & ENGINEERING
316/262-7271 • 315 ELLIS • WICHITA, KANSAS 67211


1/1 1/2

HIGHWAY FEDERAL AID SHEET
PLATE 1-SINGLE PLAN AND PROFILE-FULL LINE
KANSAS TELEDYNE
PRINTED IN U.S.A.

FILMED FROM THE BEST AVAILABLE COPY

BENCH MARK: City Disc @ Pawnee and Sheridan, Elev = 103.29 City Datum

"X" Cut on High Edge West Side of Sheridan 10' South Line of Lot 1, Block 1, Westport Industrial Park First Addition = 102.68

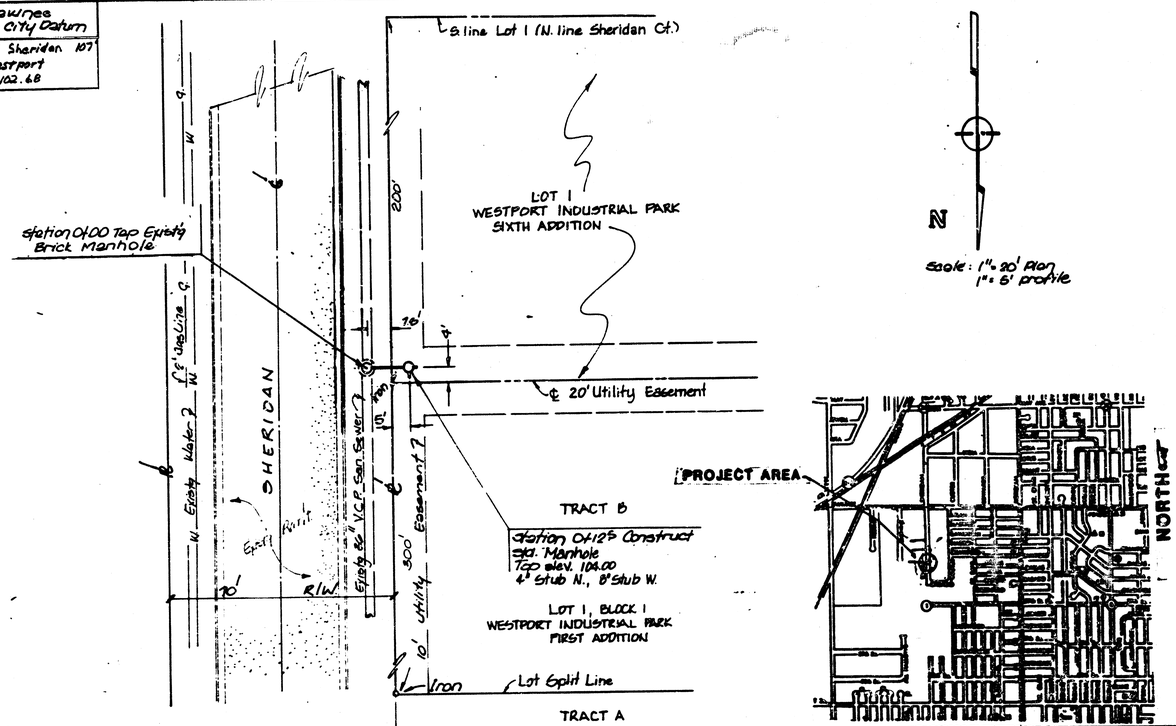

GENERAL NOTES

1. Contractor will be required to provide a minimum advance notice of twenty-four (24) hours to utility companies prior to starting any excavation as follows:

Kansas One-Call	1-800-344-7233

The Contractor must notify the following in case of an emergency:

Cable vision	262-4270 or 263-2061
K.P.& L. Gas Service Company	263-7511
Kansas Gas & Electric	264-1161
Arkla Gas Company	942-8350 or 263-8121
Southwest Bell Telephone Company	1-571-2611
City of Wichita Water Department	268-4908
City of Wichita Sewer Maintenance	268-4071

2. Underground utility service lines and overhead utility pole lines are to be adjusted as necessary by others prior to construction unless the plans specifically call for their adjustment by the Contractor. Existing utilities and their location, as shown on the plans, represent the best information obtainable for design. The Contractor will be required to work around existing utilities within the right-of-way which do not conflict with proposed construction.

3. The Contractor shall be responsible for maintaining continuous flow of sewage through construction. Contractor's proposed method for maintaining sewage flow shall be approved by the Engineer. Cost of maintaining flow of sewage through construction will not be paid for directly and this cost shall be considered as subsidiary to the other pay items of work.


4. The Contractor shall be responsible for preserving property irons. The Contractor will be required to re-establish any property irons which are damaged or destroyed by his construction operations. Such irons shall be re-established by a licensed land surveyor or a licensed professional engineer in accordance with state laws.

5. Contractor to verify the top of manhole elevation and the need for service line stubs prior to construction. Contact Dan Lies @ 942-9592.

APPROVED AS NOTED
BY CITY ENGINEER OF WICHITA
SANITARY SEWER
Storm Sewers
Driveway Approaches
Water Mains
Paving

NOTE TO CONTRACTOR

INSPECTION AND TESTING FOR THIS PROJECT IS TO BE PROVIDED BY A LICENSED CONSULTING ENGINEERING FIRM UNDER CONTRACT WITH THE OWNER/DEVELOPER. SAID INSPECTION TO BE IN ACCORDANCE WITH THE CITY OF WICHITA STANDARD CONSTRUCTION SPECIFICATIONS. INSPECTION AND CERTIFICATION BY A LICENSED PROFESSIONAL ENGINEER. NO WORK SHALL BE PERFORMED IN DEVELOPMENT OR DEDICATED OR PUBLIC RIGHT-OF-WAY OF THE CITY OF WICHITA WITHOUT SUCH INSPECTION BEING MADE. ANY WORK AS CONSTRUCTED WITHOUT WRITTEN AUTHORIZATION BY THE CITY SHALL BE REMOVED.

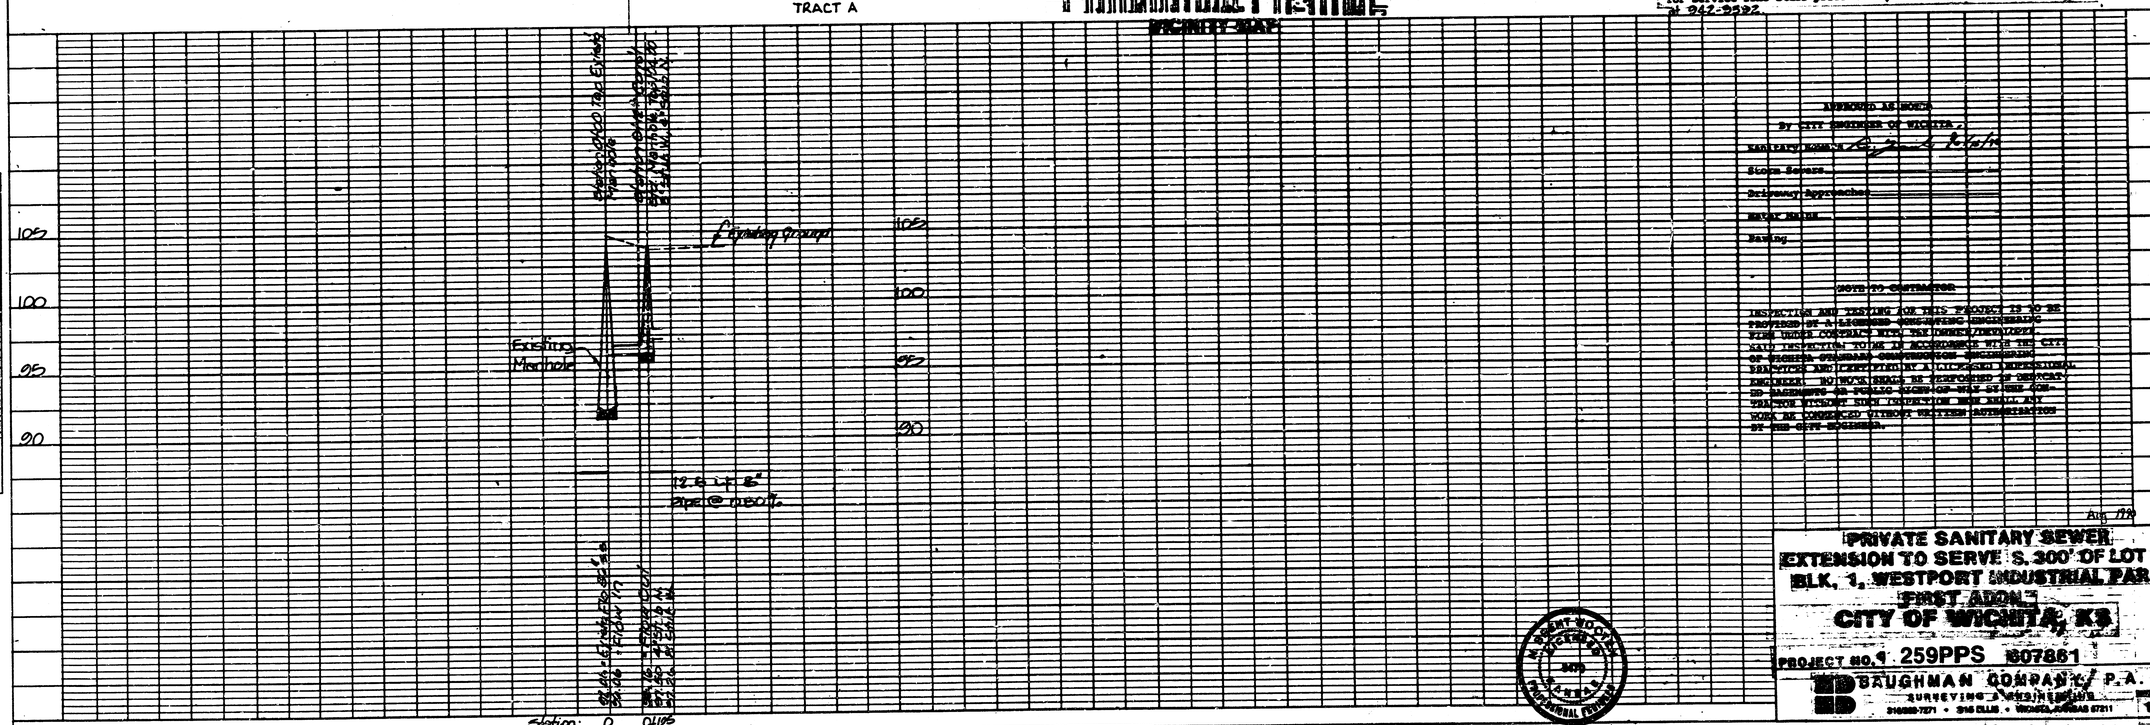

PRIVATE SANITARY SEWER EXTENSION TO SERVE S. 300' OF LOT 1, BLK. 1, WESTPORT INDUSTRIAL PARK FIRST ADDN.
CITY OF WICHITA, KS

PROJECT NO. 259PPS 607861

BAUGHMAN COMPANY, P.A.
SURVEYING • ENGINEERING
316/686-7271 • 245 ELLIS • WICHITA, KANSAS 67211

SCALE 1" = 5'

PLATE 1-SINGLE PLAN AND PROFILE-1-FULL LINE
WILSONS

PLAN: SURVEYED, DATE, NOTE BOOK, ALIGNMENT CHECKED, No., BY, W.O. NO. CHECKED, BY

PROFILE: SURVEYED, DATE, NOTE BOOK, ALIGNMENT CHECKED, No., BY, W.O. NO. CHECKED, BY, HORIZONTAL EXAGGERATION CHECKED

FILMED FROM THE BEST AVAILABLE COPY