


North

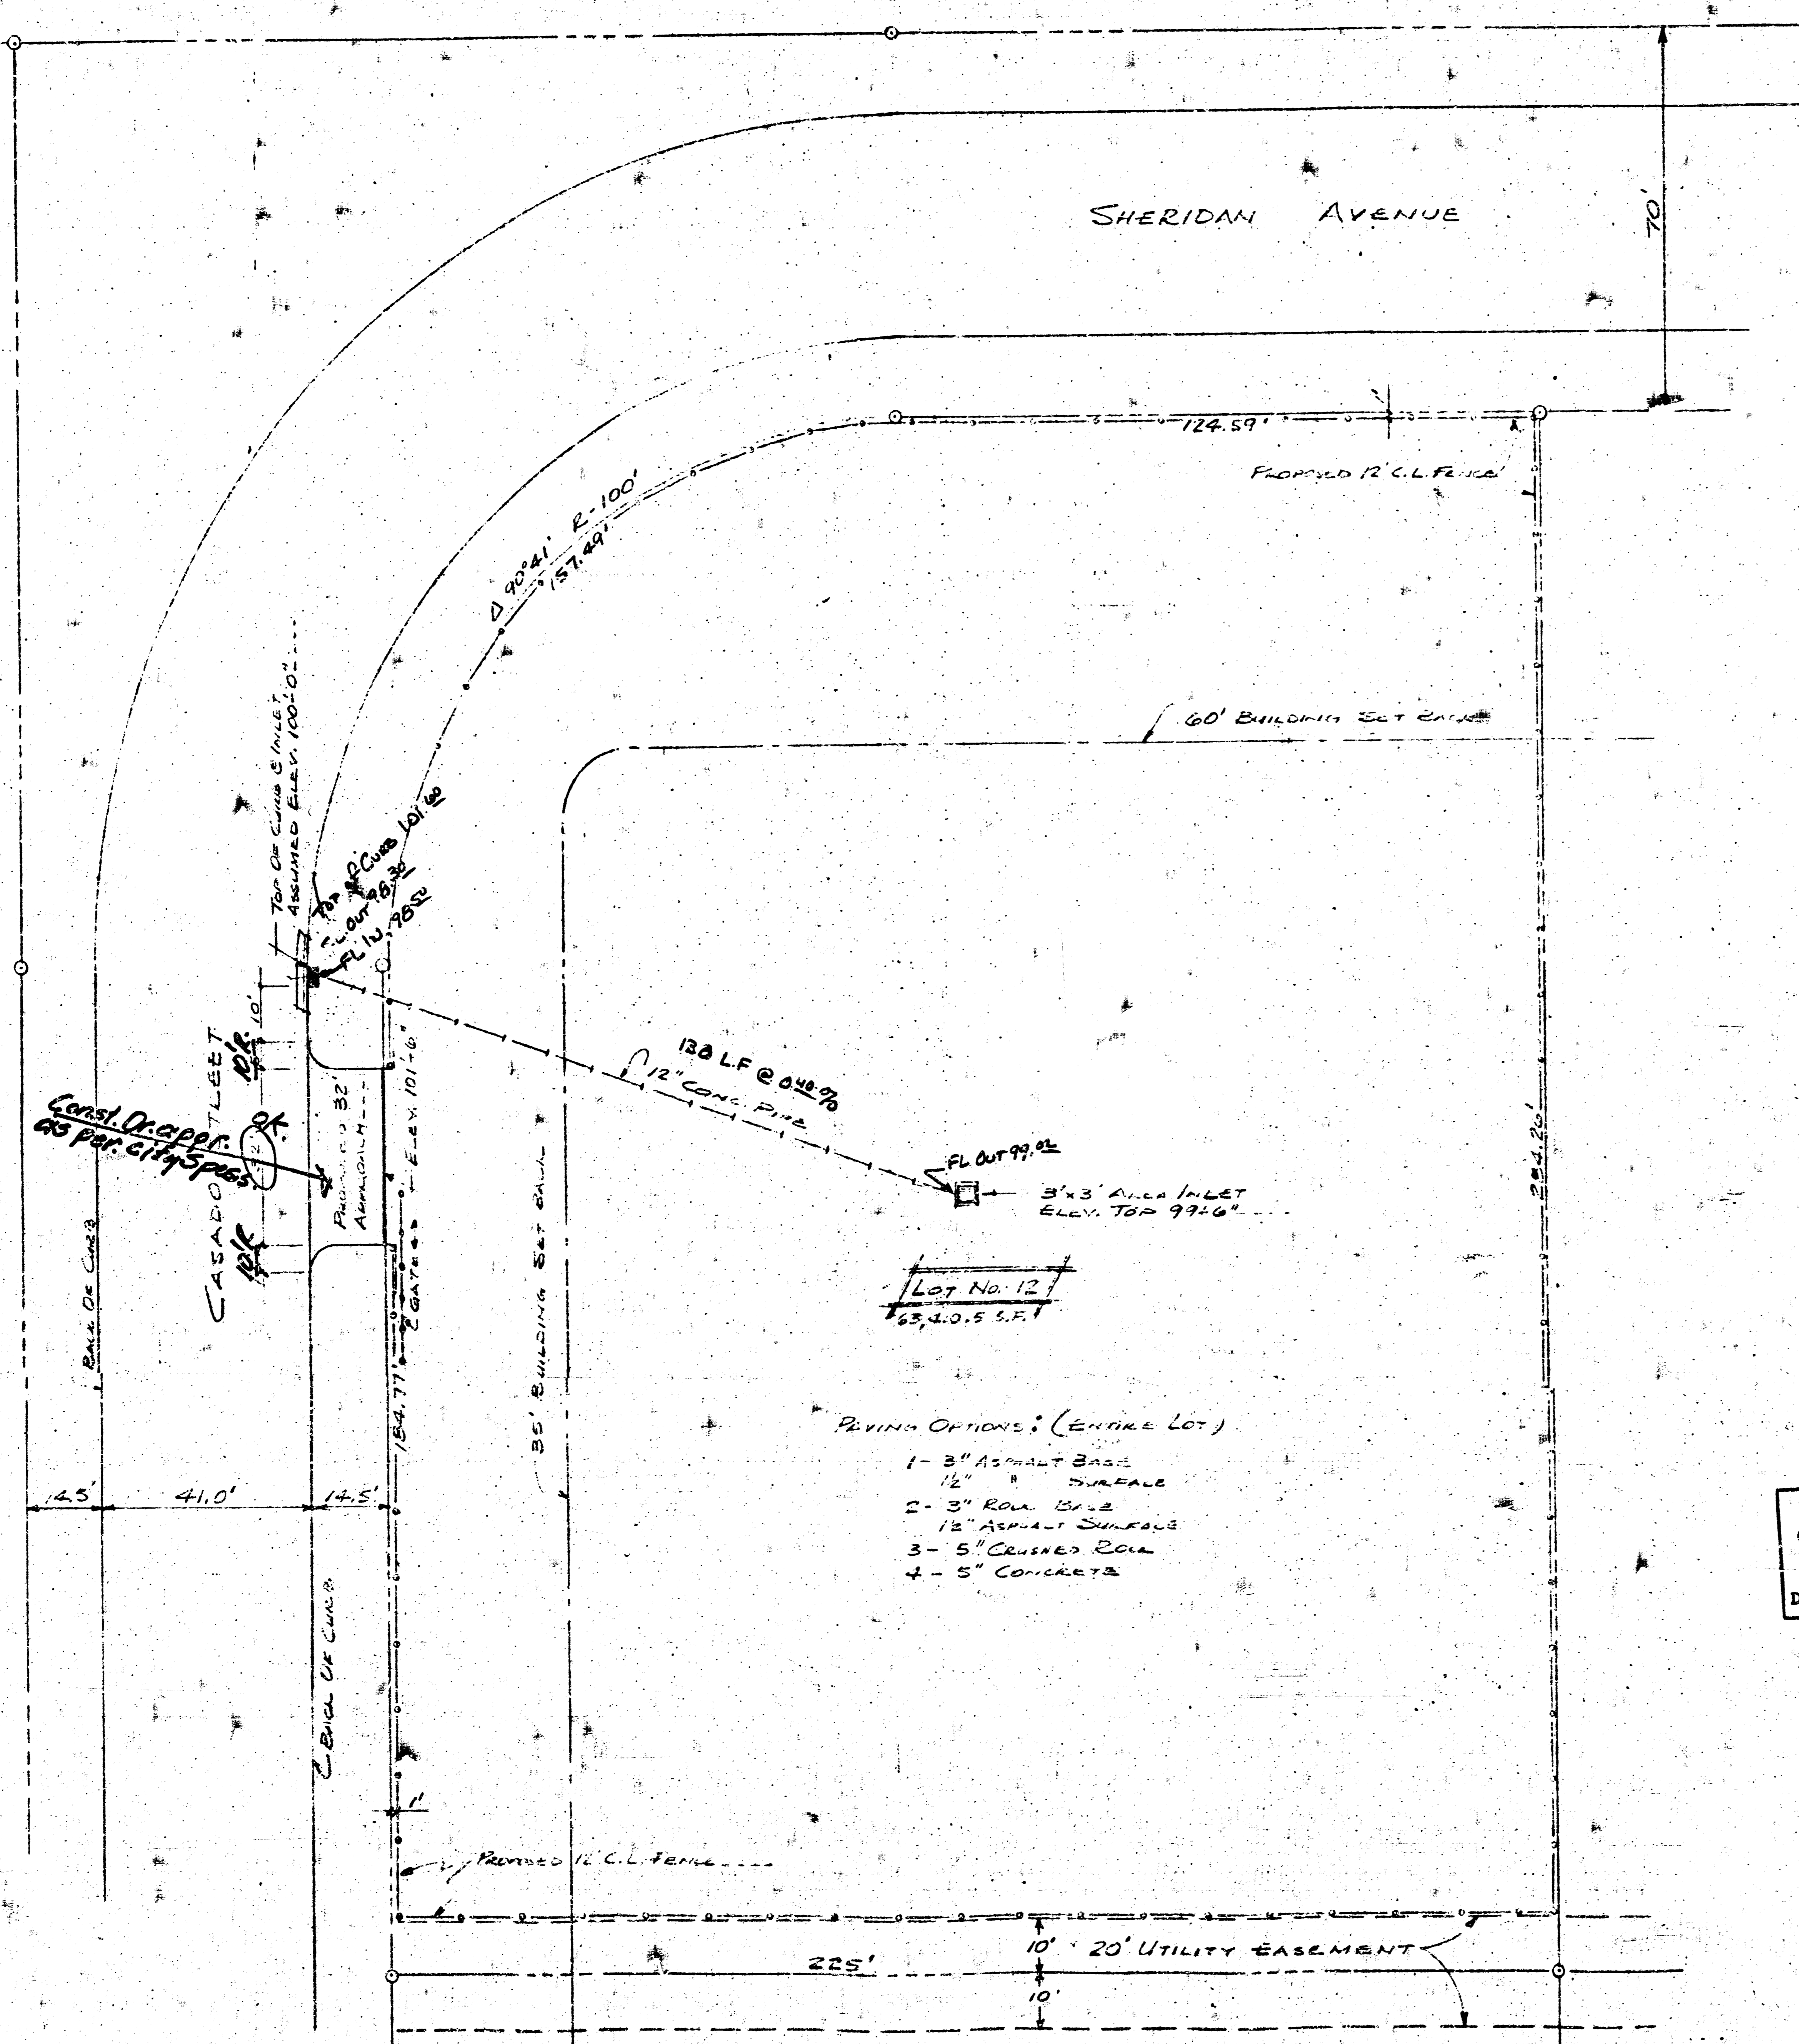

Lot No. 12
63,40.5 S.F.

- PAVING OPTIONS: (ENTIRE LOT)
- 1 - 3" ASPHALT BASE
12" SURFACE
 - 2 - 3" ROAD BASE
12" ASPHALT SURFACE
 - 3 - 5" CRUSHED ROCK
 - 4 - 5" CONCRETE

6-20-75
APPROVED AS NOTED
By CITY ENGINEER OF WICHITA
Sanitary Sewers _____
Storm Sewers D.S.I.
Driveway Approaches _____

APPROVED
CENTRAL INSPECTION DIVISION
CITY OF WICHITA
Date 6-16-75 By R. J. [Signature]

APPROVED AS NOTED
By CITY ENGINEER OF WICHITA
Sanitary Sewers _____
Storm Sewers _____
Driveway Approaches _____

City Proj. # DW 705 017
Approved WDM 6-16-75