
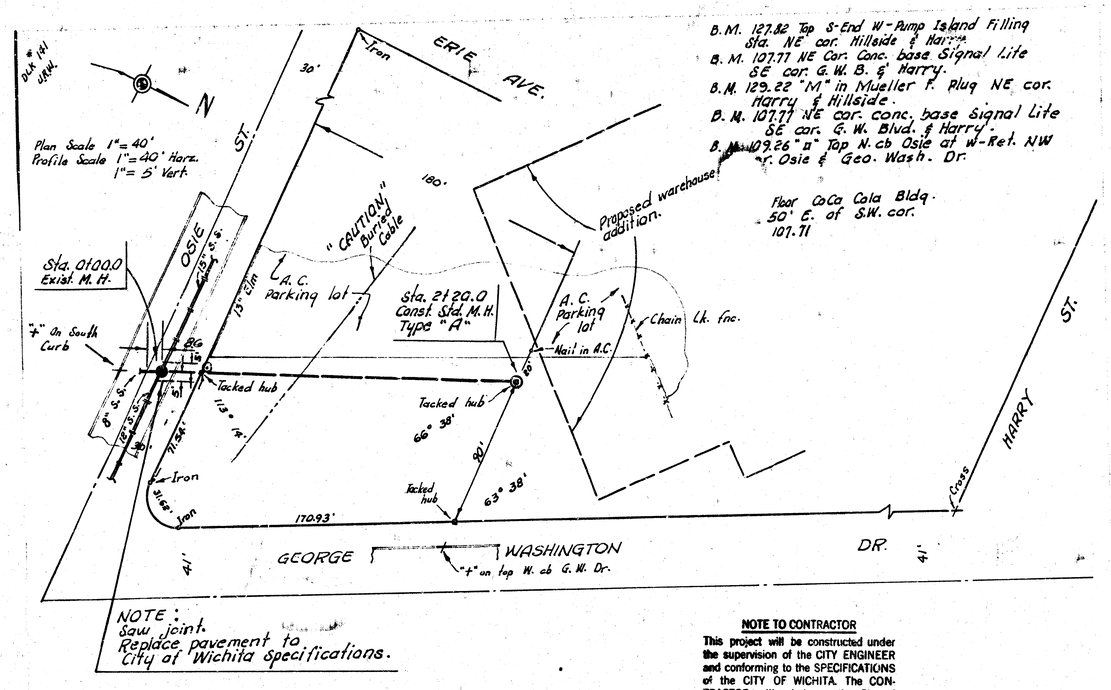


NOTE:
Saw joint.
Replace pavement to City of Wichita Specifications.

NOTE TO CONTRACTOR

This project will be constructed under the supervision of the CITY ENGINEER and conforming to the SPECIFICATIONS of the CITY OF WICHITA. The CONTRACTOR will reimburse the City of Wichita for all cost of Engineering, Plans, and Inspection.

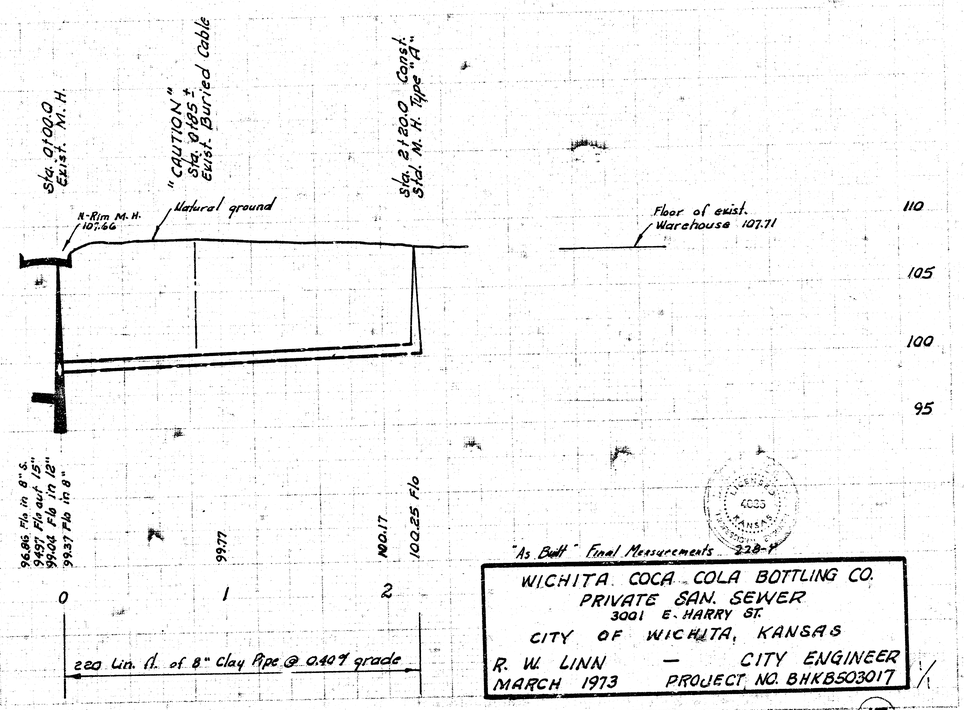

"As Built" Final Measurements 228-Y

WICHITA COCA-COLA BOTTLING CO.
PRIVATE SAN. SEWER
3001 E. HARRY ST.
CITY OF WICHITA, KANSAS
R. W. LINN — CITY ENGINEER
MARCH 1973 PROJECT NO. BHKB503017

FILMED FROM THE BEST