LATERAL 5, DISTRICT I, WAR INDUSTRIES SEWER

WICHITA , KANSAS
1950

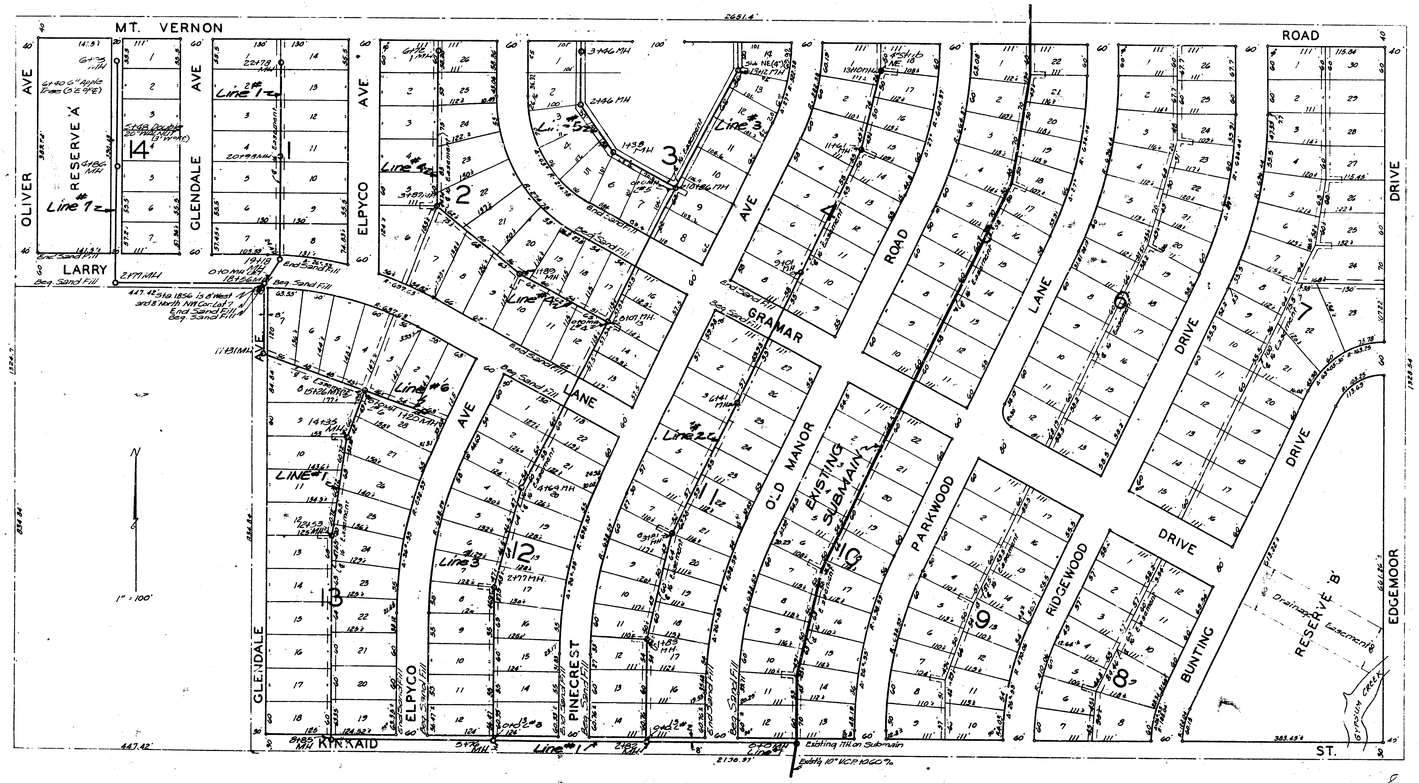

SHT. 1/2

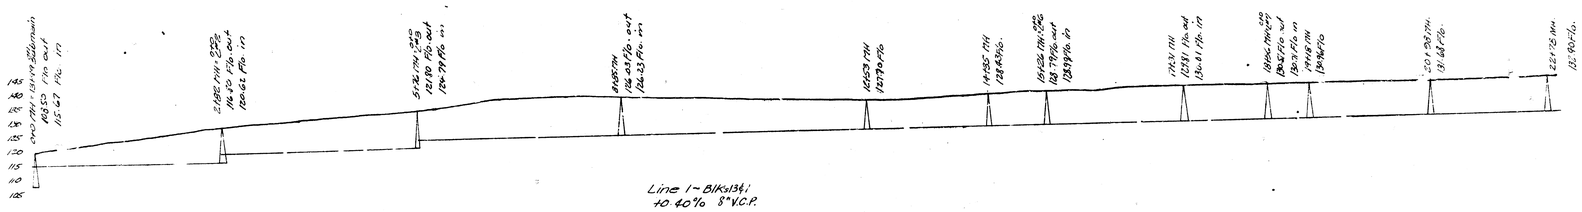

Line 1 - Blk's 13 & 14
10.40% 8" V.C.P.

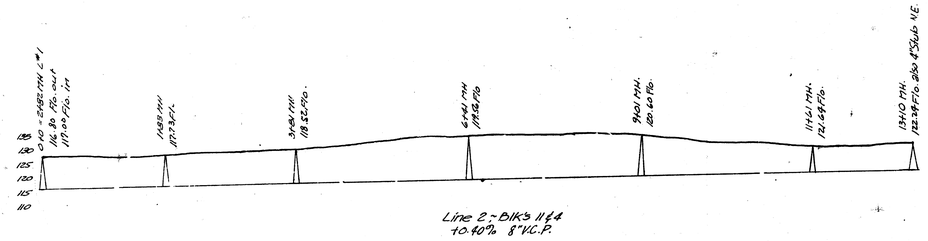

Line 2 - Blk's 11 & 4
10.40% 8" V.C.P.

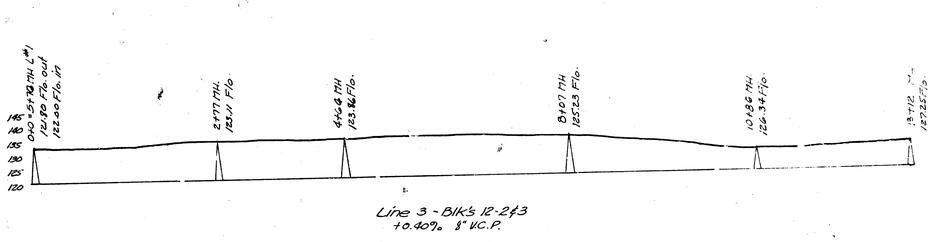

Line 3 - Blk's 12-2 & 3
10.40% 8" V.C.P.

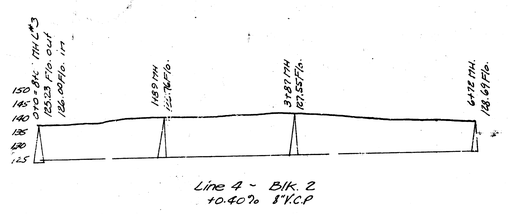

Line 4 - Blk. 2
10.40% 8" V.C.P.

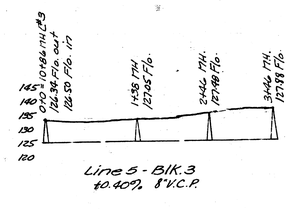

Line 5 - Blk. 3
10.40% 8" V.C.P.

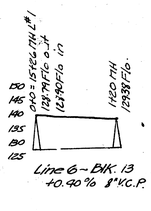

Line 6 - Blk. 13

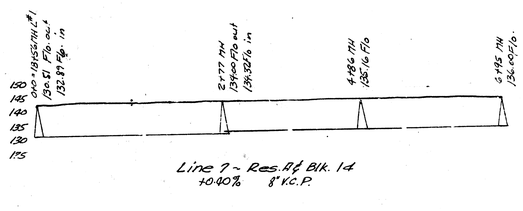

Line 7 - Res. A & Blk. 14
10.40% 8" V.C.P.



DETAIL for TAMPED BACKFILL

Note -
Ditches over 13' in depth, to be Tamped Backfill

LAT. 8, SUBMAIN 1, WAR INDUSTRIES SEWER
CITY OF WICHITA KANSAS
L. K. WHITE — CITY ENGINEER
DATE: 4-6-51, PROJ. NO. C21-3

LAT. 5, DIST. 1, War Industries Sewer

PROFILE'S FOR EDGEWOOD ADDITION
City of Wichita, Kansas
L.K. White — City Engineer.
Date: 3-2-50 C 20-4

SHT. 2/2

Revised 1-C-1950