
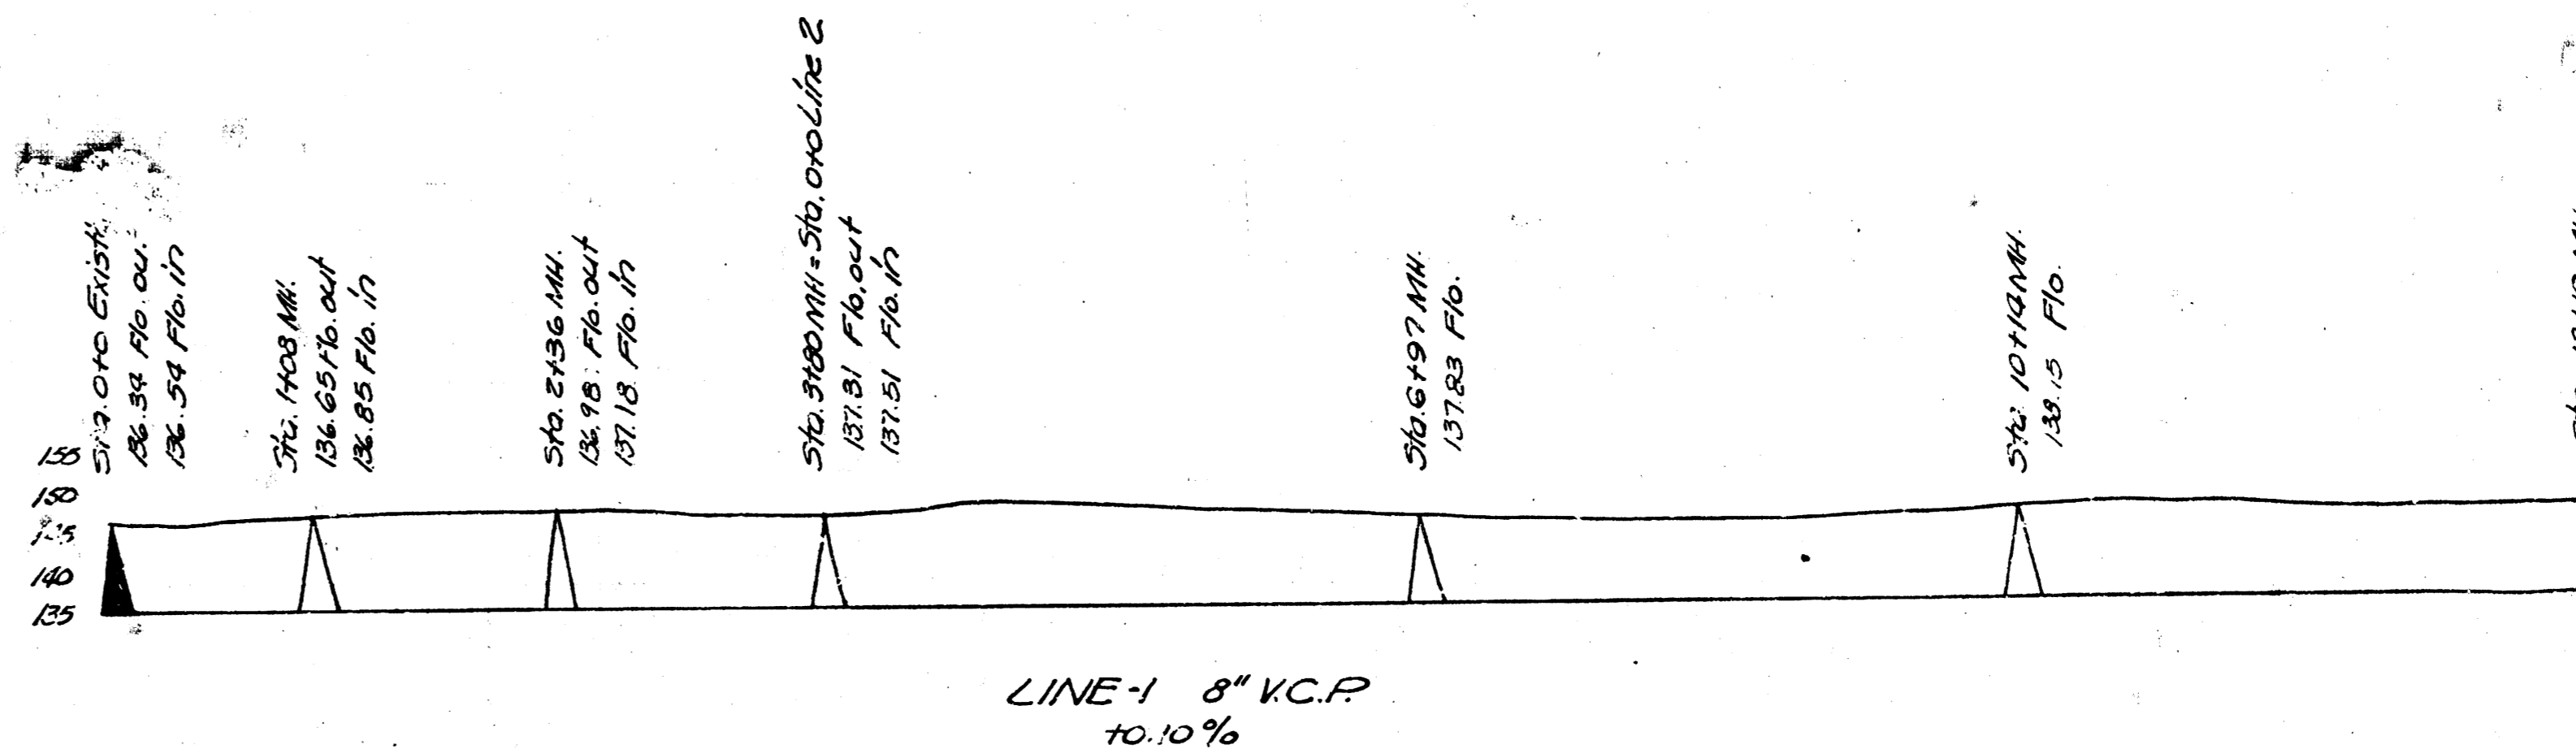


B.M. "M" in Mueller Fire Plug N.E. Cor. Elipco & Rindon Elev. 150.58

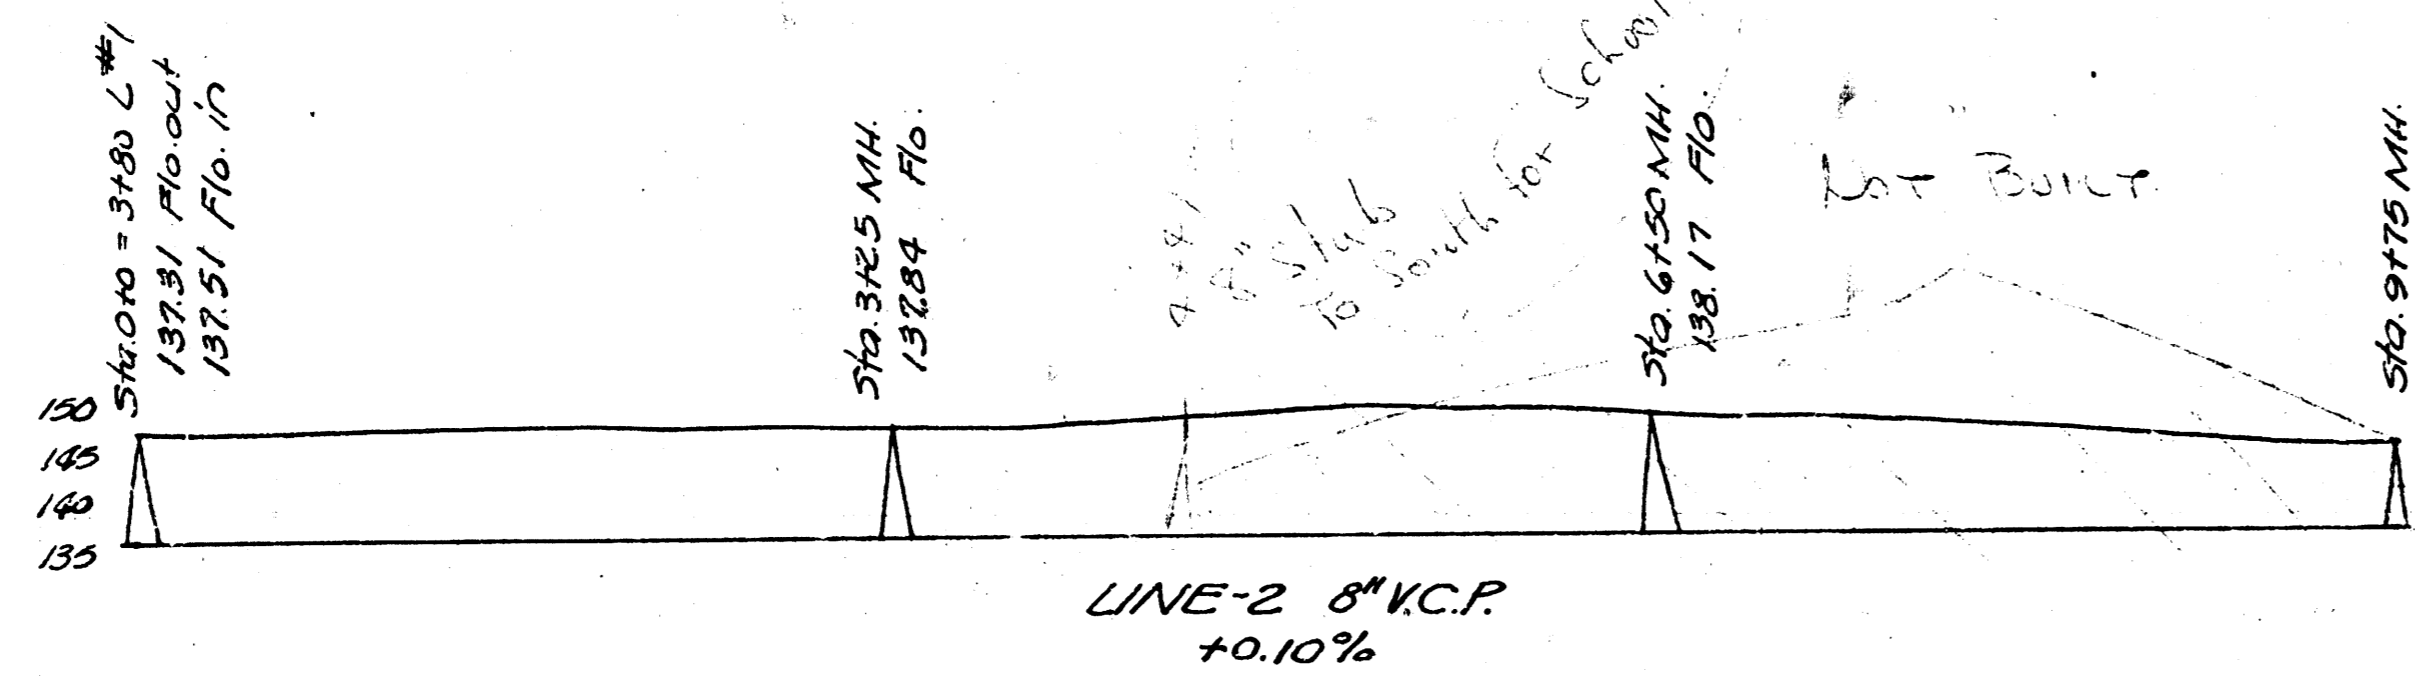

LAT. 6, DIST. 1, WAR INDUSTRIES SEWER  
 City of Wichita, Kansas  
 L.K. WHITE City Engineer  
 Date: 10-6-50 Proj. No. C20-35