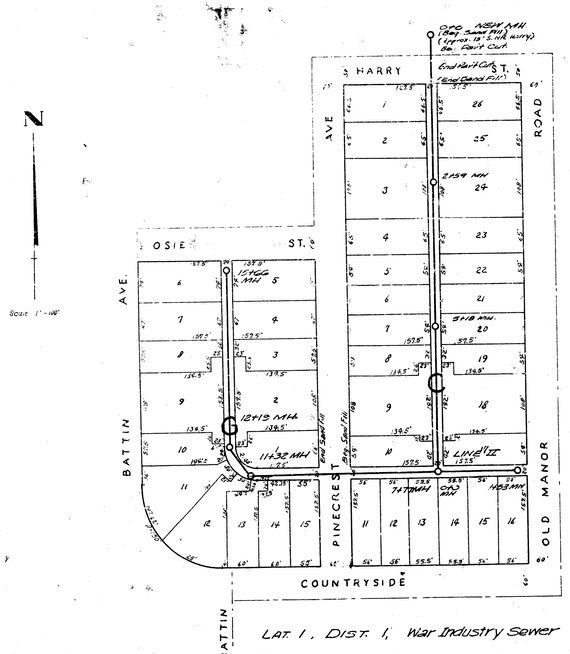

LAT. 1, DIST. 1, War Industry Sewer

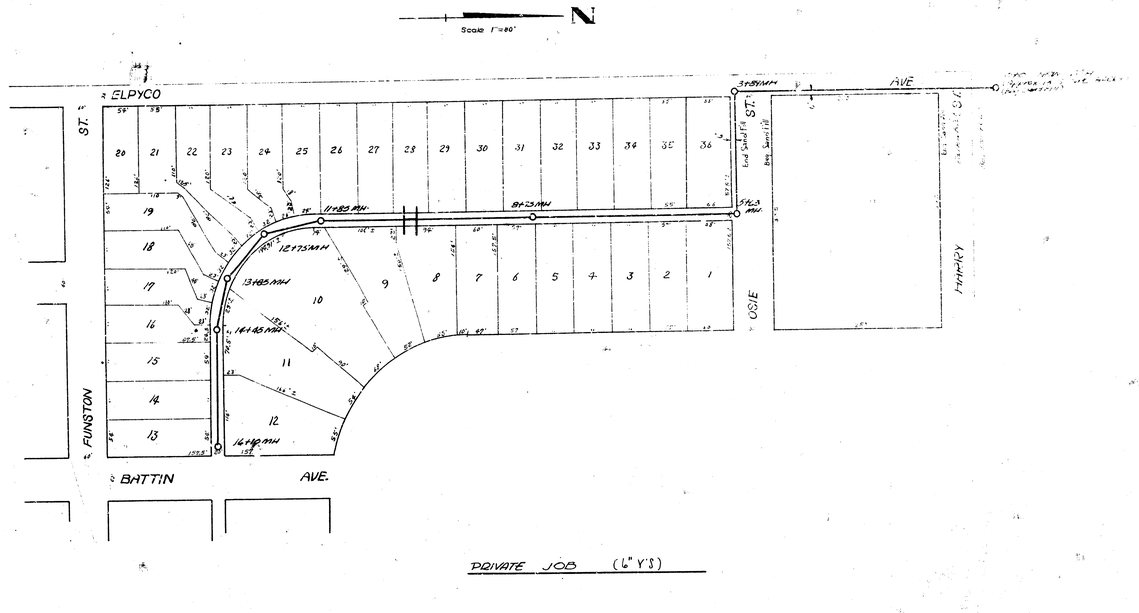

PRIVATE JOB (6" V'S)

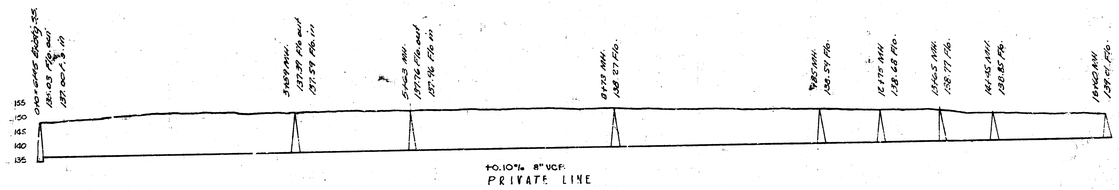

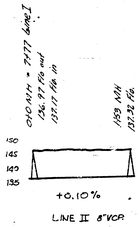

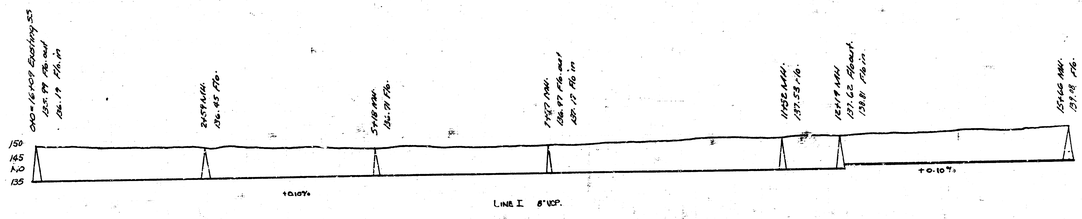

LAT. 1, DIST. 1, W.I.S.

PRIVATE JOB - RES. H
LAT. 1, DIST. 1, WAR INDUSTRY SEWER.

CITY OF WICHITA - KANSAS

L. K. WHITE - CITY ENGINEER

Date: 9-20-43 PROJ. NO. - C27-34