
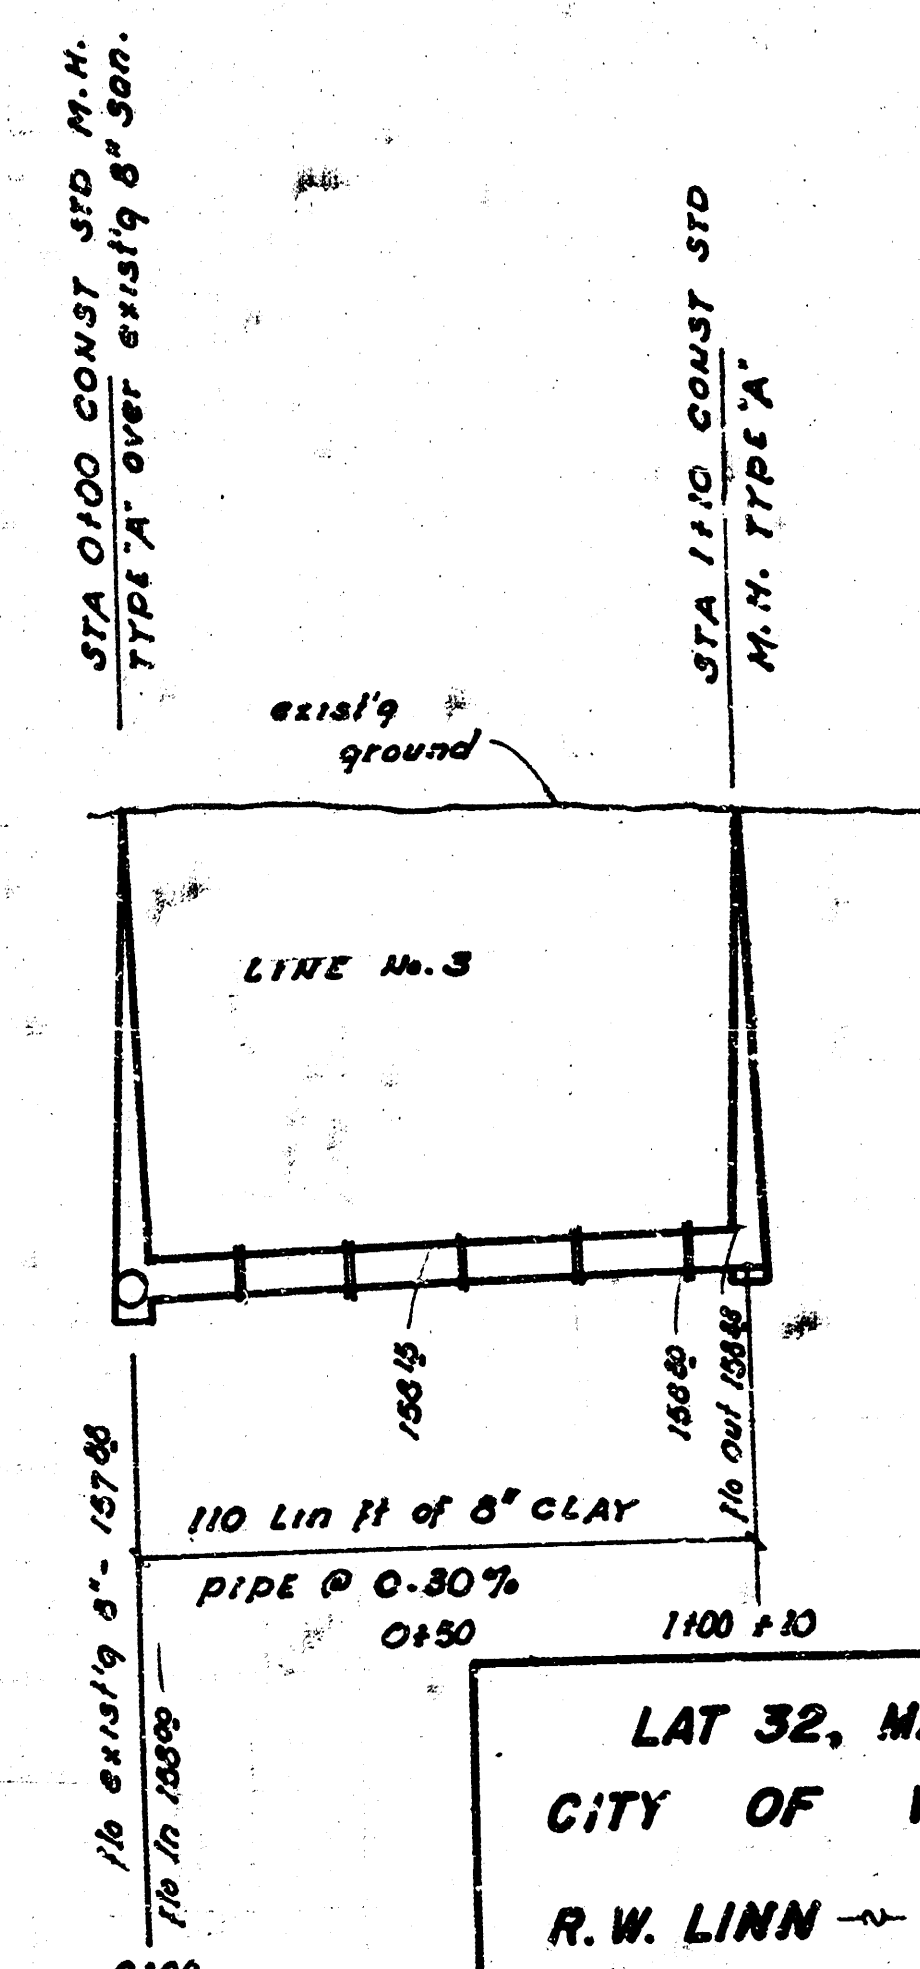
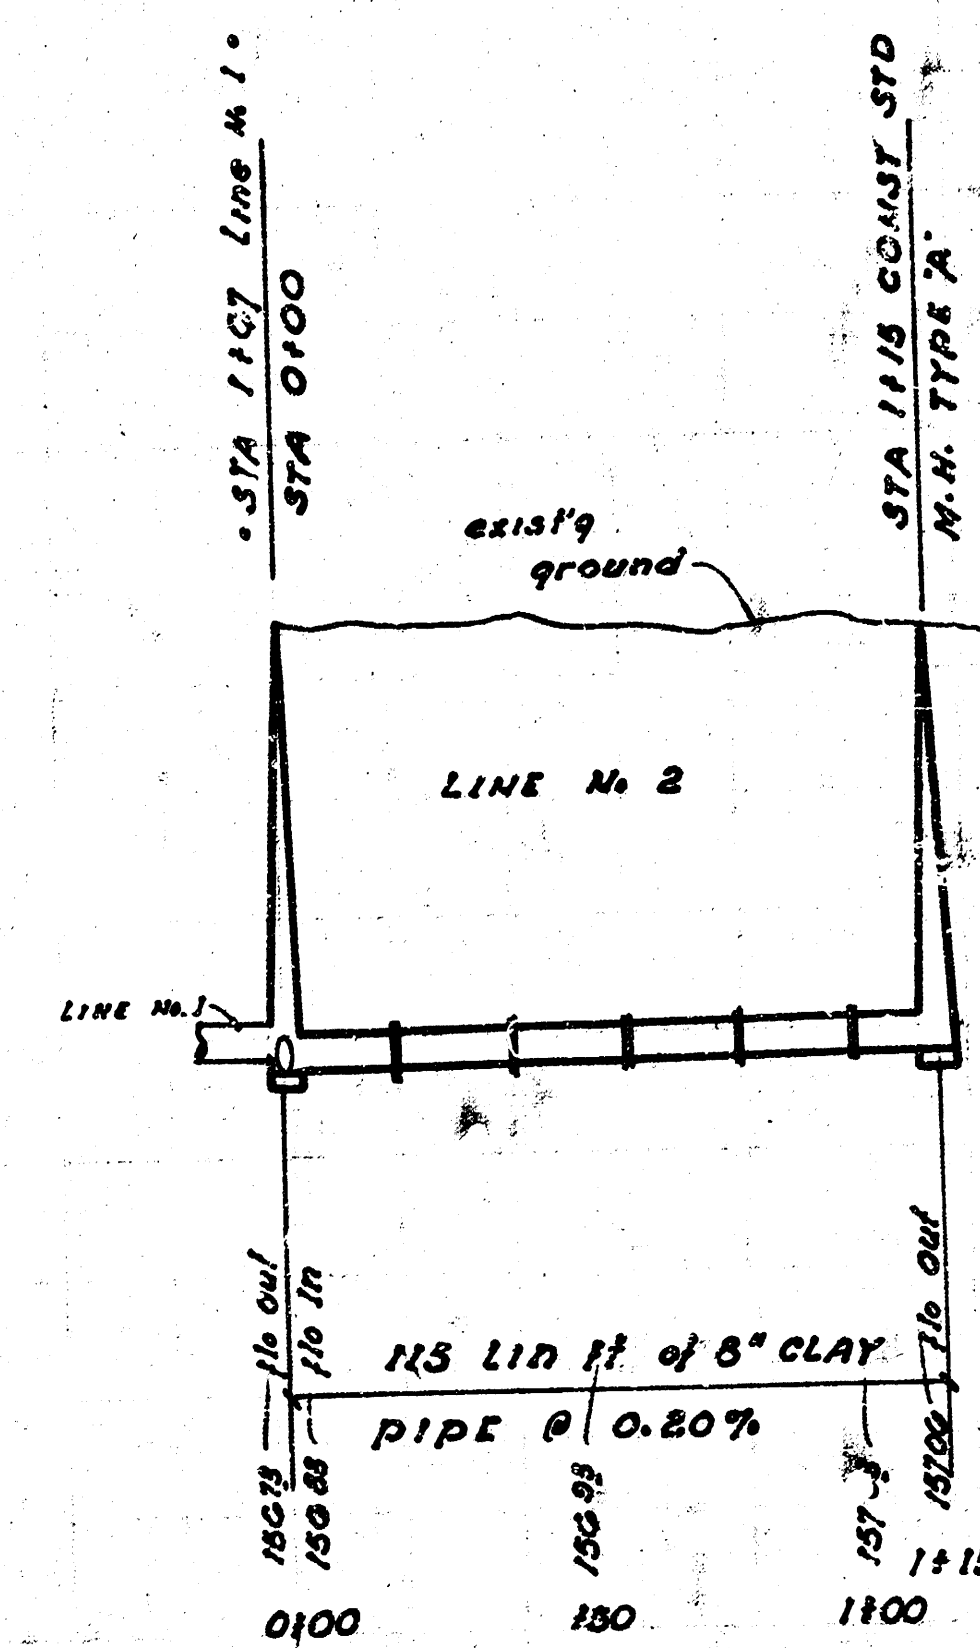
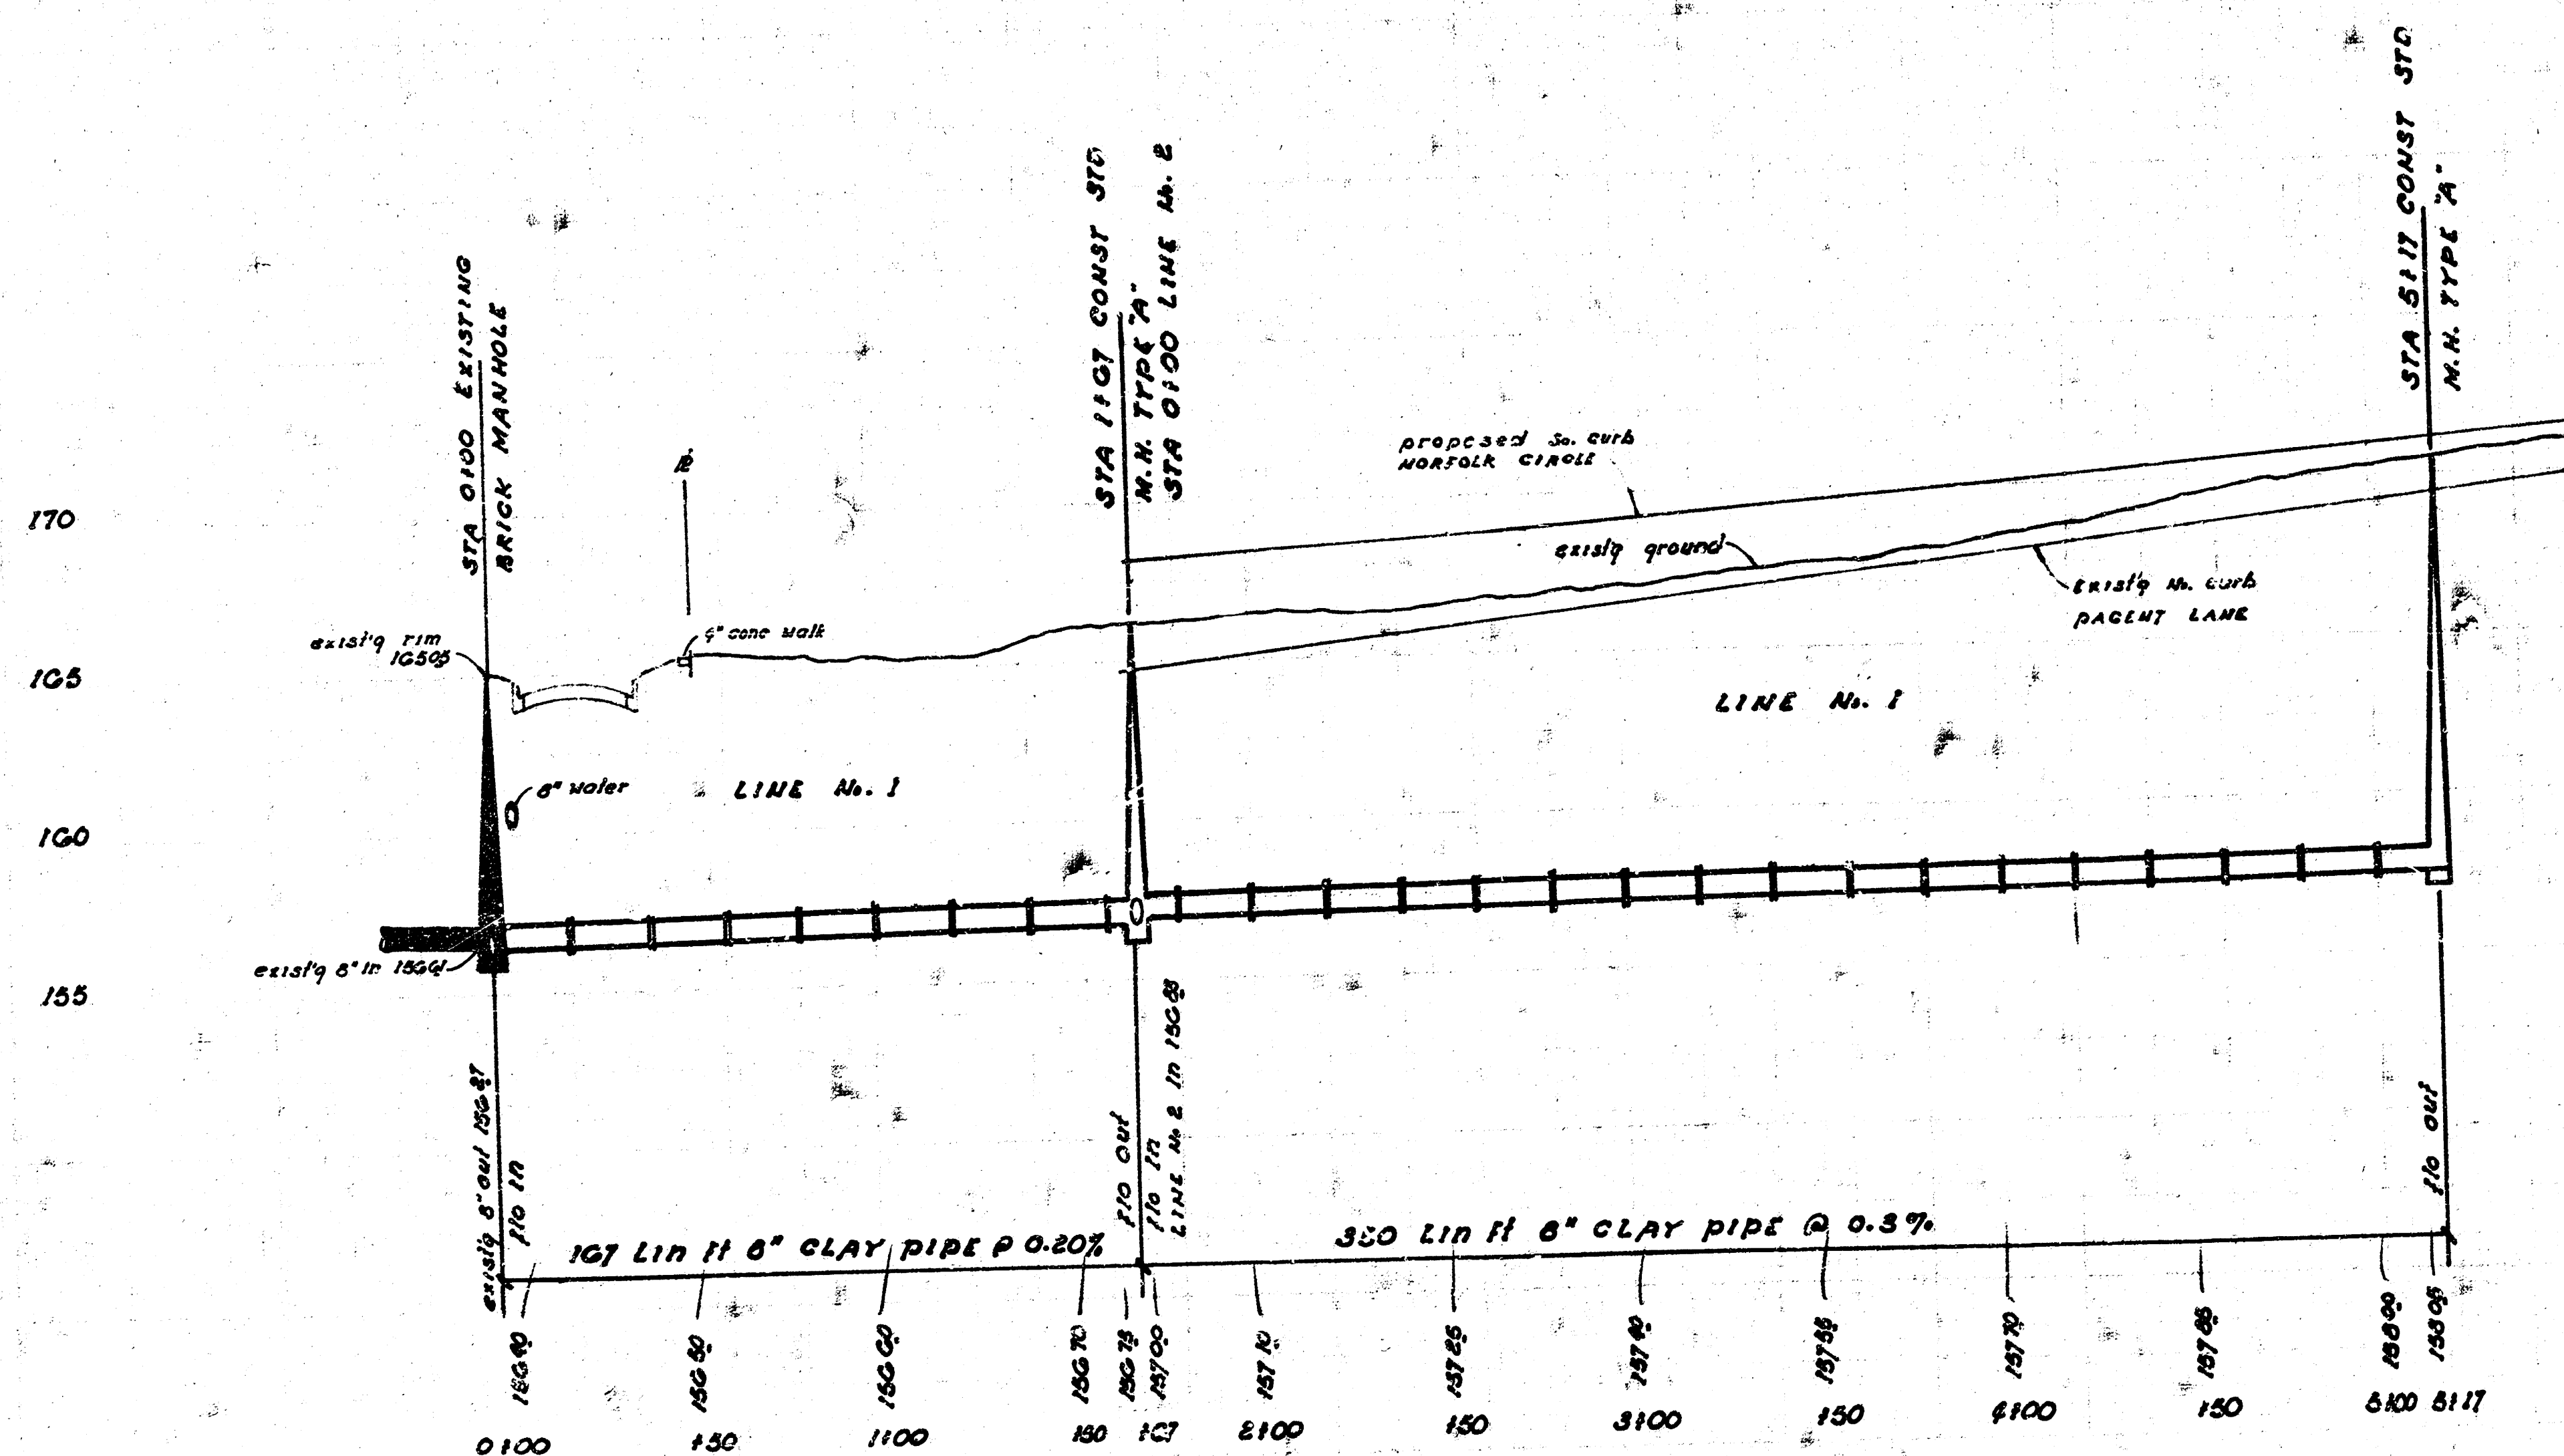


B.M. 151² CITY STANDARD & ARMOUR and CENTRAL
 B.M. 174³ N.E. corner conc porch 16² 251 POSTOAK ROAD.
 B.M. 193⁵ S.E. corner conc step on the back side 16² 240 PENROSE.

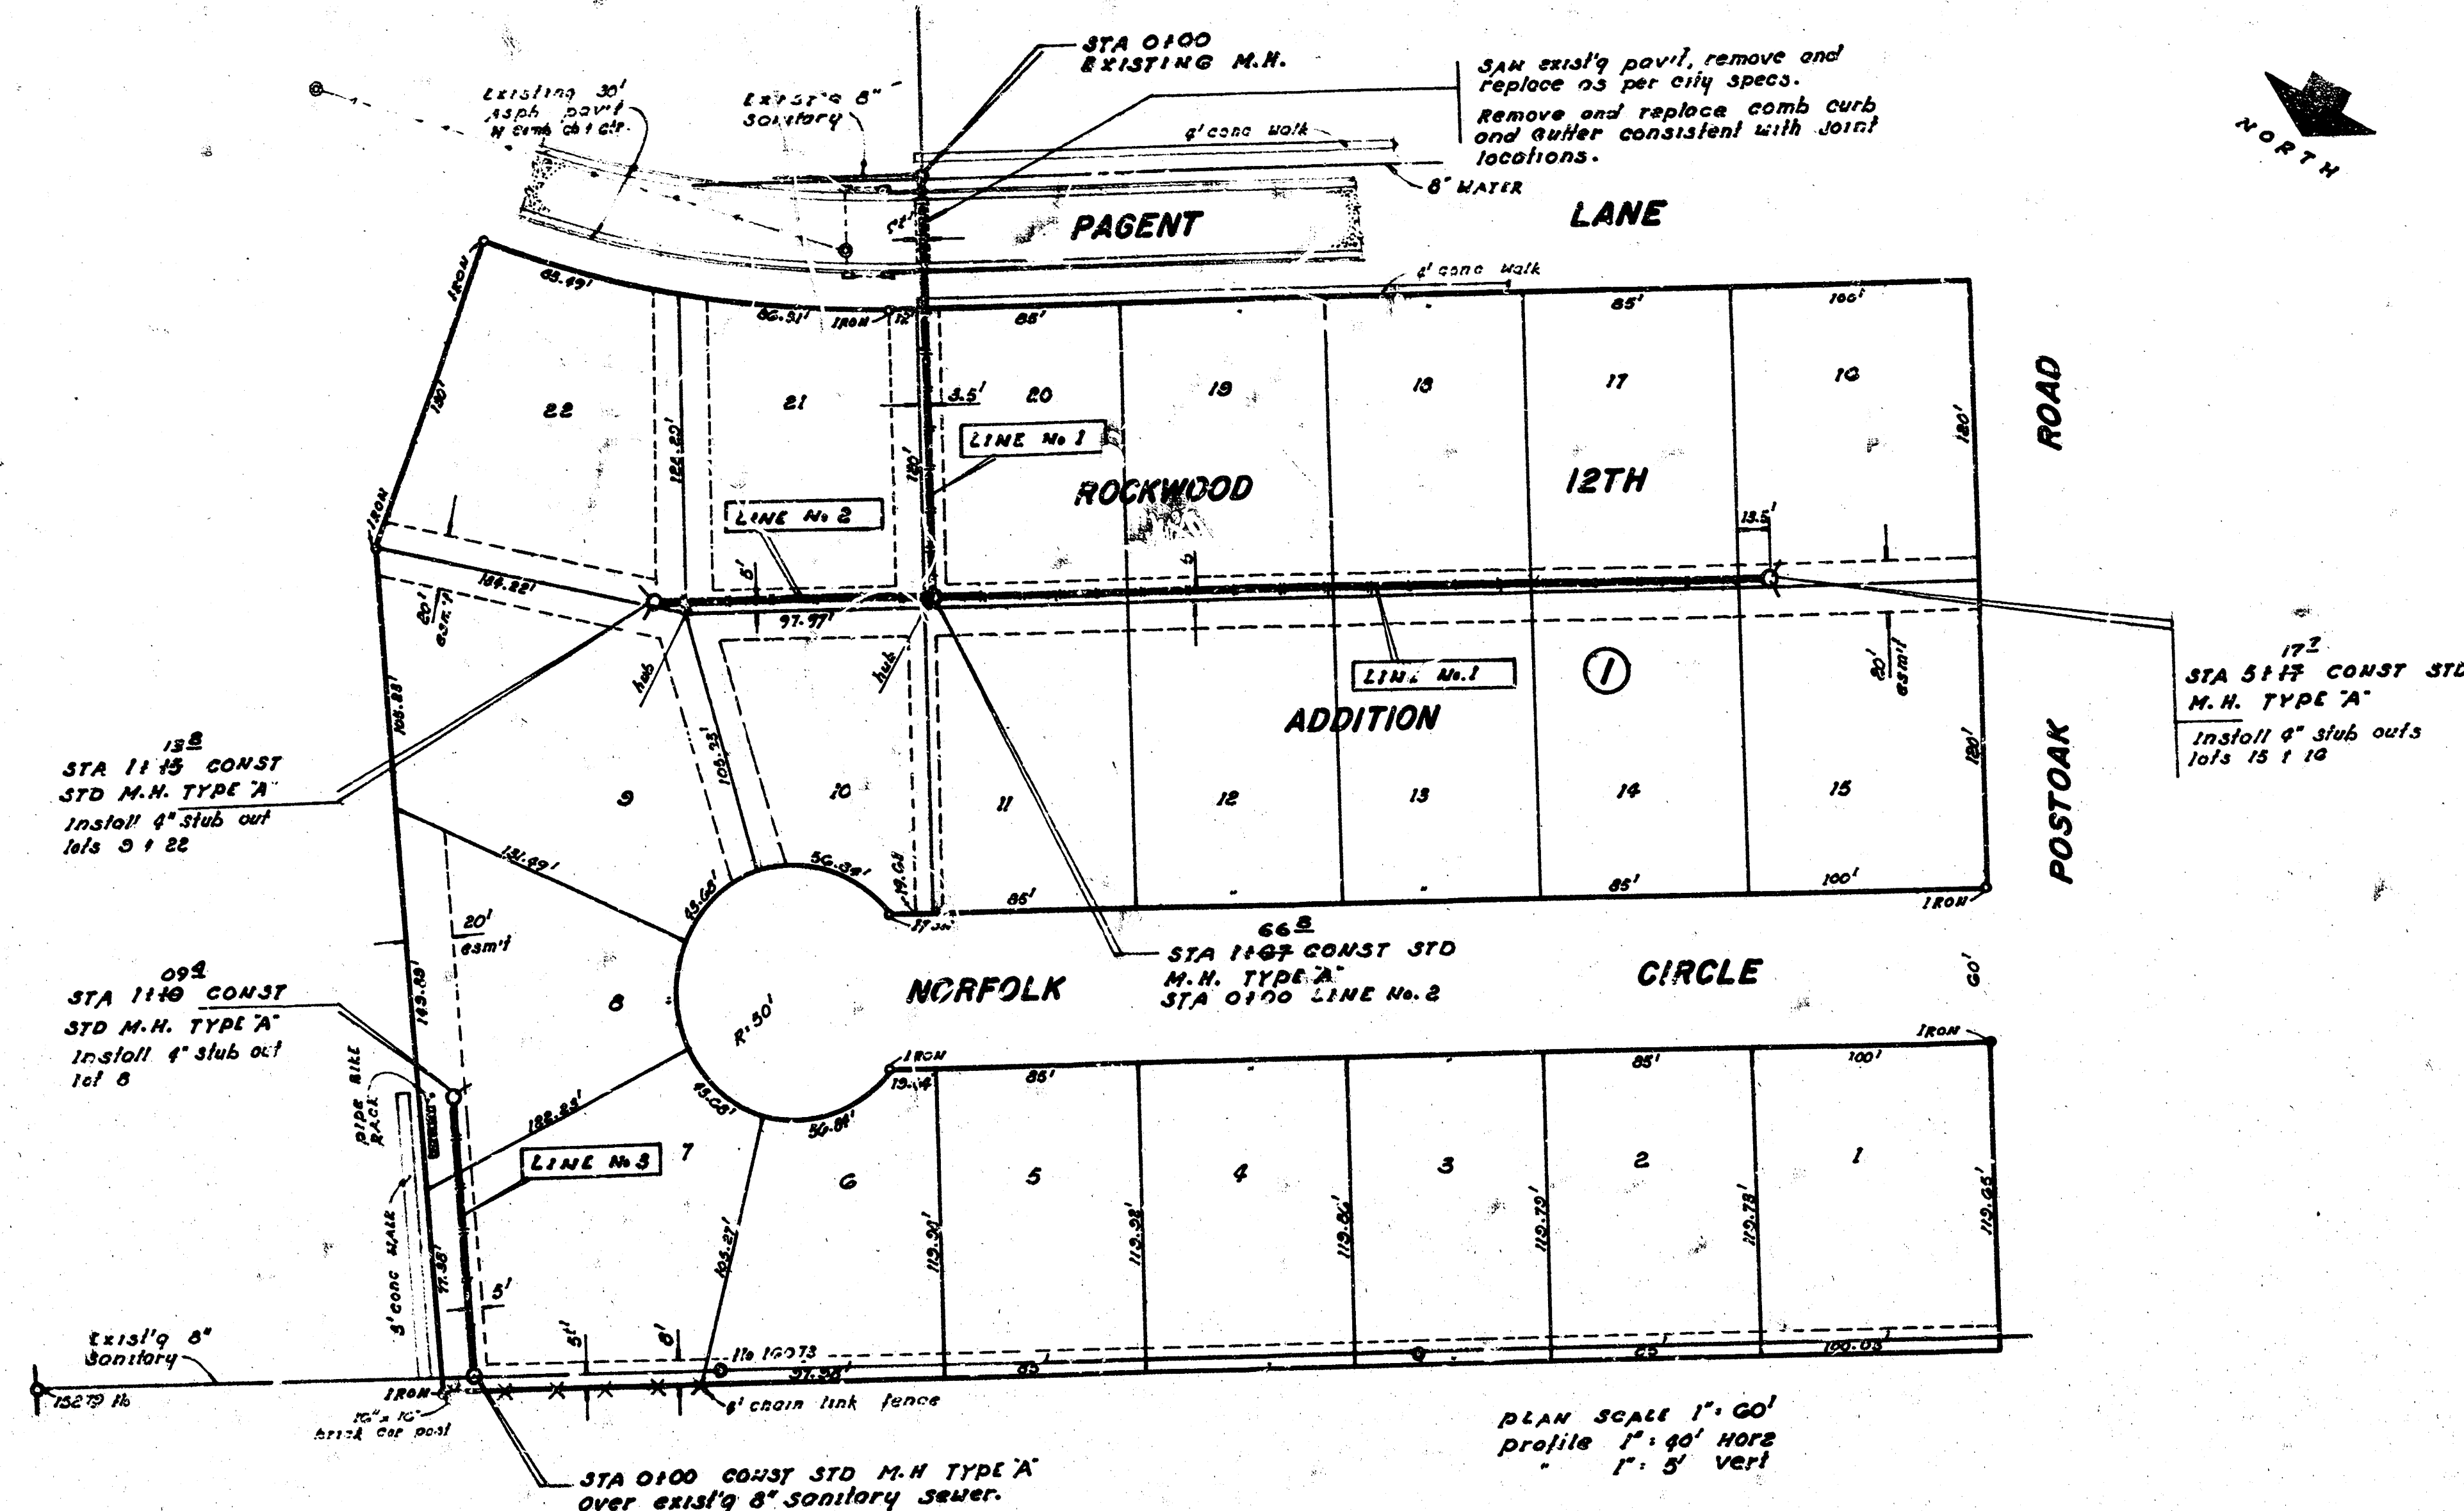

LAT 32, MAIN 5A, W.I.S.
 CITY OF WICHITA, KANSAS
 R.W. LINN - CITY ENGINEER
 Date 11-1-40 Proj No. DBKL573086