


MURRAY'S 2ND ADDITION

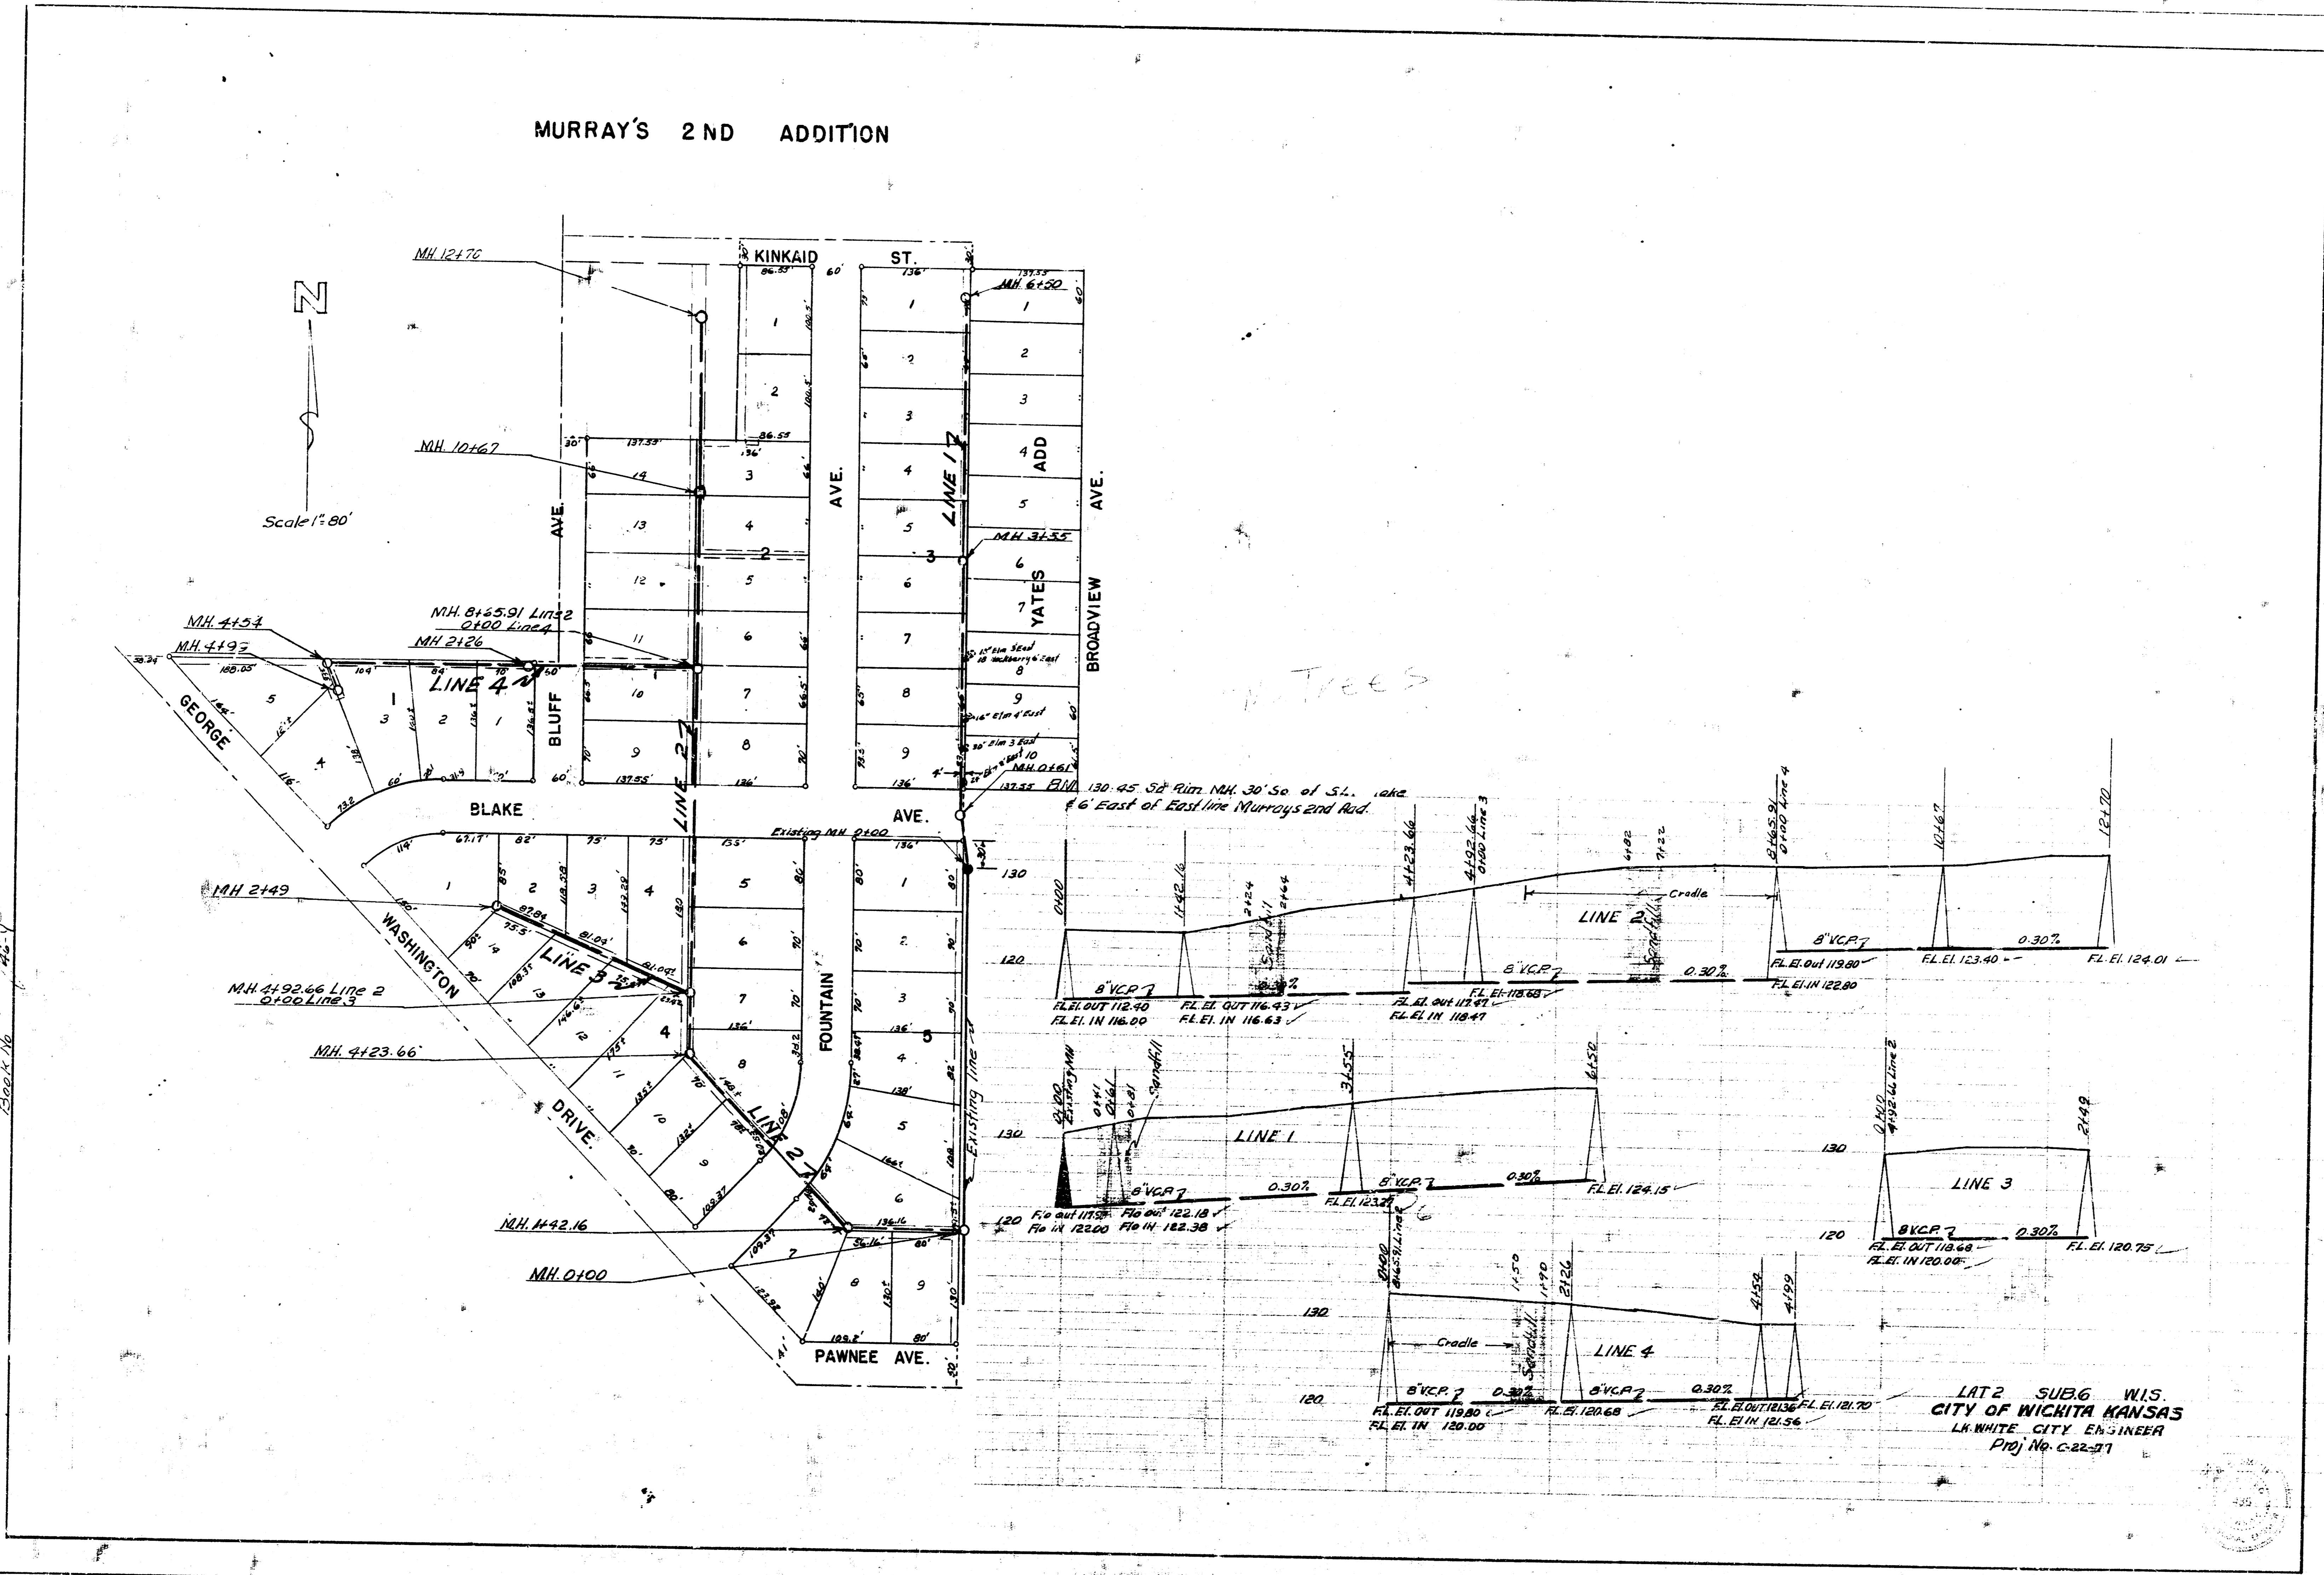

 Book 16

LAT 2 SUB 6 WIS.  
 CITY OF WICHITA KANSAS  
 L. H. WHITE, CITY ENGINEER  
 Proj. No. C-22-271