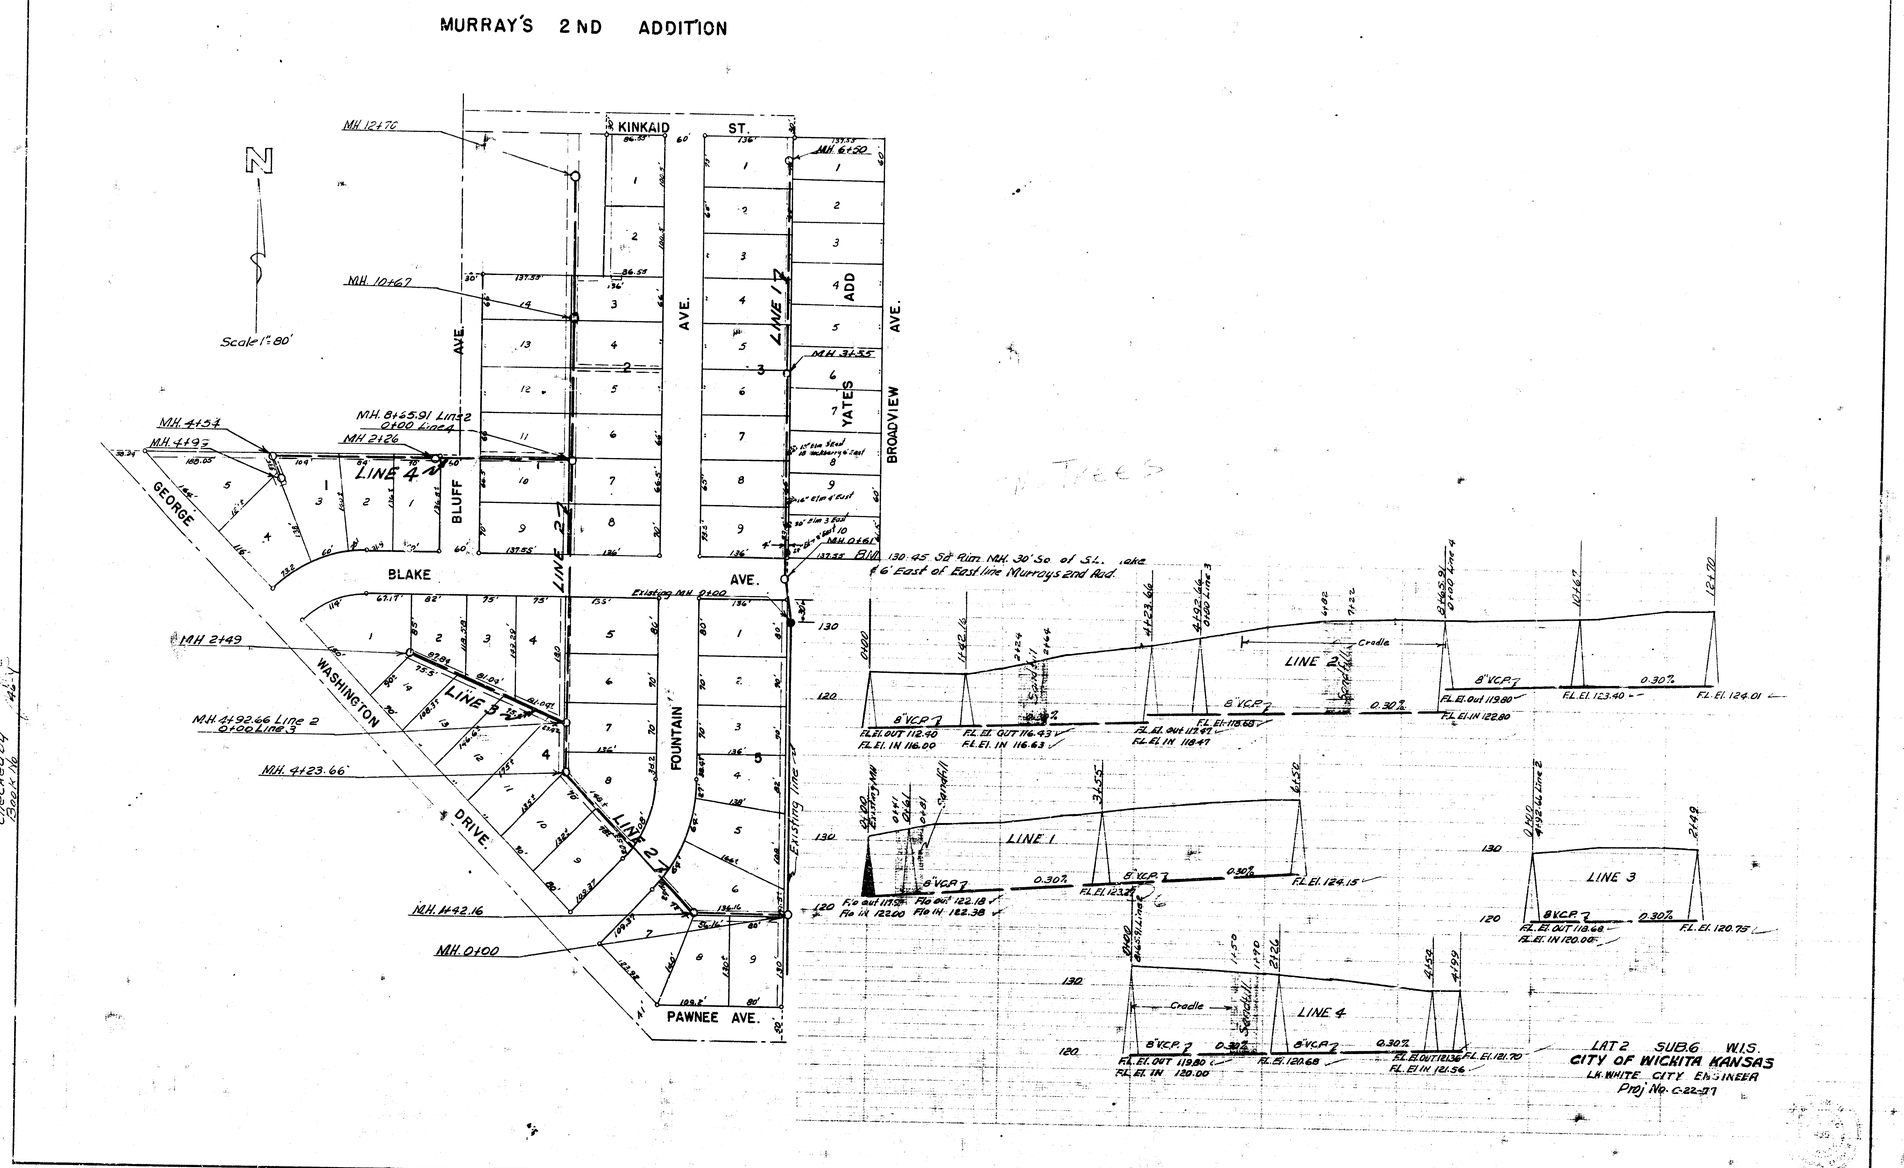
MURRAY'S 2ND ADDITION
N
Scale 1" = 80'
KINKAID ST.
BLUFF AVE.
YATES AVE.
BROADVIEW AVE.
GEORGE WASHINGTON DRIVE.
BLAKE AVE.
FOUNTAIN
PAWNEE AVE.
LINE 1
LINE 2
LINE 3
LINE 4
MH 12+70
MH 10+67
MH 6+50
MH 3+55
MH 4+54
MH 4+93
MH 2+26
MH 2+49
MH 4+92.66 Line 2 0+00 Line 3
MH 4+23.66
MH 1+42.16
MH 0+00
Existing MH 0+00
Existing line
BM 130.45 Sd Rim MH. 30' So of S.L. lake & 6' East of East line Murrays 2nd Add.
Cradle
Sandfill
8" V.C.P.
0.30%
F.L. El. OUT 112.40
F.L. El. IN 116.00
F.L. El. OUT 116.43
F.L. El. IN 116.63
F.L. El. OUT 117.47
F.L. El. IN 118.47
F.L. El. 118.68
F.L. El. OUT 119.80
F.L. El. IN 122.80
F.L. El. 123.40
F.L. El. 124.01
F.L. El. 124.15
F.L. El. 123.27
F.L. El. OUT 122.18
F.L. El. IN 122.38
F.L. El. OUT 118.68
F.L. El. IN 120.00
F.L. El. 120.75
F.L. El. OUT 119.80
F.L. El. IN 120.00
F.L. El. 120.68
F.L. El. OUT 121.36
F.L. El. IN 121.56
F.L. El. 121.70
LAT 2 SUB. 6 W.I.S.
CITY OF WICHITA KANSAS
LK. WHITE CITY ENGINEER
Proj No. C-22-77
Date Drawn by Checked by Book No.
9-30-52 McClain