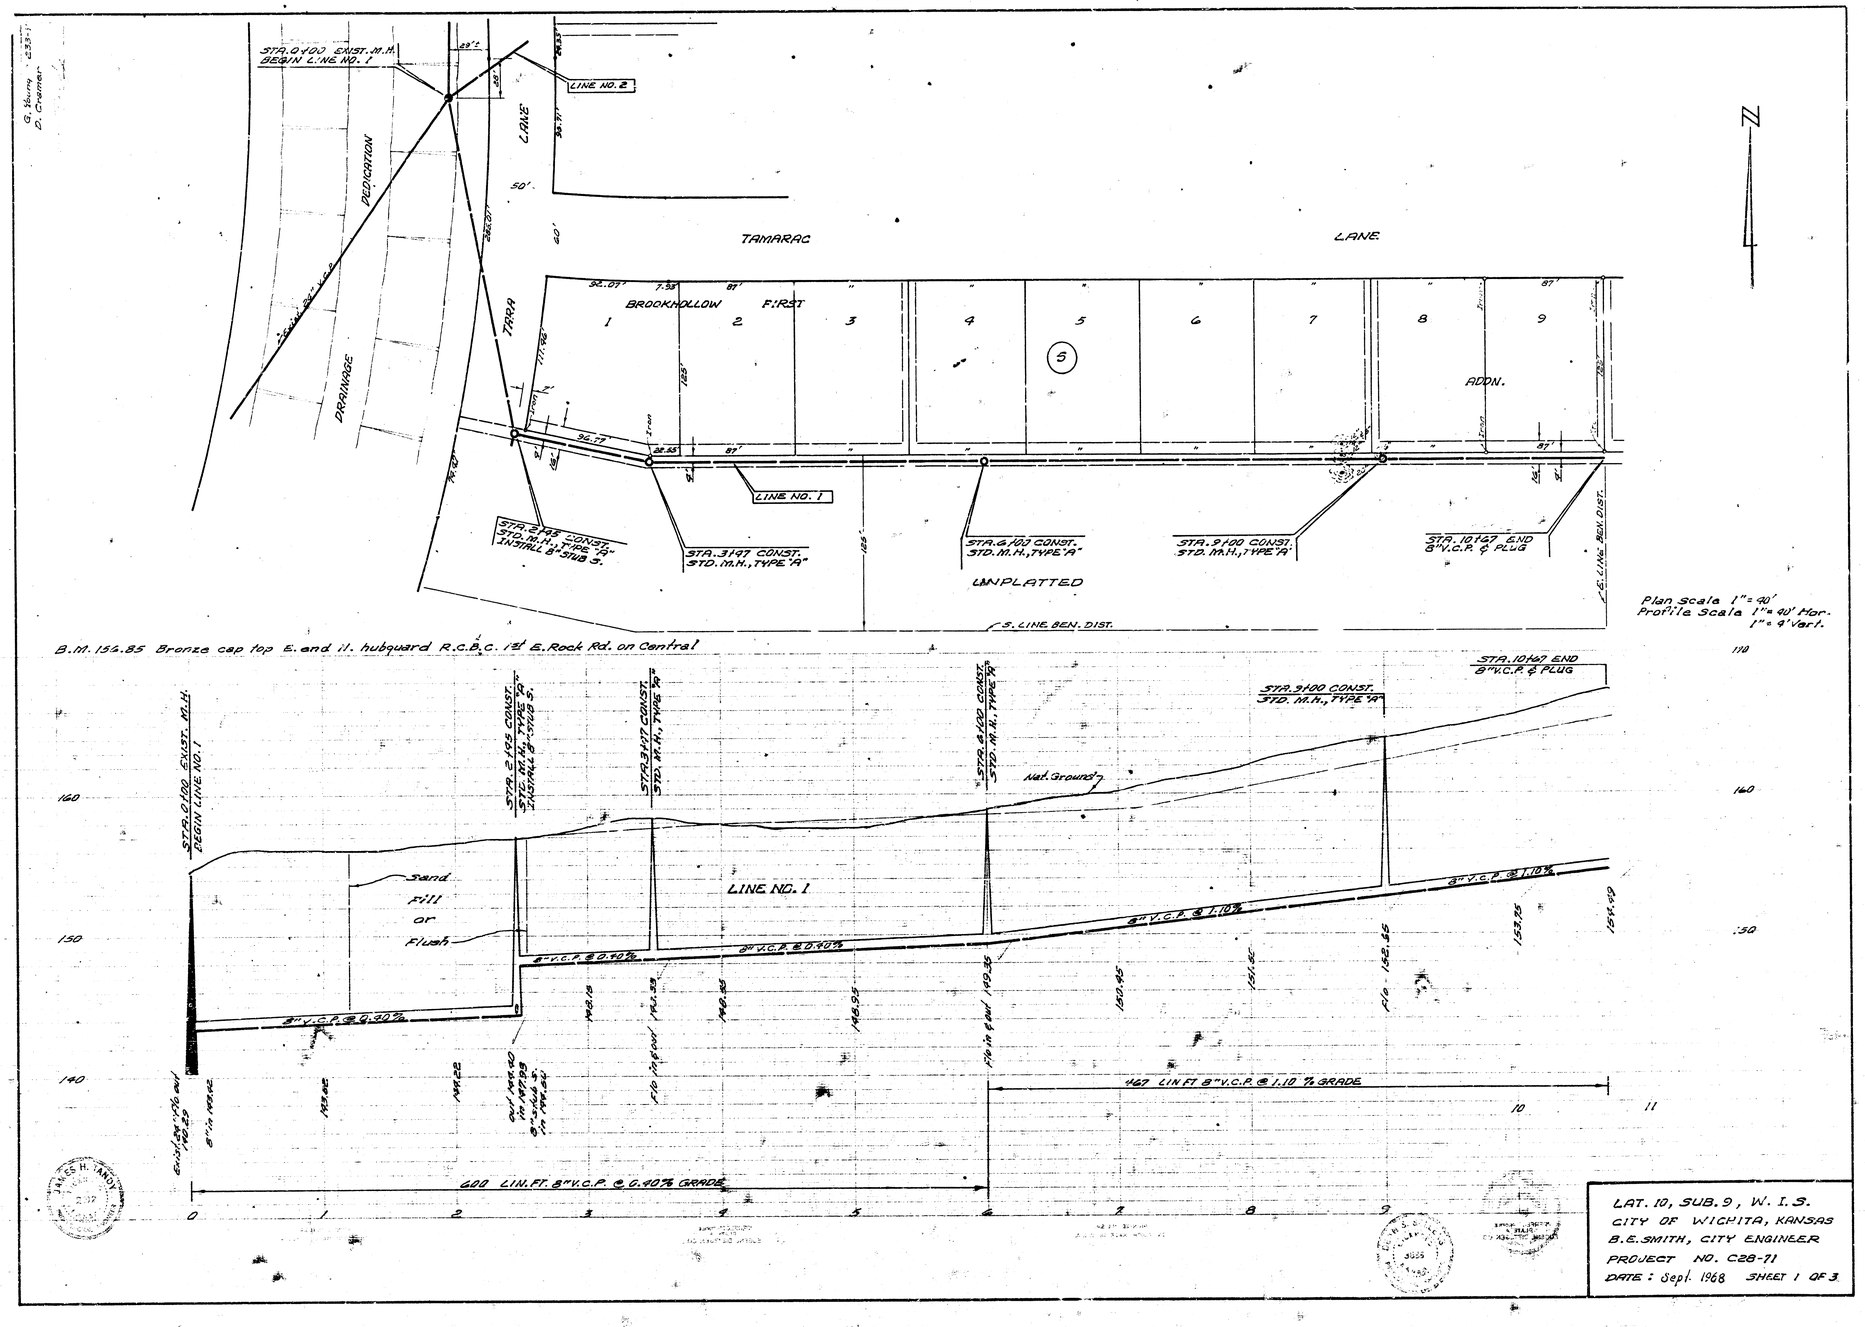

LAT. 10, SUB. 9, W. I. S.
CITY OF WICHITA, KANSAS
B.E. SMITH, CITY ENGINEER
PROJECT NO. C28-71
DATE: Sept. 1968 SHEET 1 OF 3

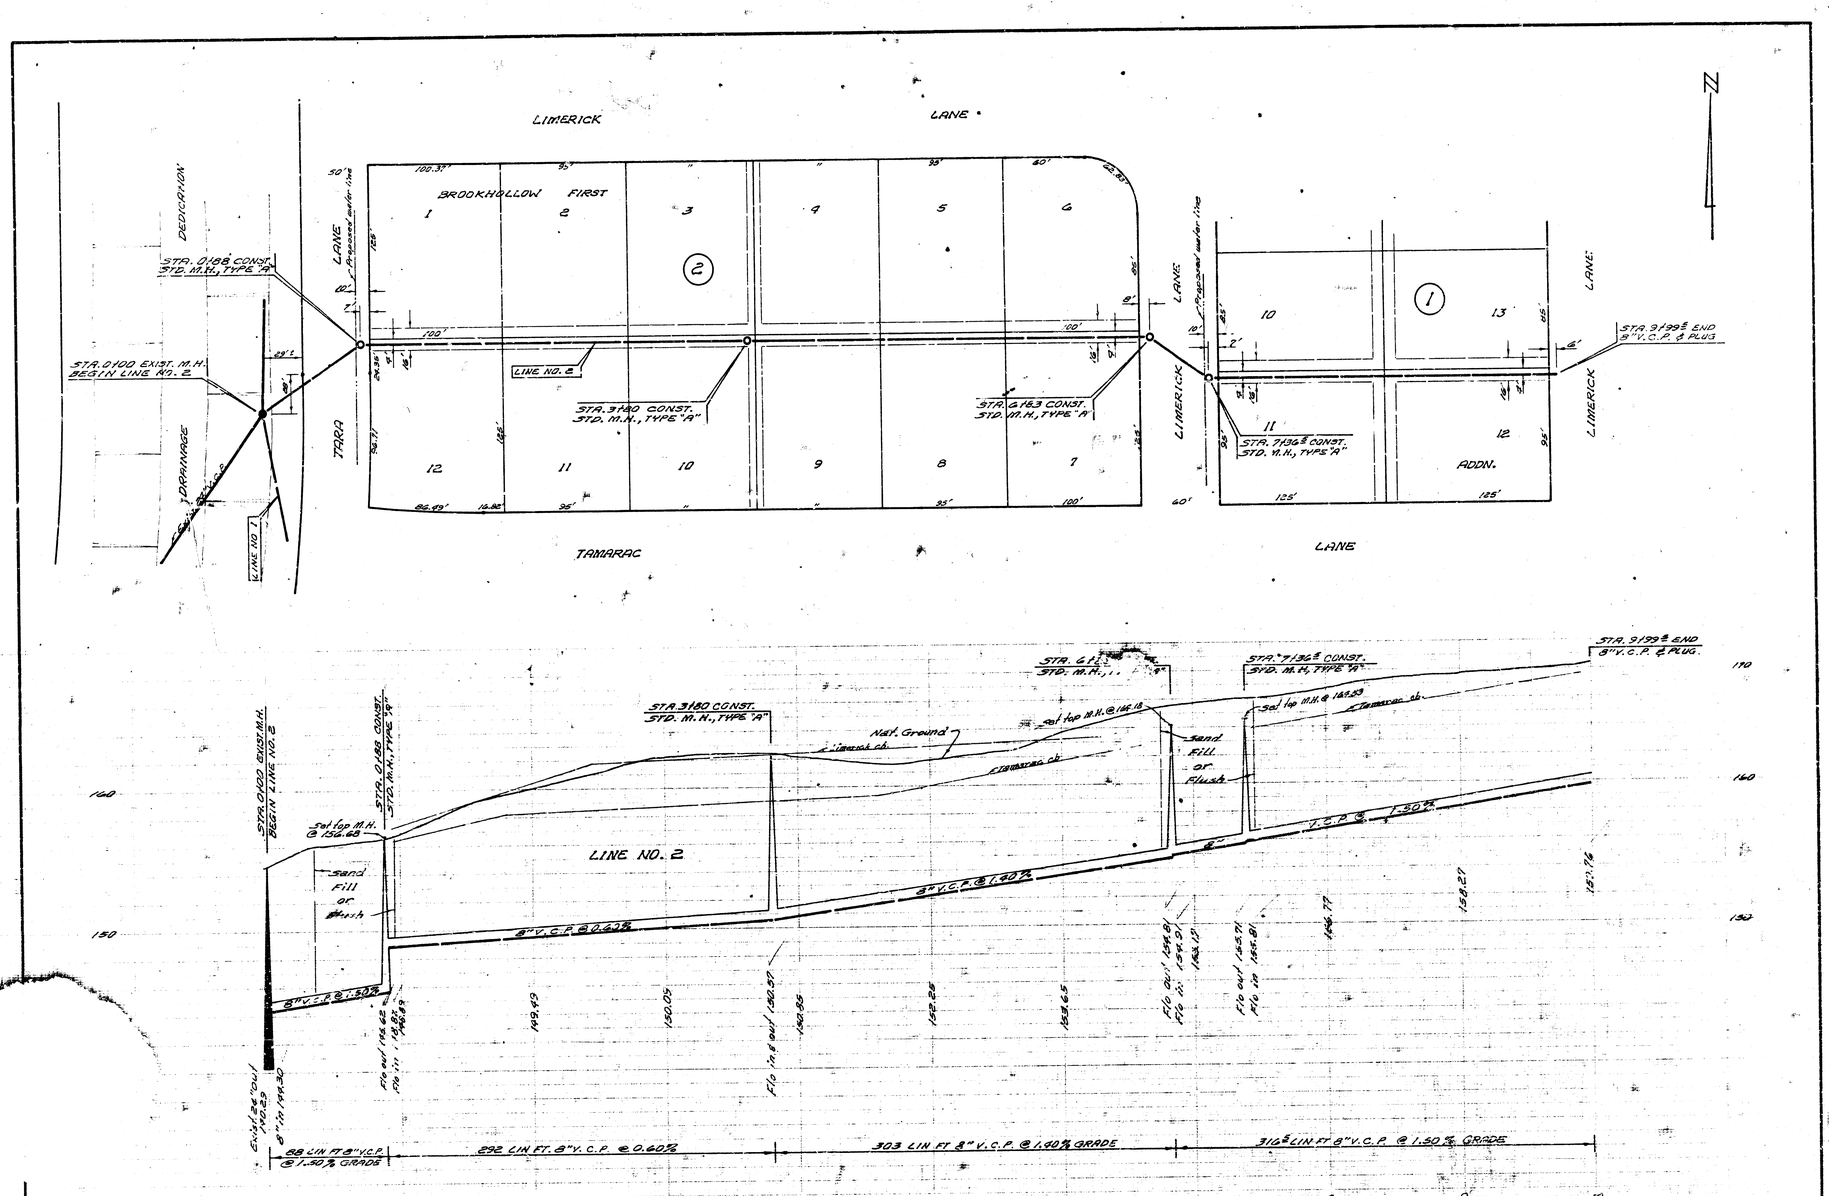

LAT. 10, SUB. 9, W. I. S.
PROJ. NO. C28-71

SHEET 2 OF 3


















































