Dullea, Jr. DCD #5
D. Cramer

B.M. 156.85 Brass cap top E. end N. Hubqd. R.C.B. 1st E. Rock Rd. on Central
B.M. 156.38 S. Rim San. Sewer M.H. @ N.W. cor. Lot 1, Blk. 2, Brookhallow 2nd Addn.
B.M. 169.81 R. R. Spike N. A. Transformer Pole 25' east of Langford Ln. North on S. S. Central.

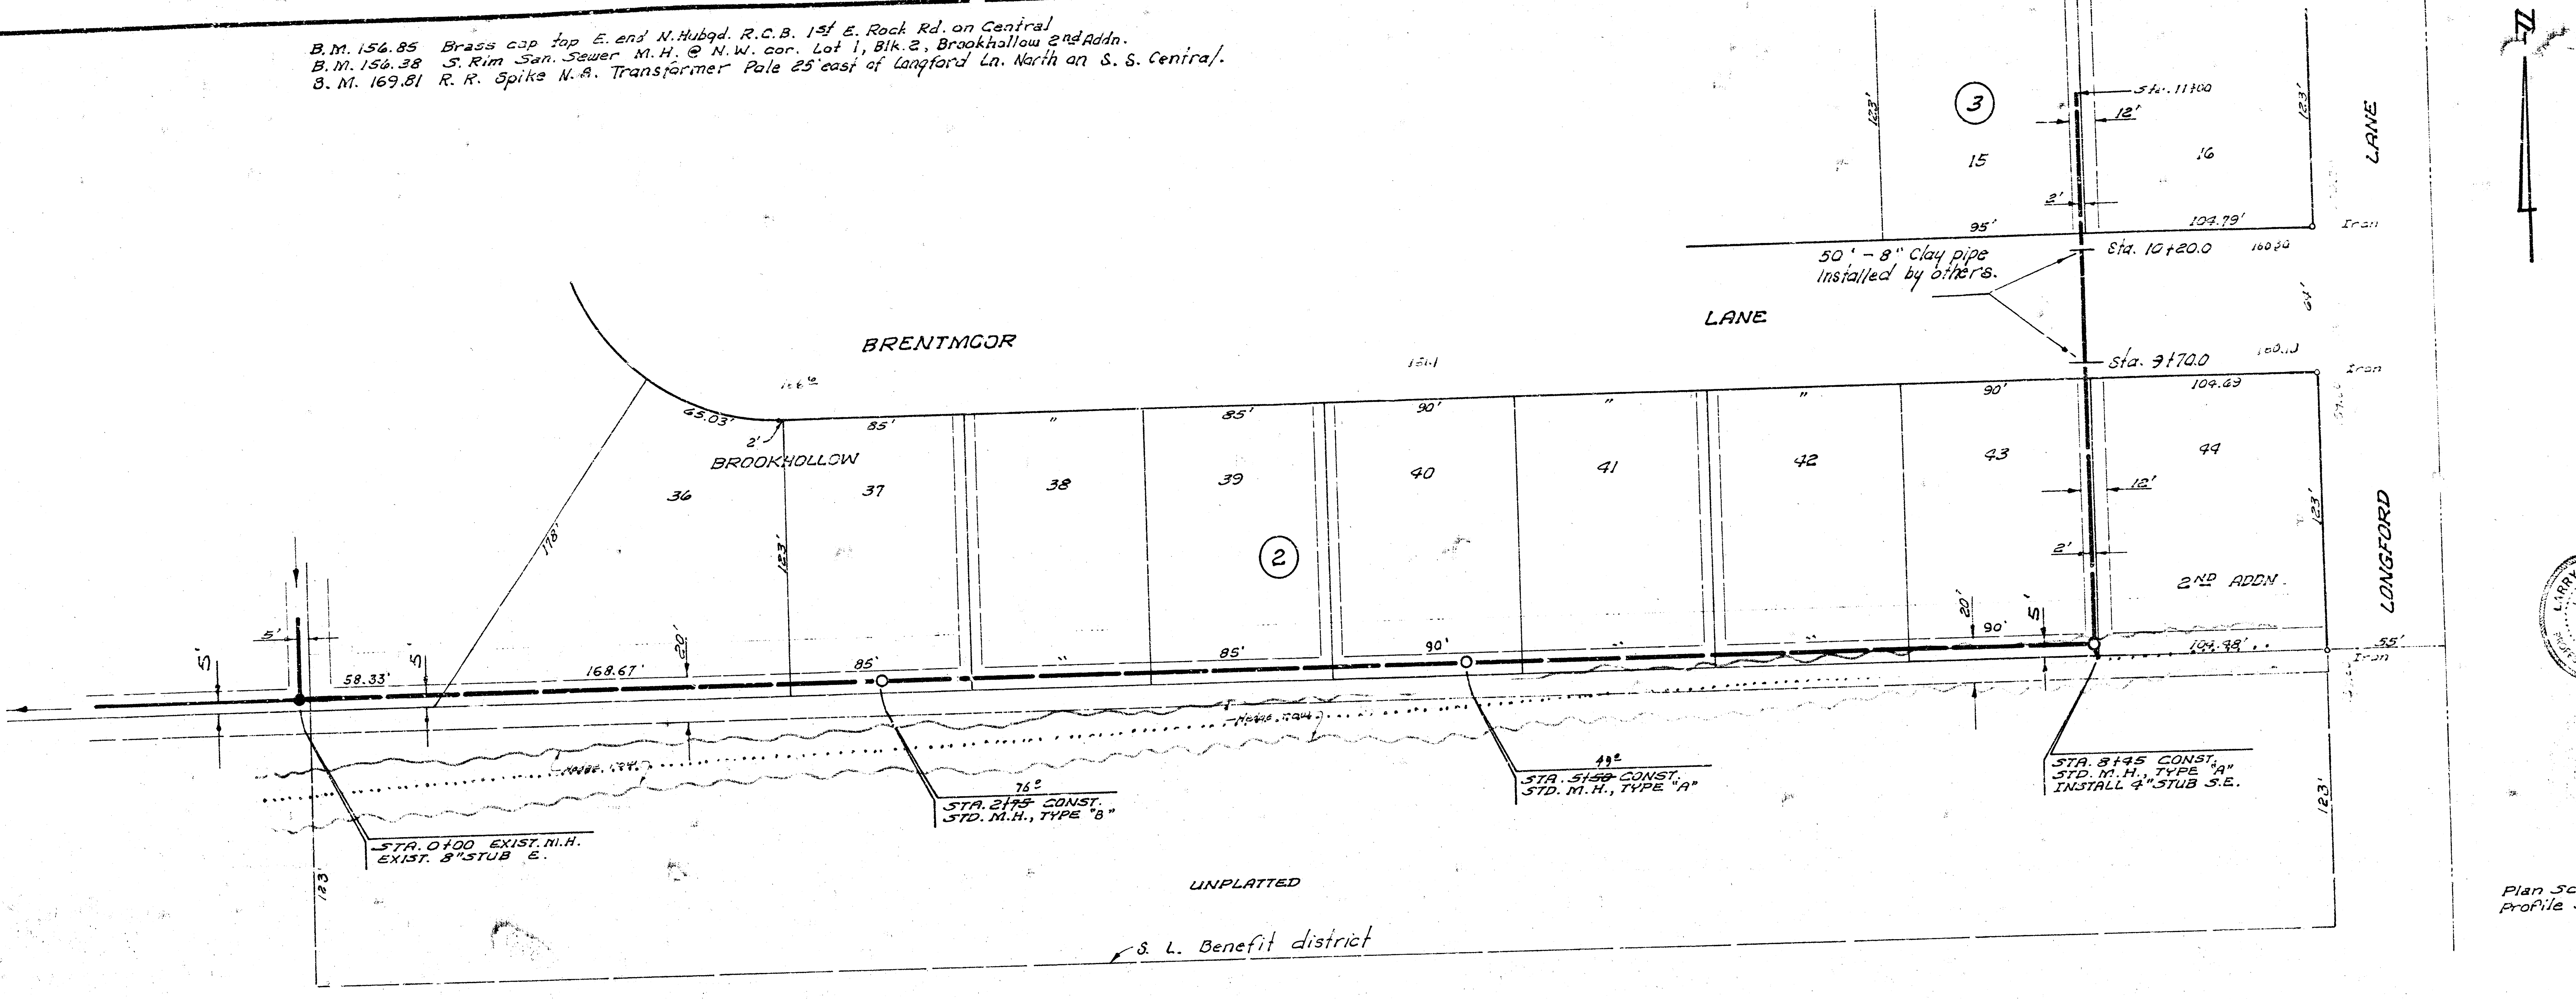
BRENTMOOR
LANE
BROOKHOLLOW
2ND ADDN.
LONGFORD
LANE
③
15
16
②
36
37
38
39
40
41
42
43
44
95'
104.79'
104.69
104.98'
85'
90'
168.67'
58.33'
178'
123'
12'
2'
5'
20'
55'
Iron
Sta. 11+00
Sta. 10+20.0
Sta. 9+70.0
50' - 8" Clay pipe Installed by others.
STA. 0+00 EXIST. M.H. EXIST. 8"STUB E.
STA. 2+75 CONST. STD. M.H., TYPE "B"
STA. 5+50 CONST. STD. M.H., TYPE "A"
STA. 8+45 CONST. STD. M.H., TYPE "A" INSTALL 4"STUB S.E.
UNPLATTED
S. L. Benefit district

LARRY W. LAURSEN 6363

Plan Scale 1"=40'
Profile Scale 1"=40' Hor.
1"=4' Vert.

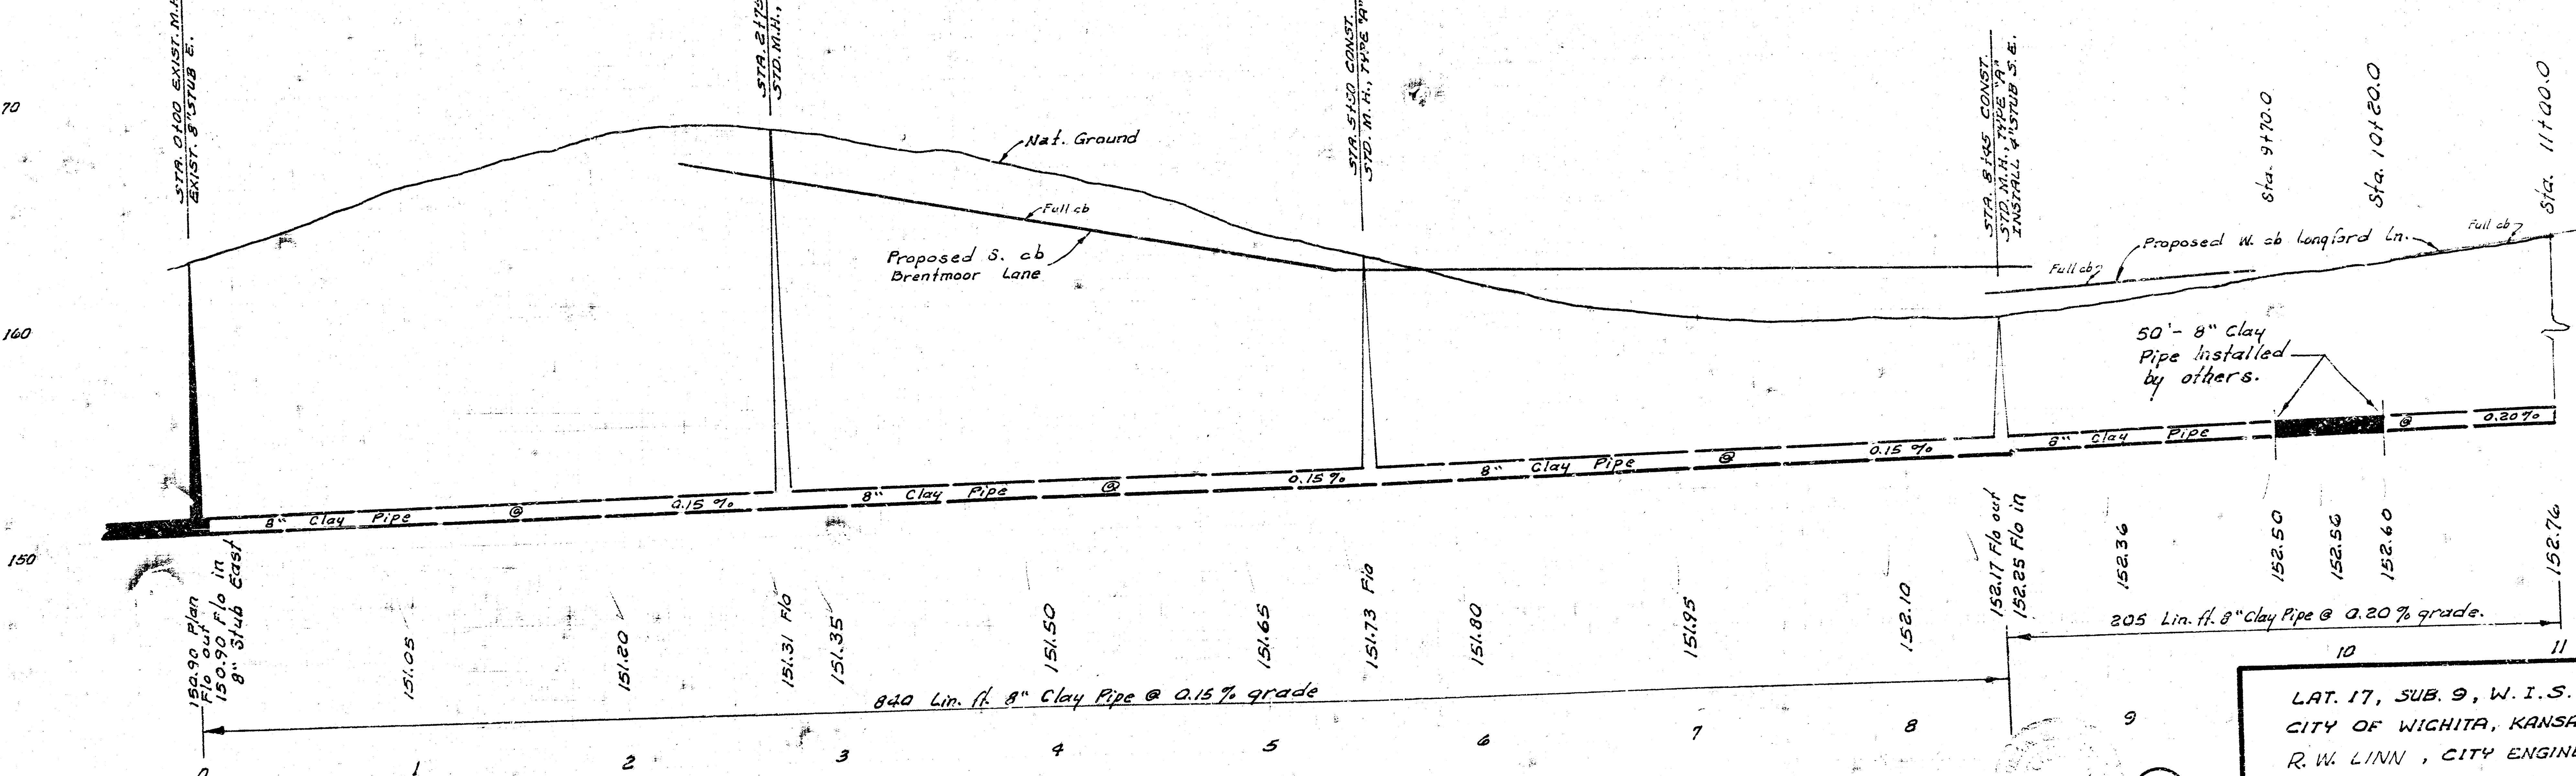
170
160
150
STA. 0+00 EXIST. M.H. EXIST. 8"STUB E.
STA. 2+75 CONST. STD. M.H., TYPE "B"
STA. 5+50 CONST. STD. M.H., TYPE "A"
STA. 8+45 CONST. STD. M.H., TYPE "A" INSTALL 4"STUB S.E.
Sta. 9+70.0
Sta. 10+20.0
Sta. 11+00.0
Nat. Ground
Full cb
Proposed S. cb Brentmoor Lane
Proposed W. cb Longford Ln.
50'- 8" Clay Pipe Installed by others.
8" Clay Pipe @ 0.15 %
8" Clay Pipe @ 0.20 %
150.90 Plan
Flo out
150.90 Flo in
8" Stub East
151.05
151.20
151.31 Flo
151.35
151.50
151.65
151.73 Flo
151.80
151.95
152.10
152.17 Flo out
152.25 Flo in
152.36
152.50
152.56
152.60
152.76
840 Lin. ft. 8" Clay Pipe @ 0.15 % grade
205 Lin. ft. 8" Clay Pipe @ 0.20 % grade.
0
1
2
3
4
5
6
7
8
9
10
11
"As Built" Final Measurements I.H.-77

①/②

LAT. 17, SUB. 9, W. I. S.
CITY OF WICHITA, KANSAS
R. W. LINN , CITY ENGINEER
PROJ. NO. DBKL570027
DATE: NOV., 1972
1/2

FILMED FROM THE BEST

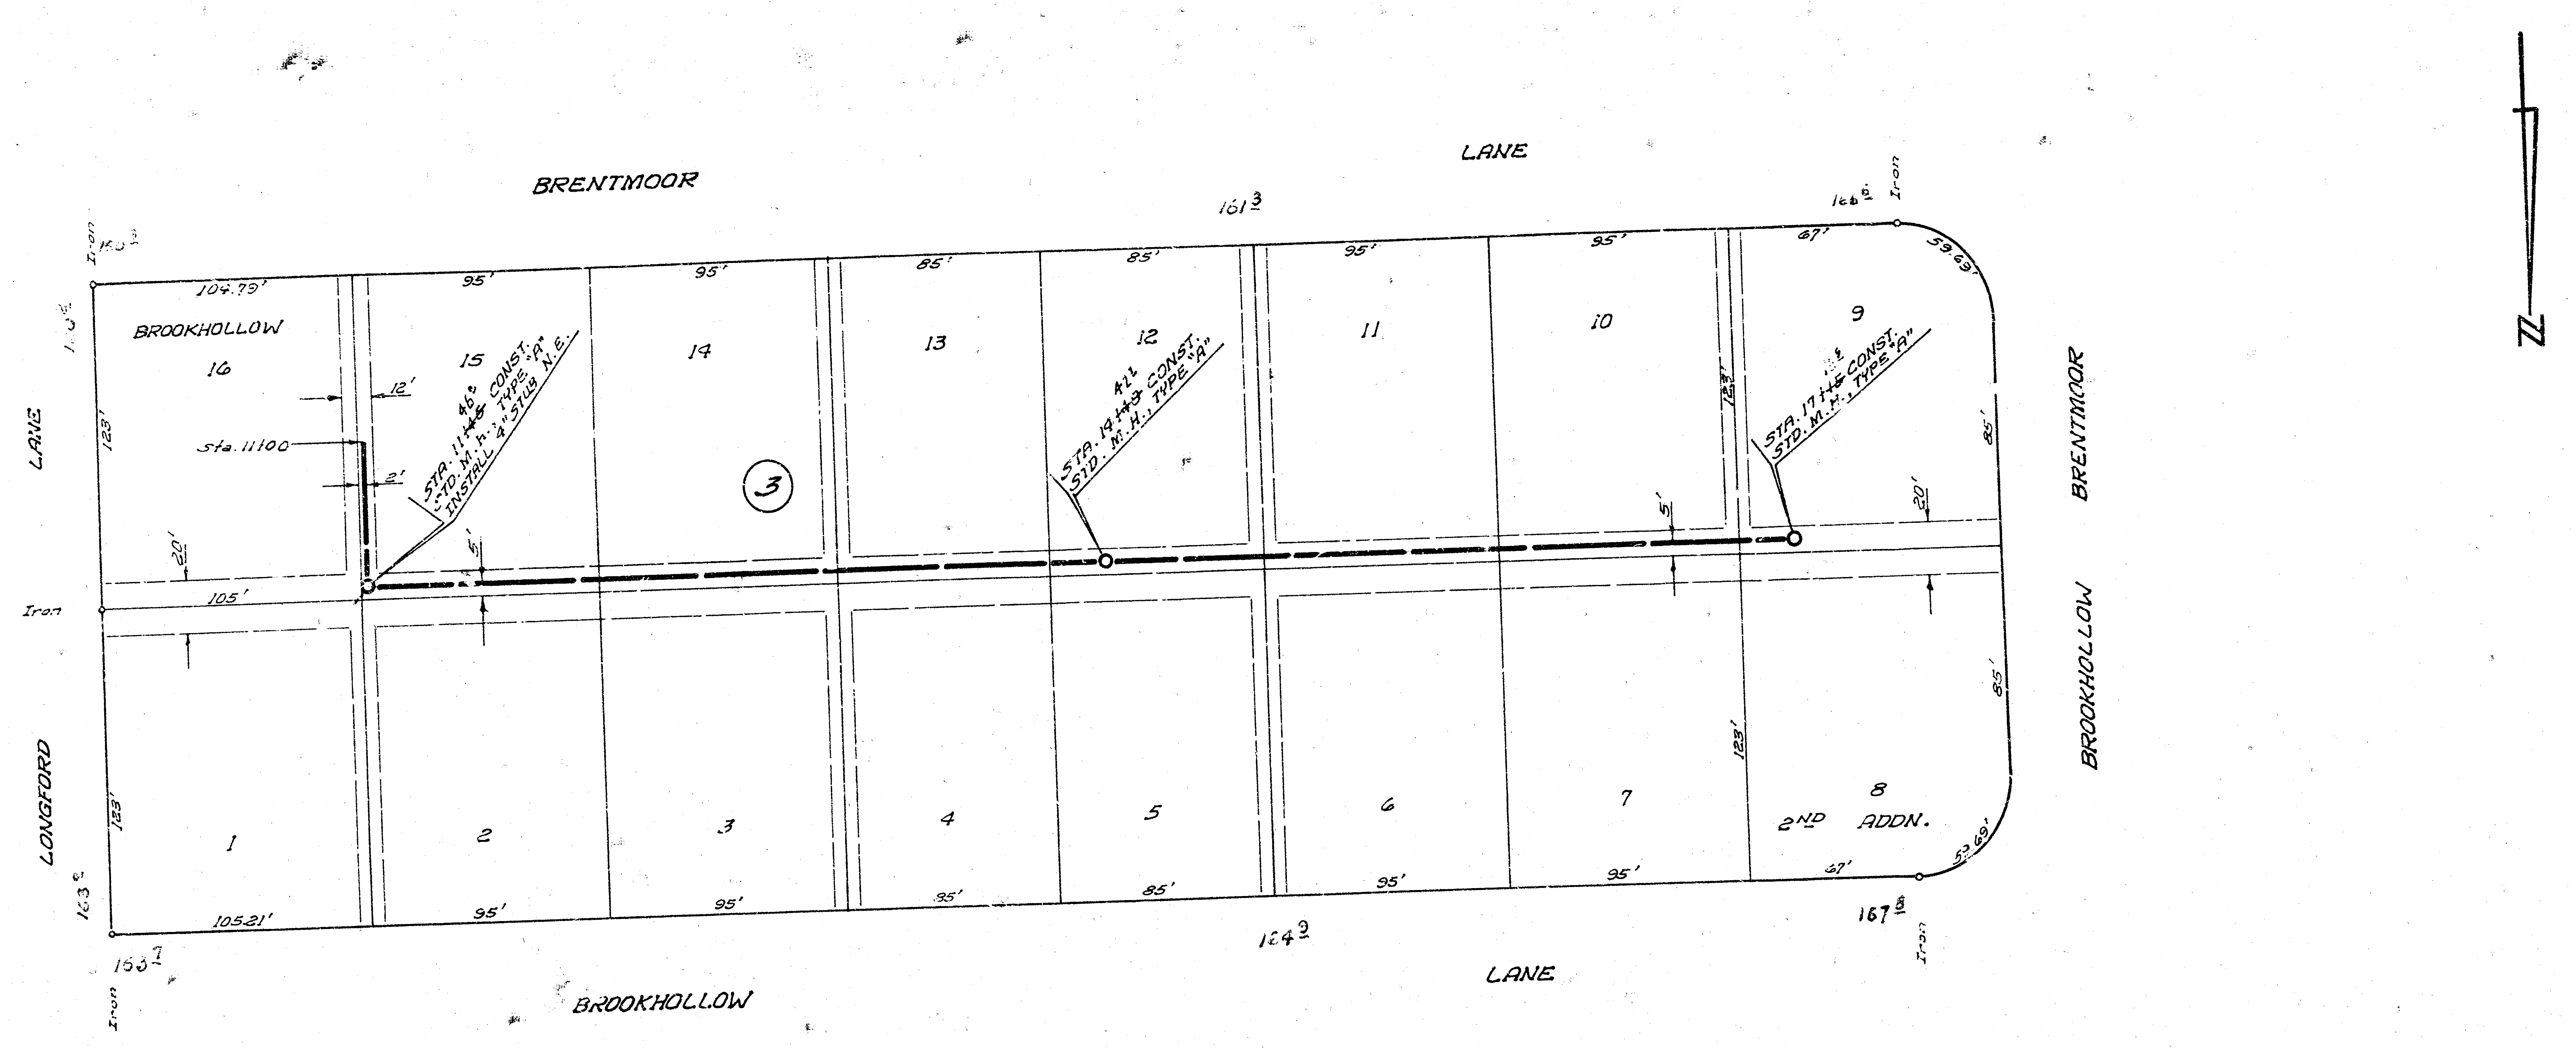
BRENTMOOR
LANE
161 3
166 6
Iron
163 3
104.79'
95'
85'
67'
39.63'
BROOKHOLLOW
16
15
14
13
12
11
10
9
12'
2'
Sta. 11100
STA. 11+46 CONST. STD. M.H., TYPE "A" INSTALL 4" STUB N.E.
STA. 14+41 CONST. STD. M.H., TYPE "A"
STA. 17+16 CONST. STD. M.H., TYPE "A"
3
123'
20'
5'
105'
LANE
LONGFORD
BRENTMOOR
BROOKHOLLOW
1
2
3
4
5
6
7
8
2ND ADDN.
105.21'
53.69'
158 7
164 9
167 8
BROOKHOLLOW
LANE
N

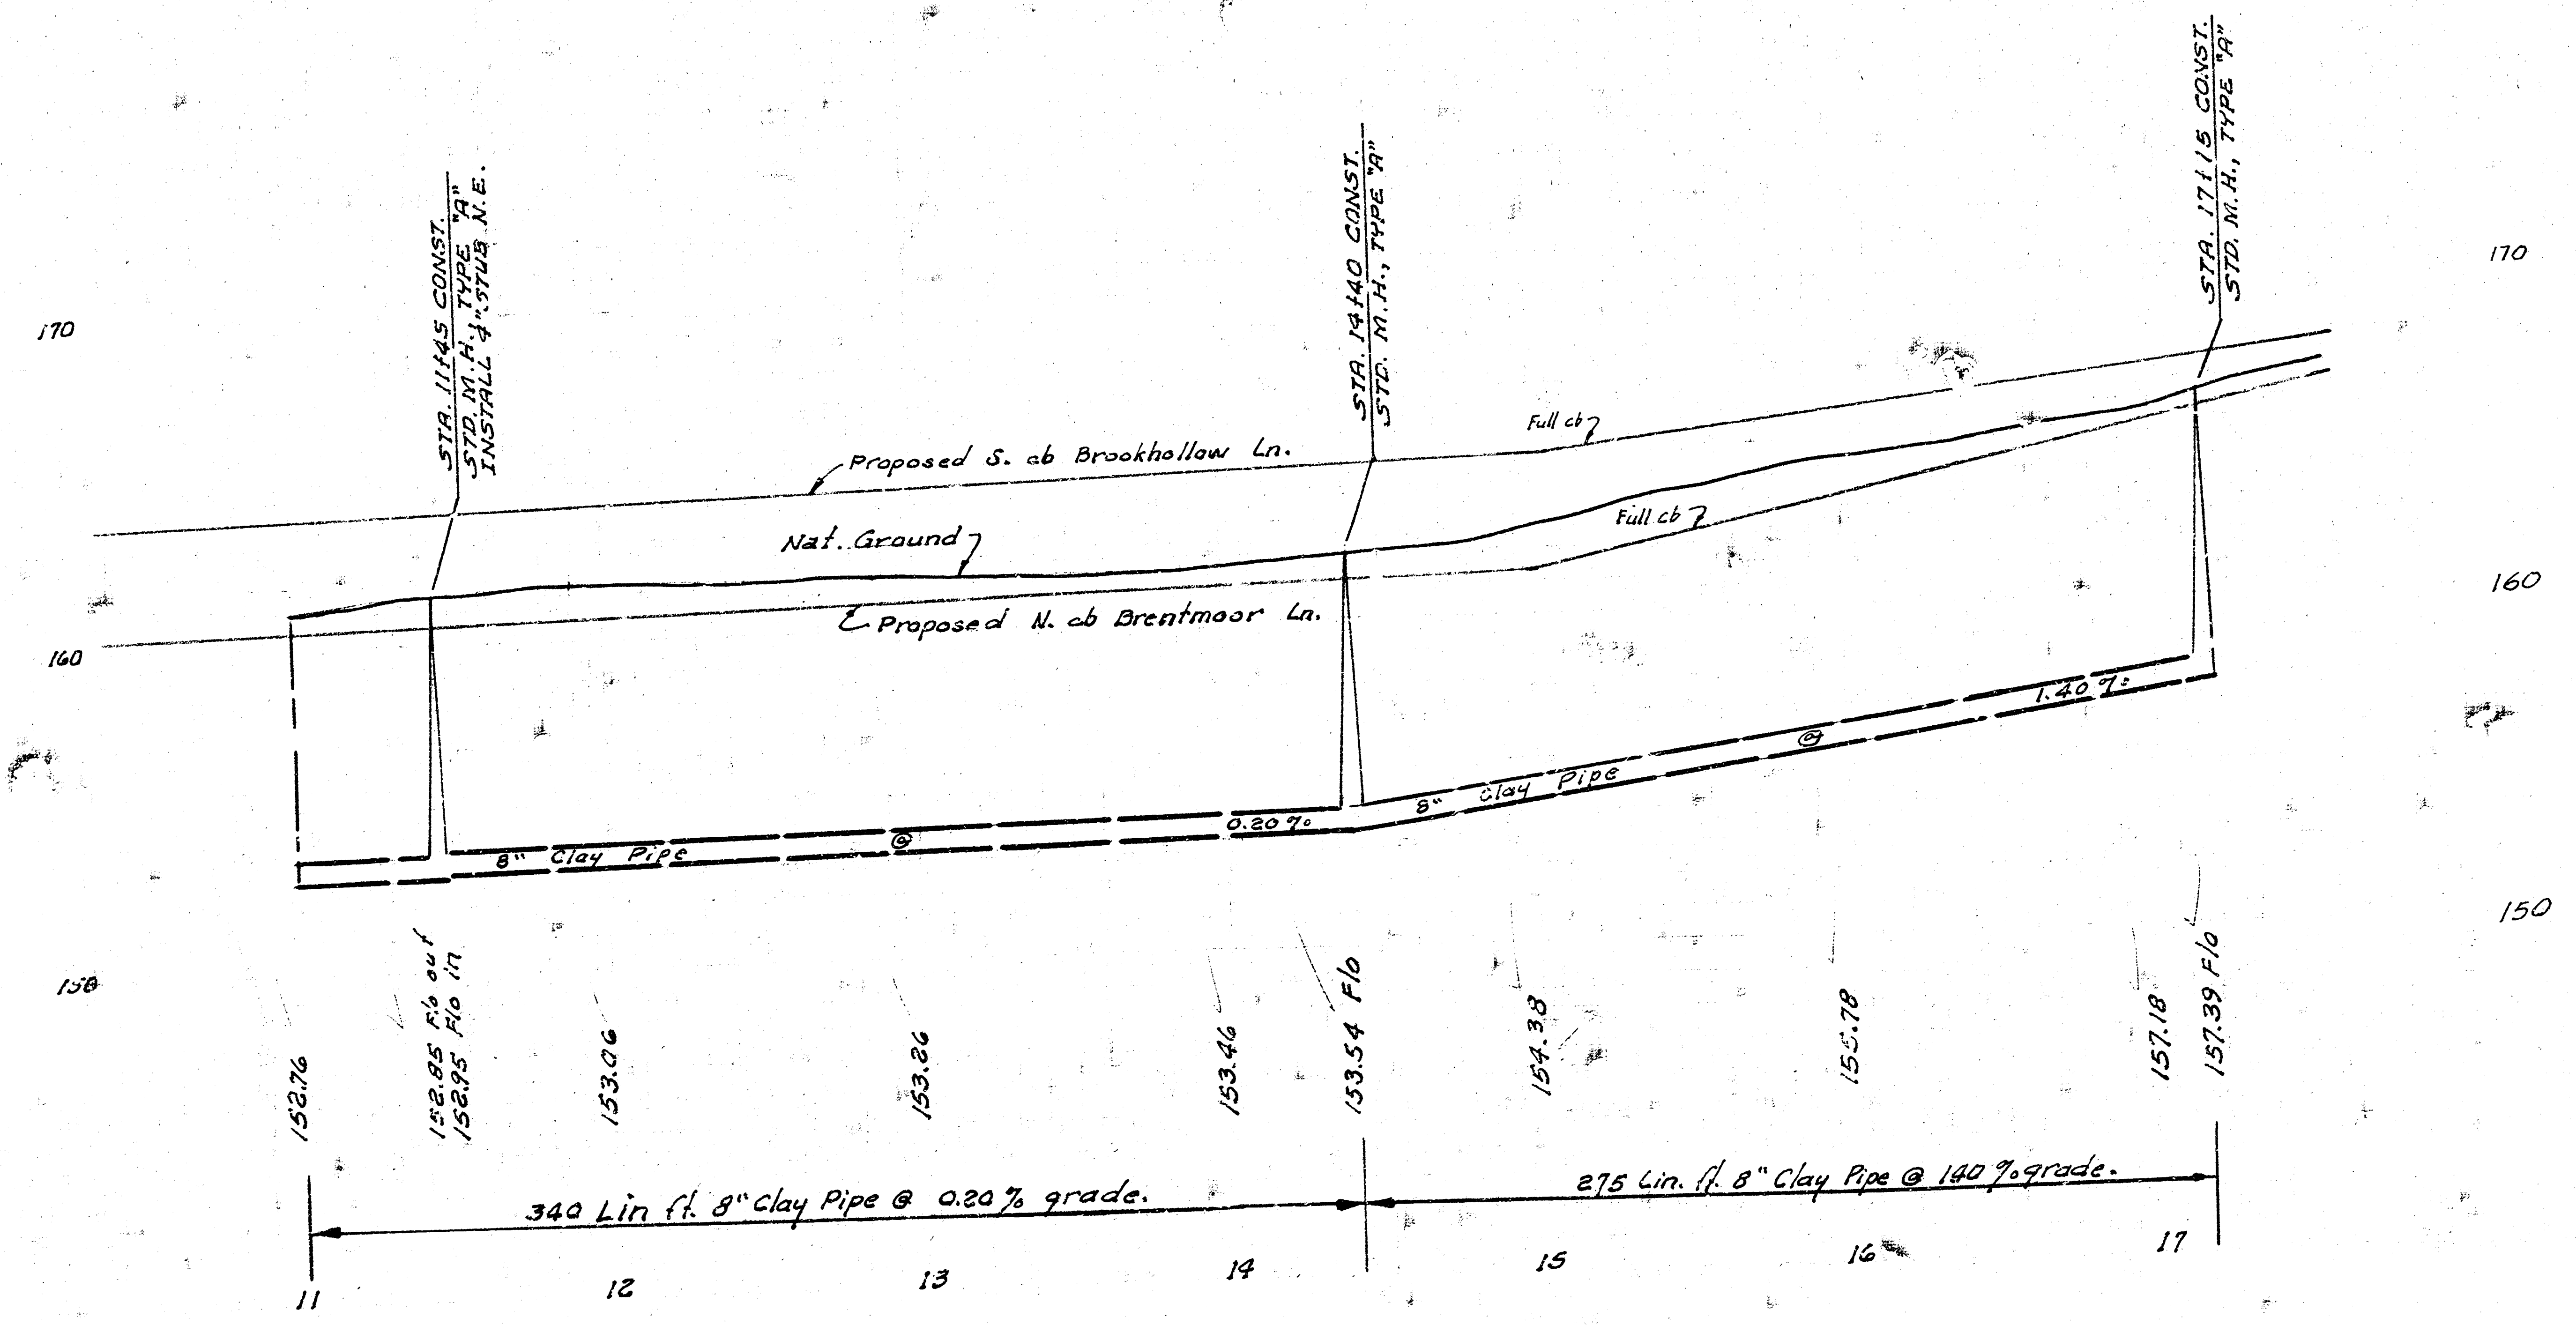
STA. 11+45 CONST. STD. M.H., TYPE "A" INSTALL 4" STUB N.E.
STA. 14+40 CONST. STD. M.H., TYPE "A"
STA. 17+15 CONST. STD. M.H., TYPE "A"
170
160
150
Proposed S. cb Brookhollow Ln.
Full cb
Nat. Ground
Full cb
℄ Proposed N. cb Brentmoor Ln.
8" Clay Pipe @ 0.20%
8" Clay Pipe @ 1.40%
152.76
152.85 F/o out
152.95 F/o in
153.06
153.26
153.46
153.54 F/o
154.38
155.78
157.18
157.39 F/o
340 Lin ft. 8" Clay Pipe @ 0.20% grade.
275 Lin. ft. 8" Clay Pipe @ 1.40% grade.
11
12
13
14
15
16
17

②/②

LAT. 17, SUB. 9, W. I. S.
PROJ. NO. DBKL570027

FILMED FROM THE BEST