
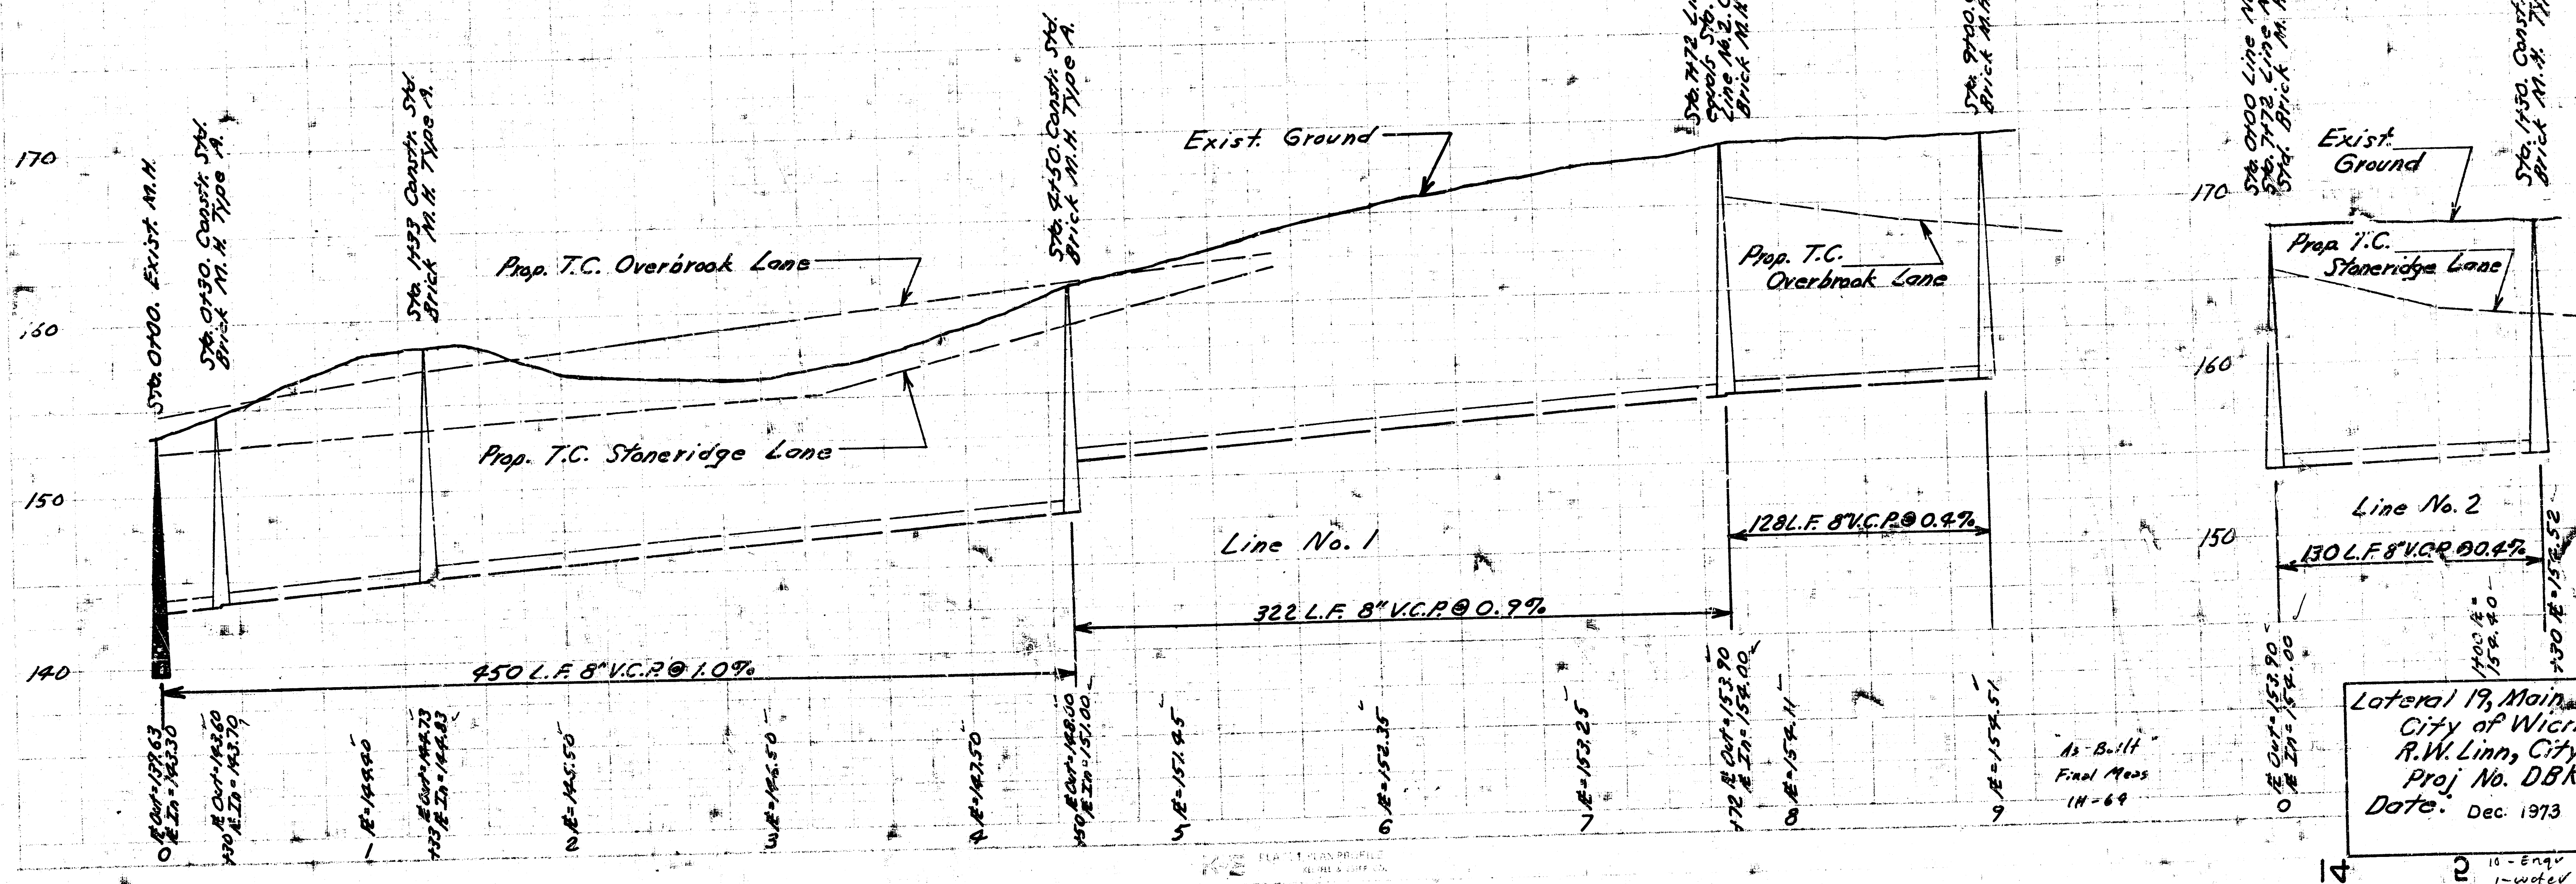


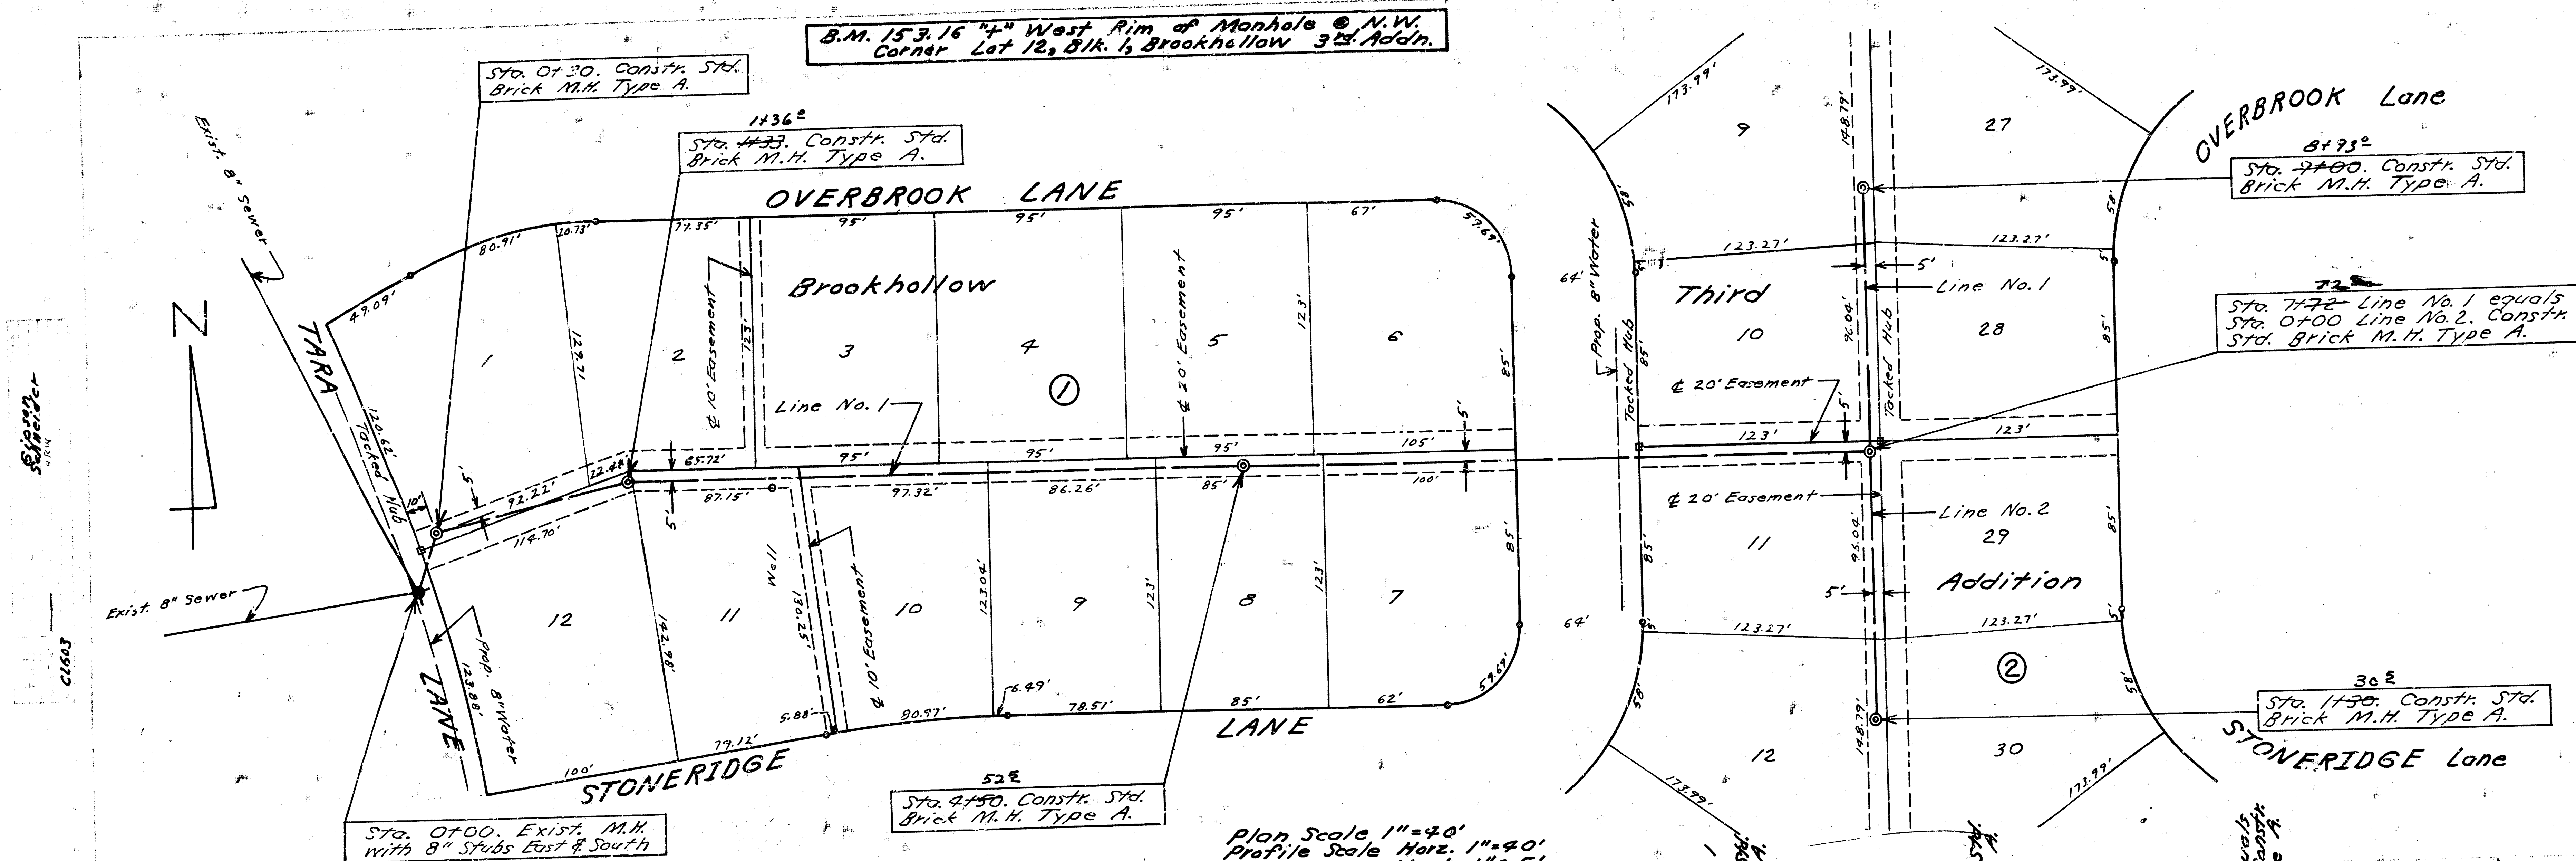

Lateral 19, Main 9, War Ind. Sew.
 City of Wichita, Kansas
 R.W. Linn, City Engineer
 Proj. No. DBKLS73049
 Date: Dec. 1973 Spt. No. 1 of 1