

B. M. 167.69 Rock Rd. & Central City B.M. a chiseled on S.E. conc. conc. valve box NW cor. intersection 5' N. of N. cb on Central.

B. M. 156.23 set a chiseled on S.E. cor conc. pkg. lot behind Privy Shop 366 ± Rock Rd.

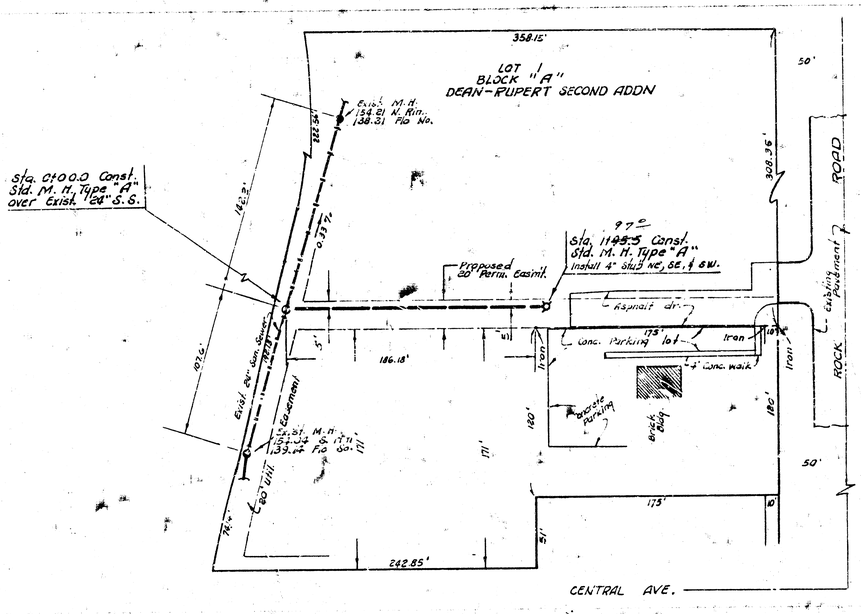

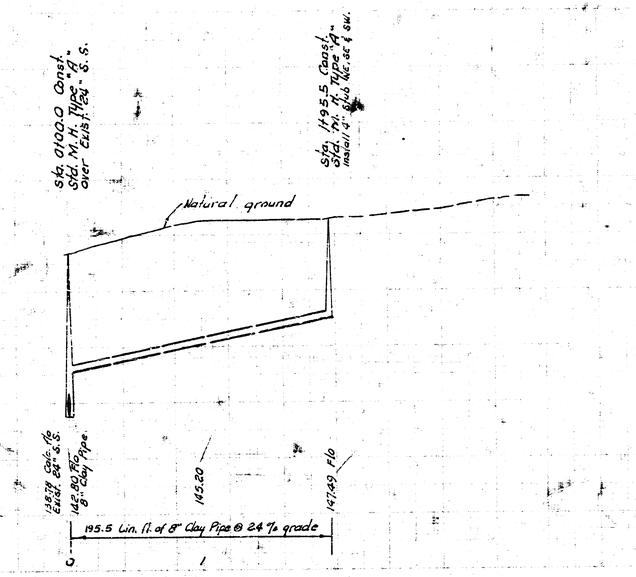

N

Plan Scale 1" = 40'
Profile Scale 1" = 40' Horz.
1" = 5' Vert.

DONALD E. SCHNEIDER
LICENSED
6311
KANSAS
PROFESSIONAL ENGINEER

As Built Final Mylar TH-75

LAT. 22, MAIN 9, W. I. S.
CITY OF WICHITA, KANSAS
R. W. LINN — CITY ENGINEER
MAR. 1974 PROJECT NO. D8KL574007