

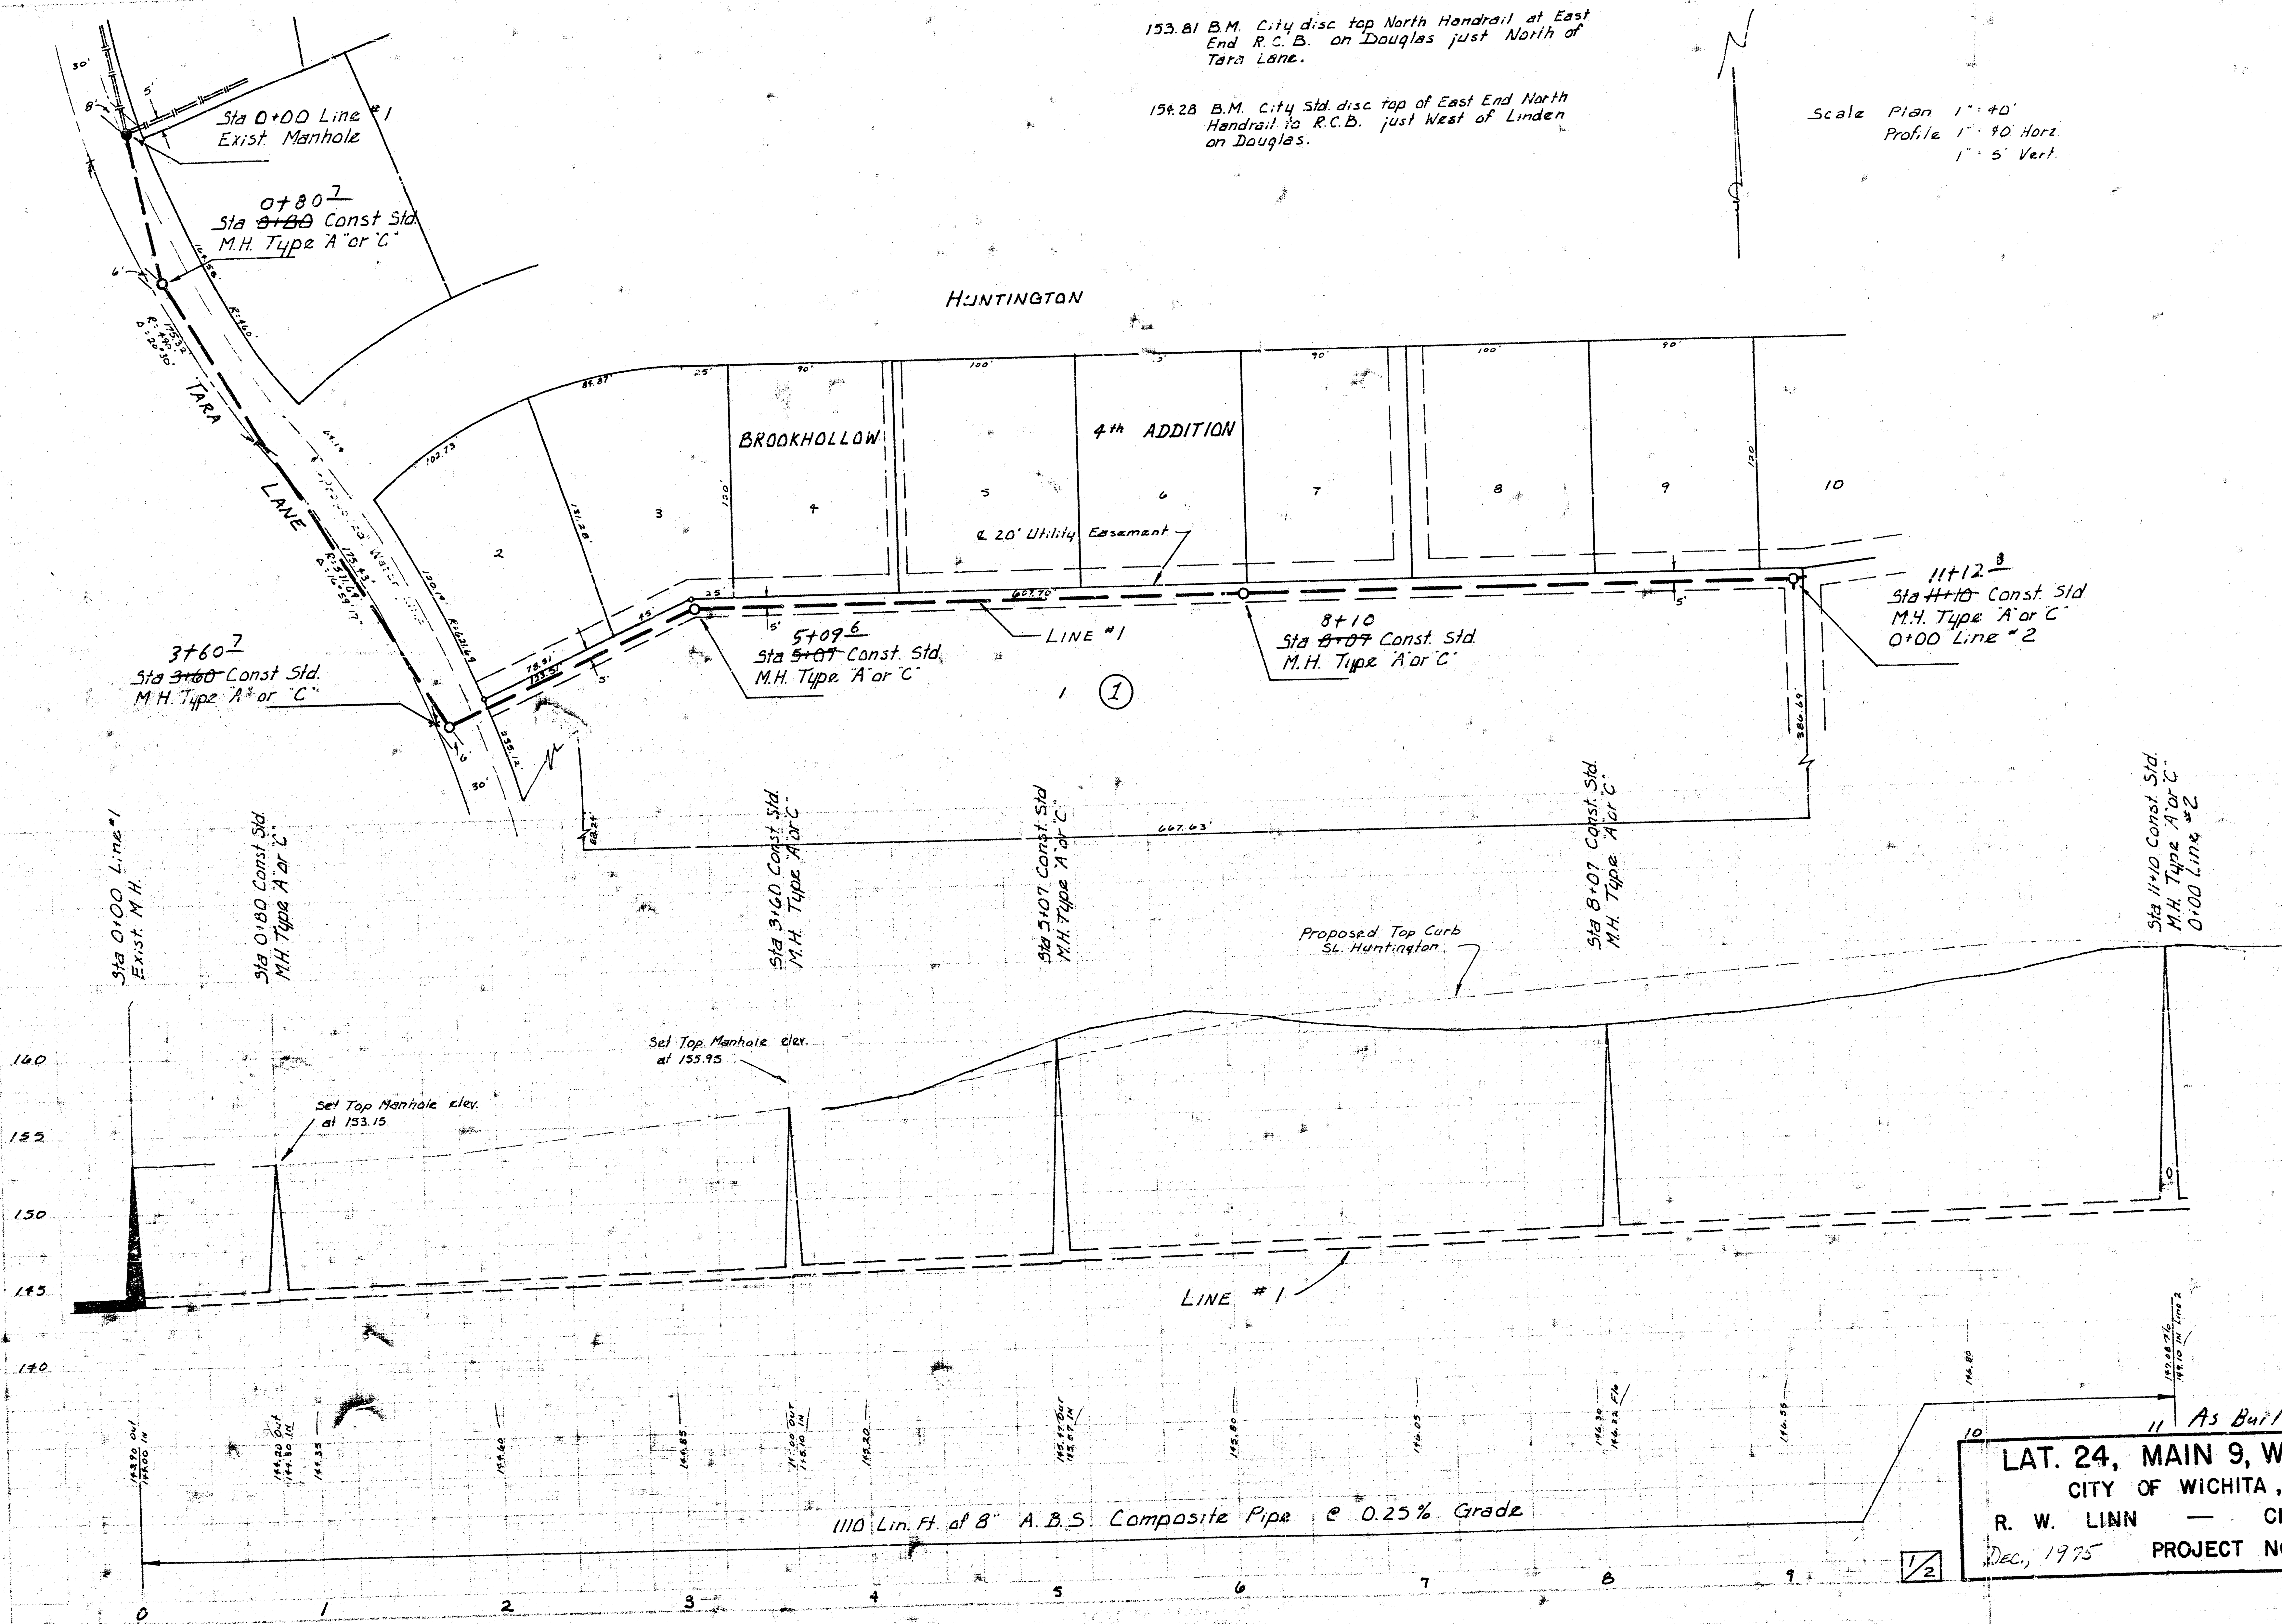
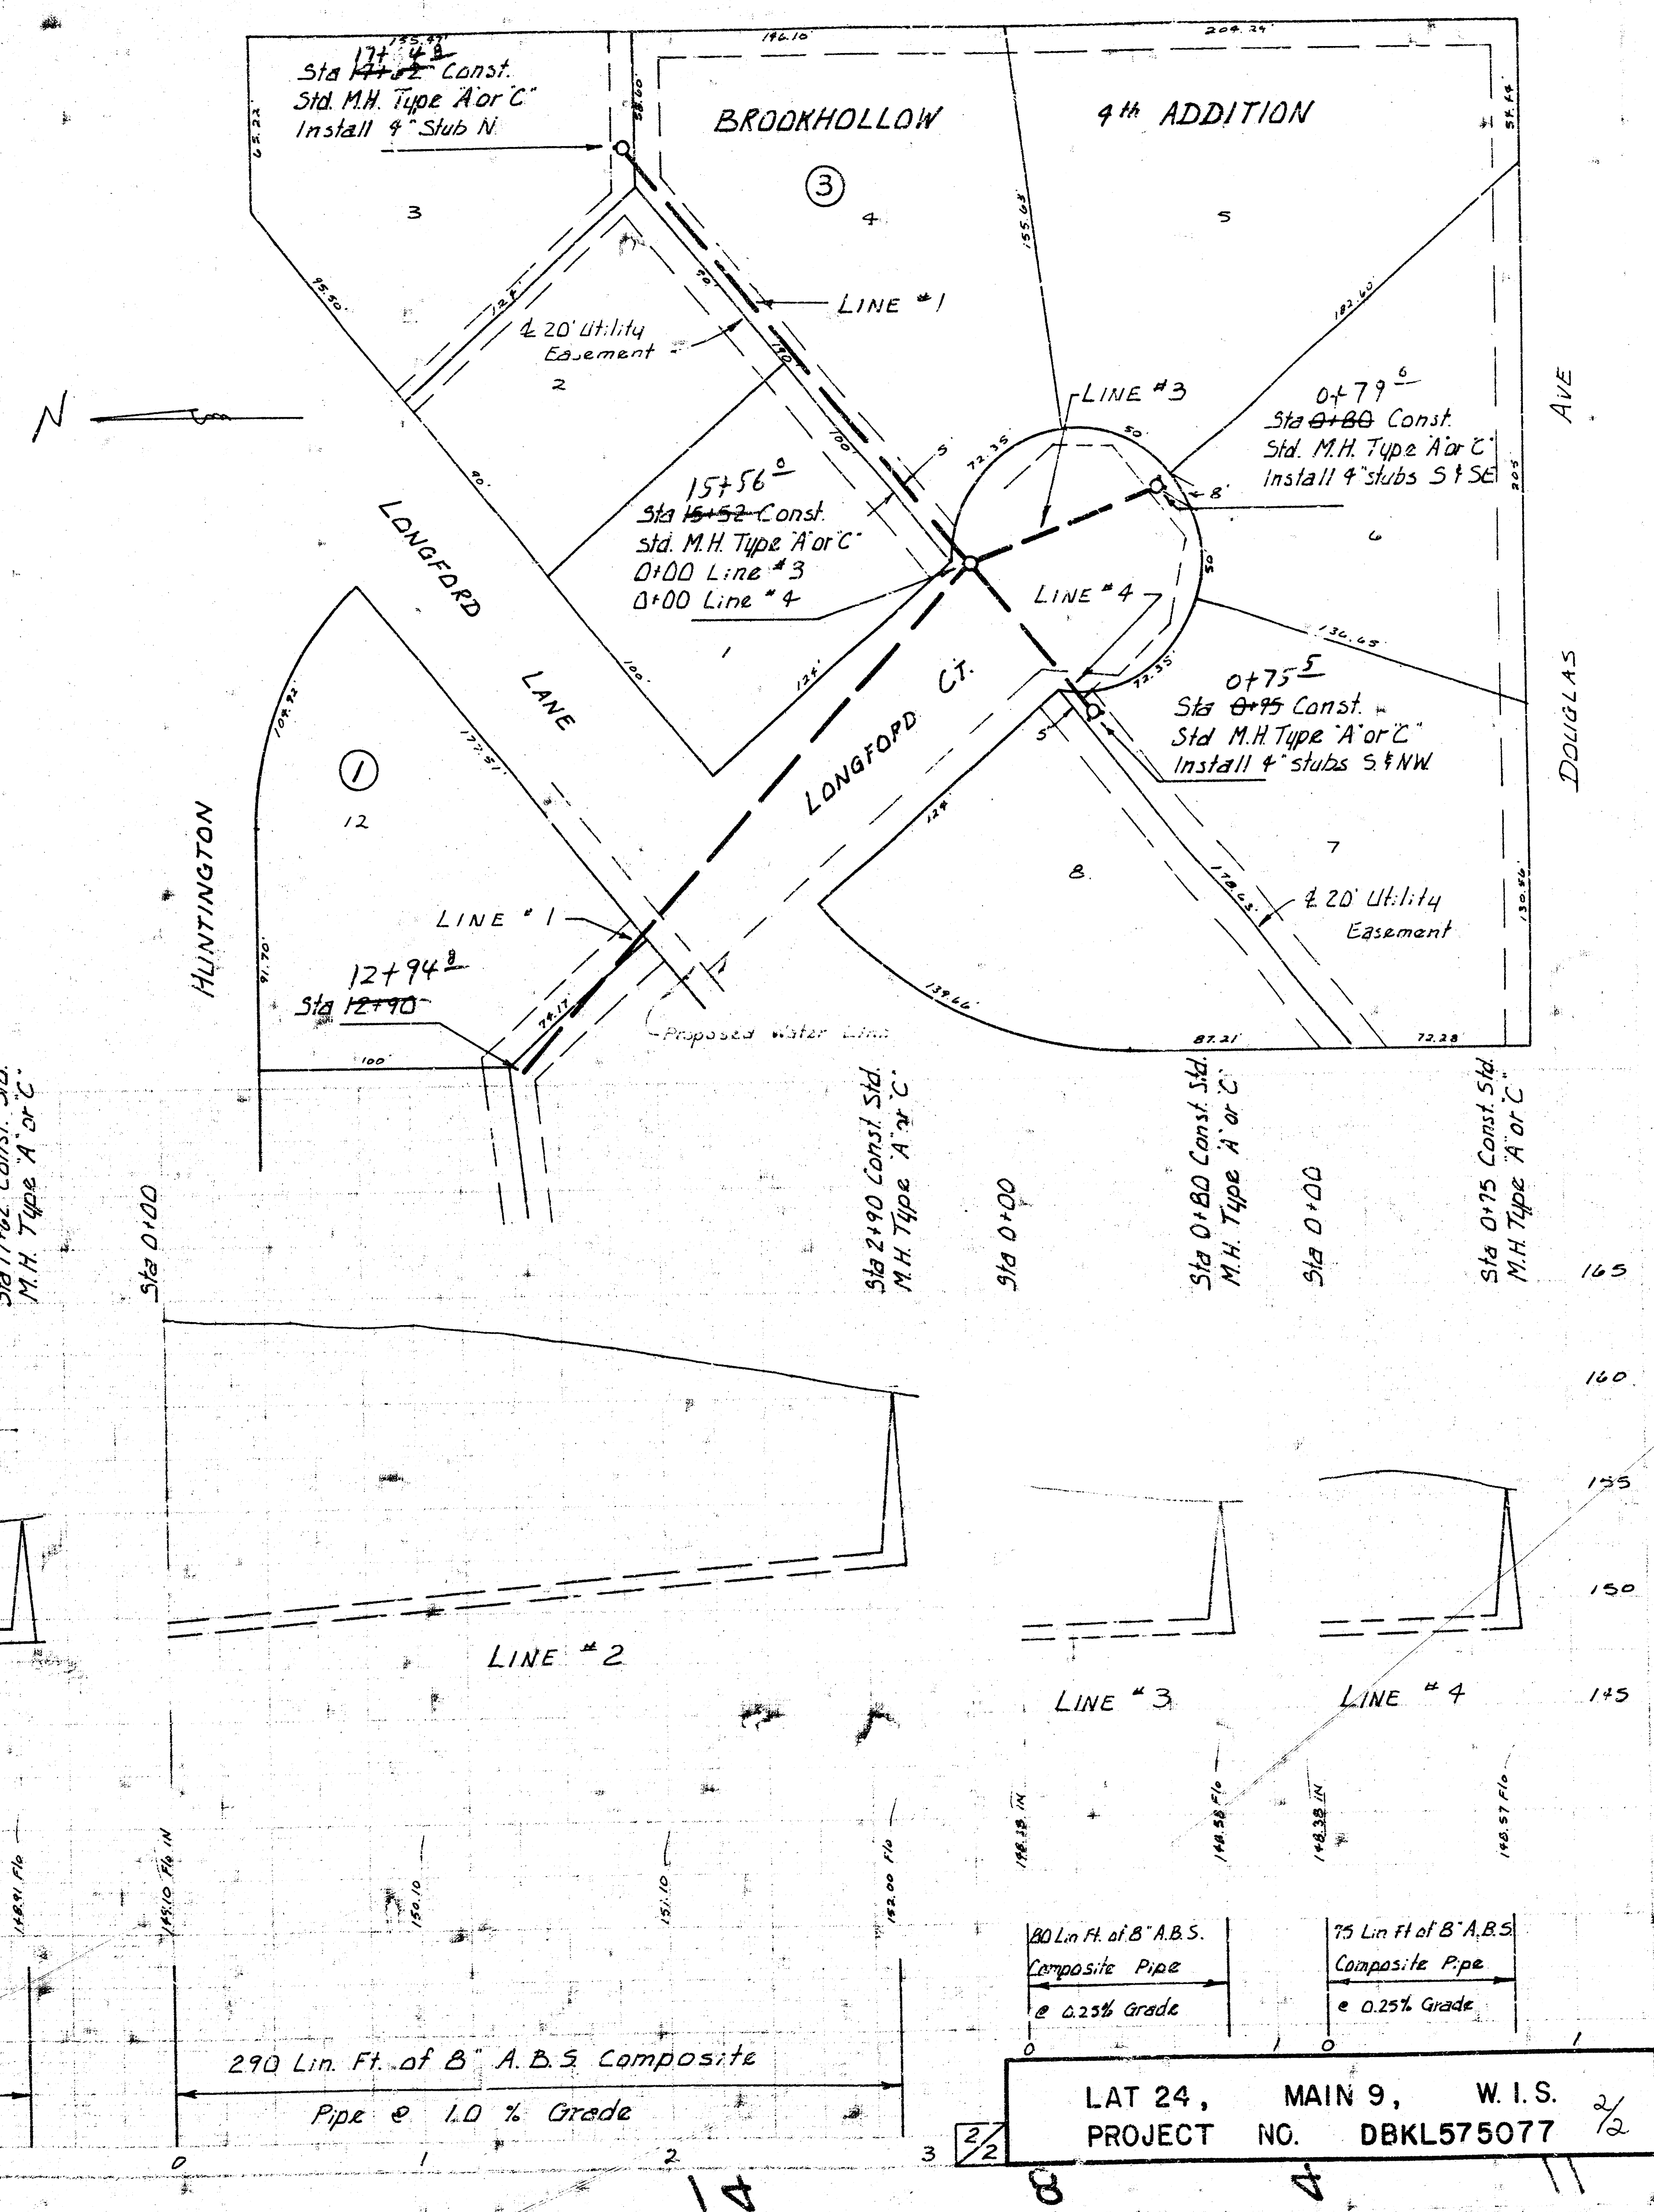


R.D. 117
R. Loomis

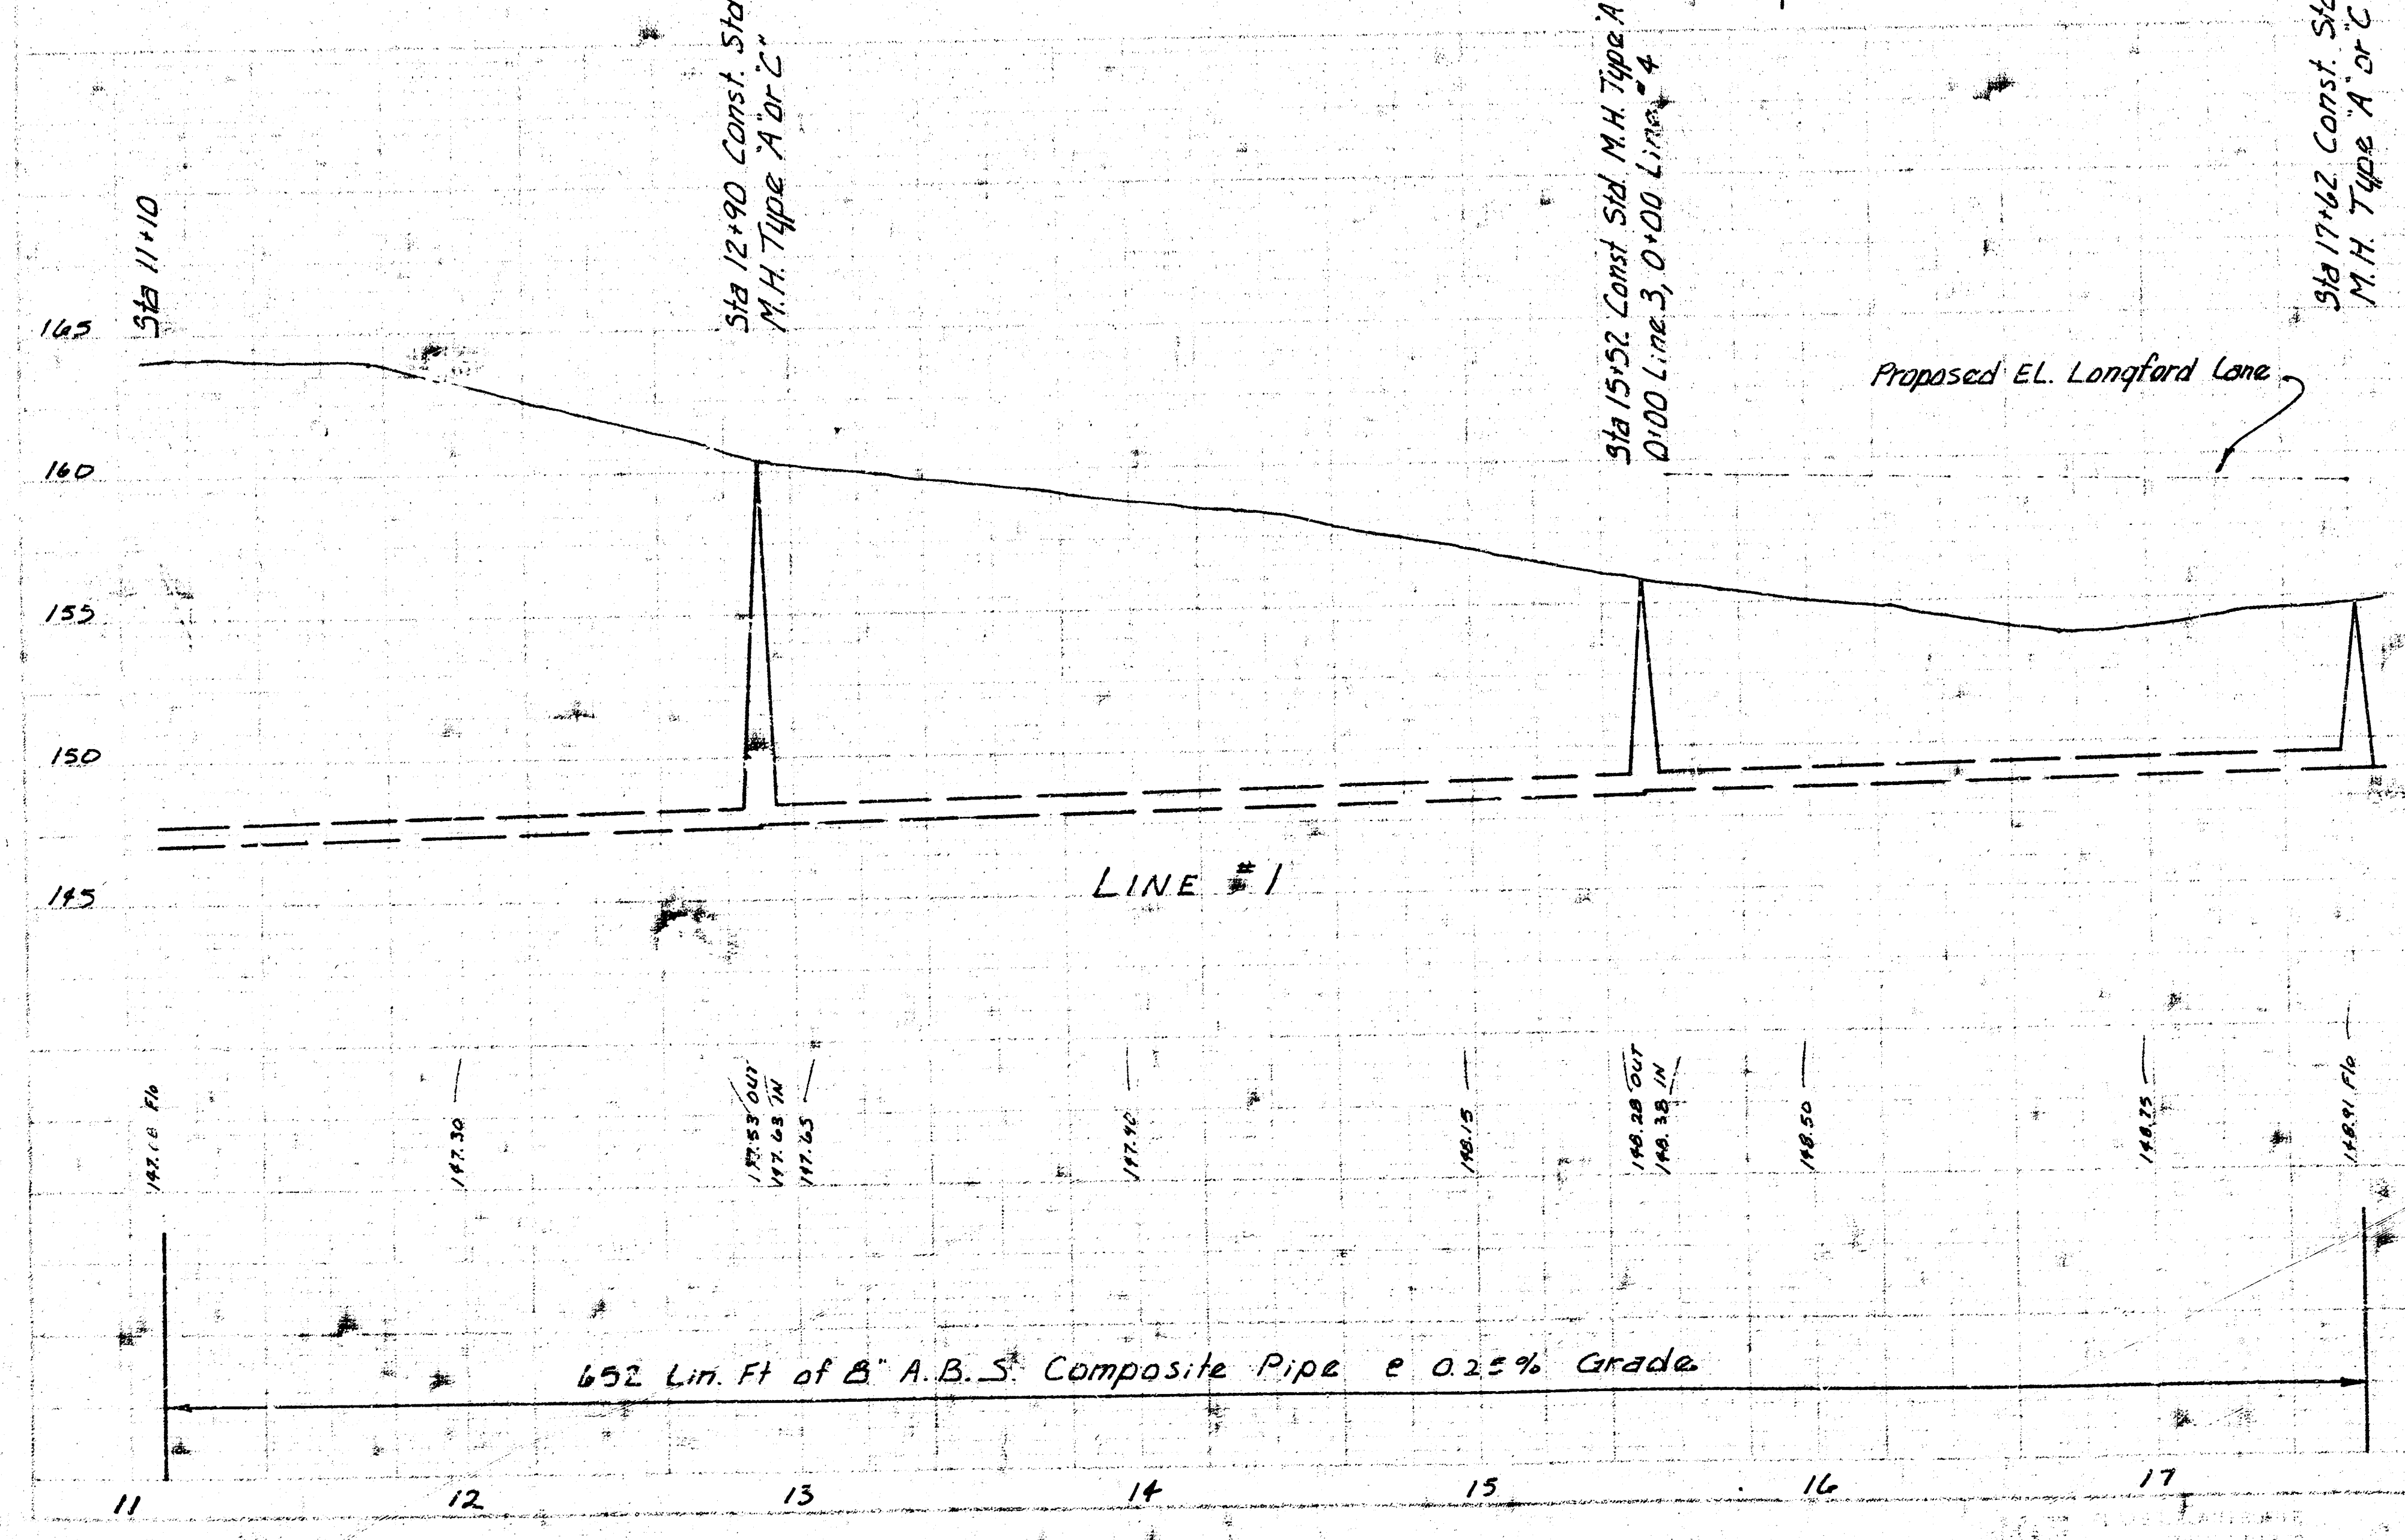

As Bup't 3-12-76
LAT. 24, MAIN 9, WAR IND. SEW.
CITY OF WICHITA, KANSAS
R. W. LINN — CITY ENGINEER
Dec, 1975 PROJECT NO. DBKL575077

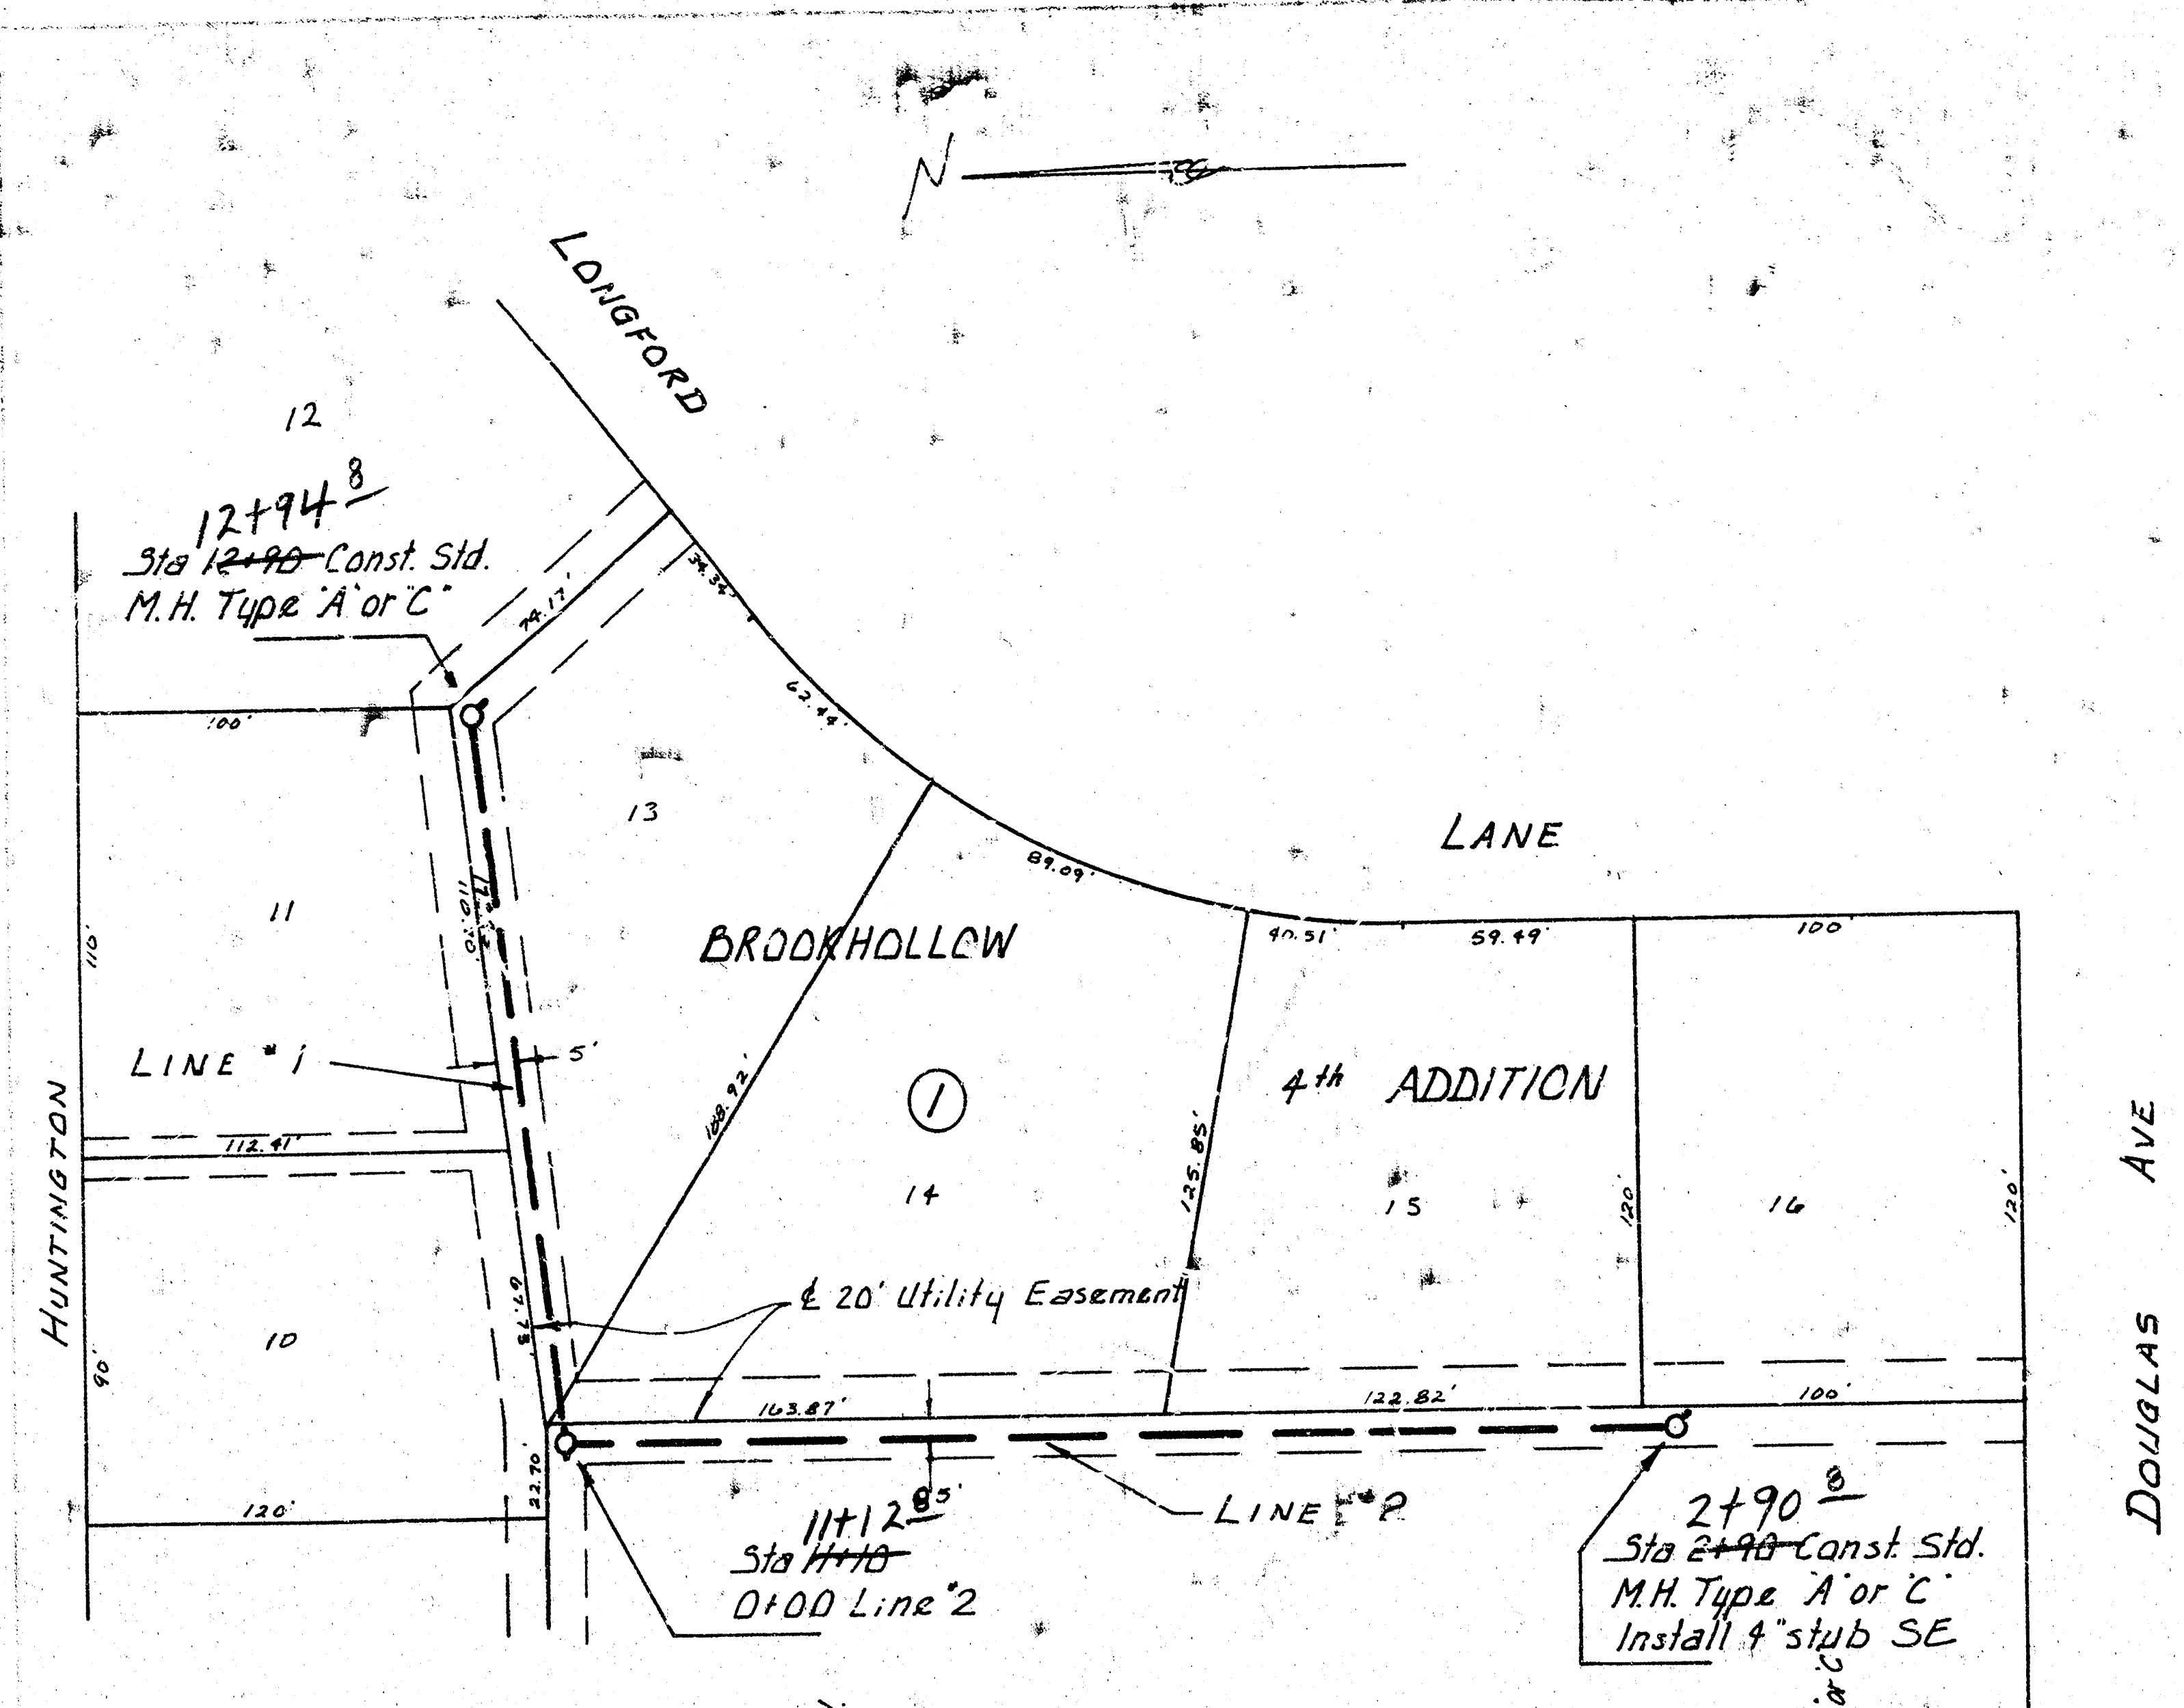

80 Lin. Ft. of 8" A.B.S. Composite Pipe @ 0.25% Grade	75 Lin. Ft. of 8" A.B.S. Composite Pipe @ 0.25% Grade
LAT 24, MAIN 9, W.I.S. PROJECT NO. DBKL575077	