
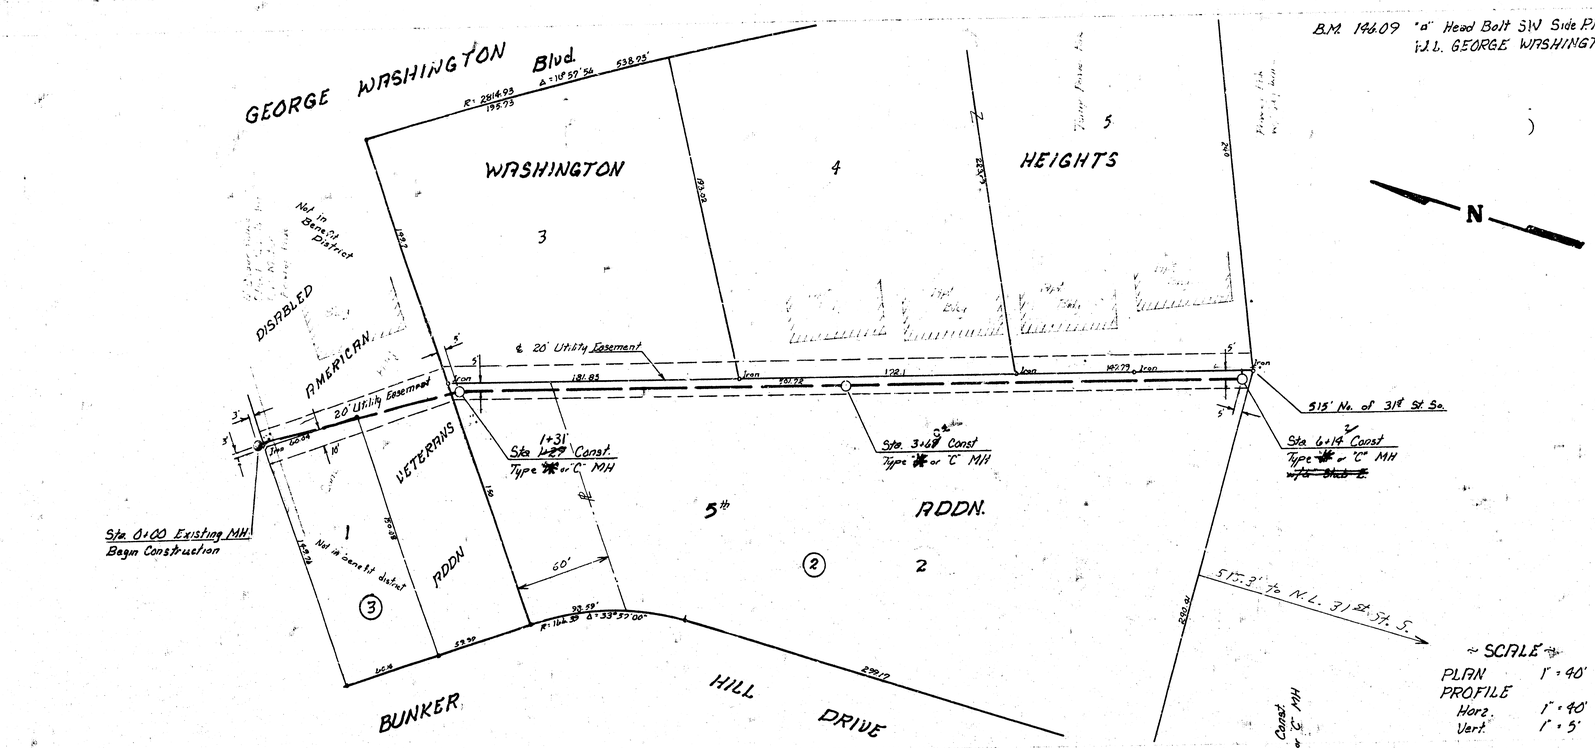


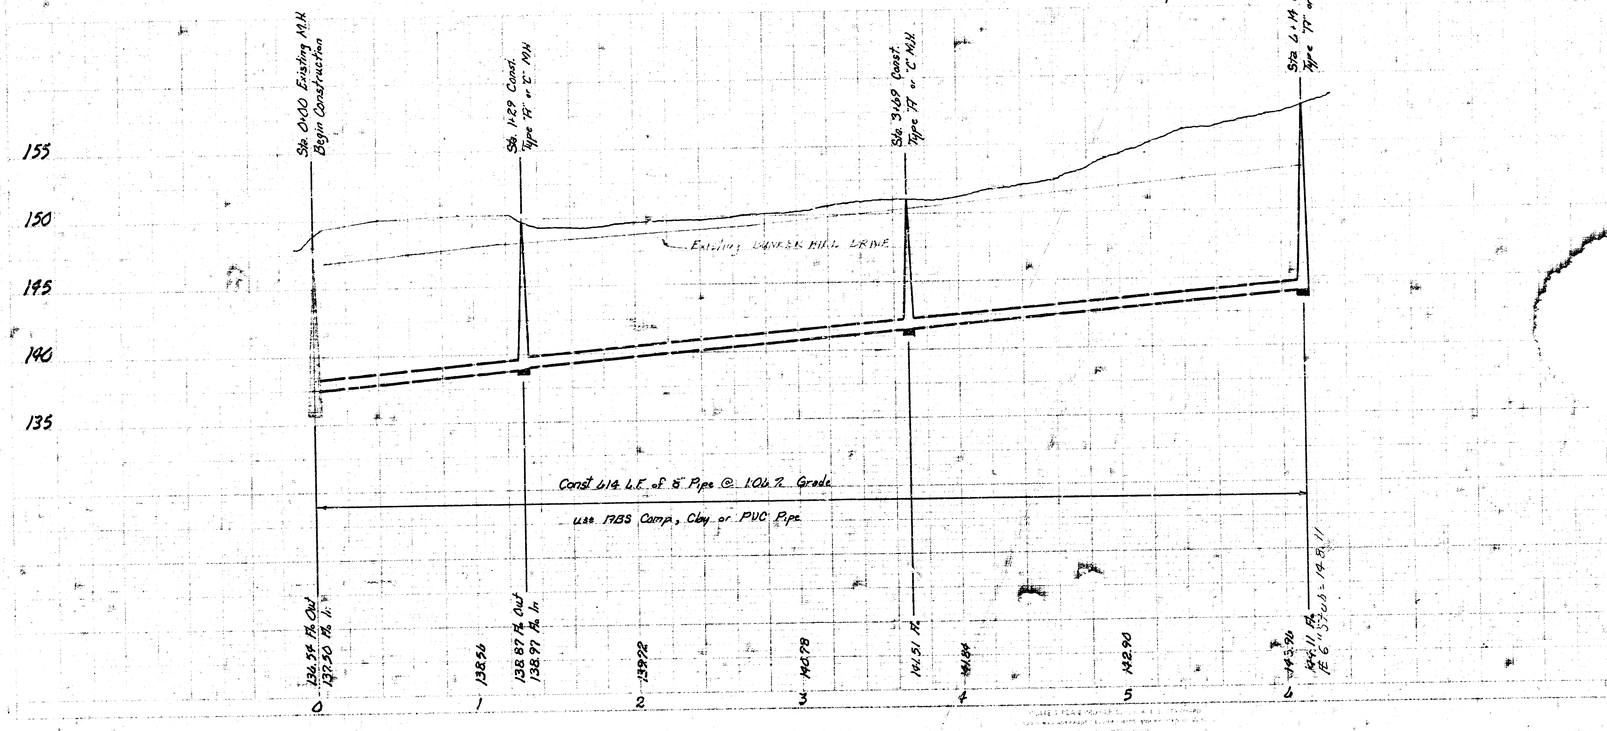

NOTE: WORK ORDER ON THIS PROJECT WILL BE ISSUED AS SOON AS POSSIBLE AFTER AWARD OF CONTRACT SINCE DEVELOPER HAS BUILDINGS COMPLETED AND NEEDS THE PROPOSED SEWER FOR THESE BUILDINGS. CONTRACTOR IS ANTICIPATE BEGINNING WORK IMMEDIATELY AFTER CONTRACT HAS BEEN EXECUTED.

SCALE

PLAN	1" = 40'
PROFILE	
Horz.	1" = 40'
Vert.	1" = 5'

As Built g.d. 10/29/80 E 293

DONALD E. SCHNEIDER LICENSED 6311 KANSAS PROFESSIONAL ENGINEER

LATERAL 18, MAIN 10, WAR INDUSTRIES SEWER
Proj. No.: 468-76-245-80970-000-000-001
WICHITA, KANSAS

DEAN SELLERS ~ Acting CITY ENGINEER

DATE: _____

D.K.R.G. J.D. Hatfield 6-80 6-80

D.L.S. 304