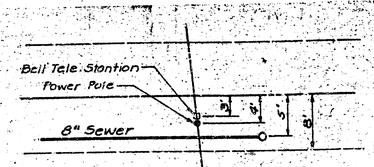

Detail 'A'

Eastmoor

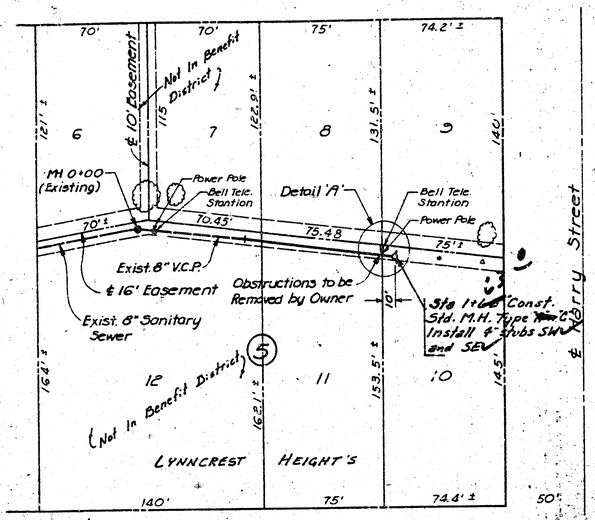

NOTE:
Owner to obtain permit from City of Wichita. Owner to contact K.G.&E. and S.W. Bell Tele. Co. relative to obstructions.

Paige

NOTE: FIELD ENGINEER MAY HAVE TO ADJUST LOCATION OF PROPOSED MANHOLE AT STATION 2+45.20 TO AVOID SPOOL IN EXISTING PIPE SOUTH OF MANHOLE AT STATION 2+32.

Scale
Plan: 1"=40'
Profile: Horiz. 1"=40'
Vert. 1"=4'

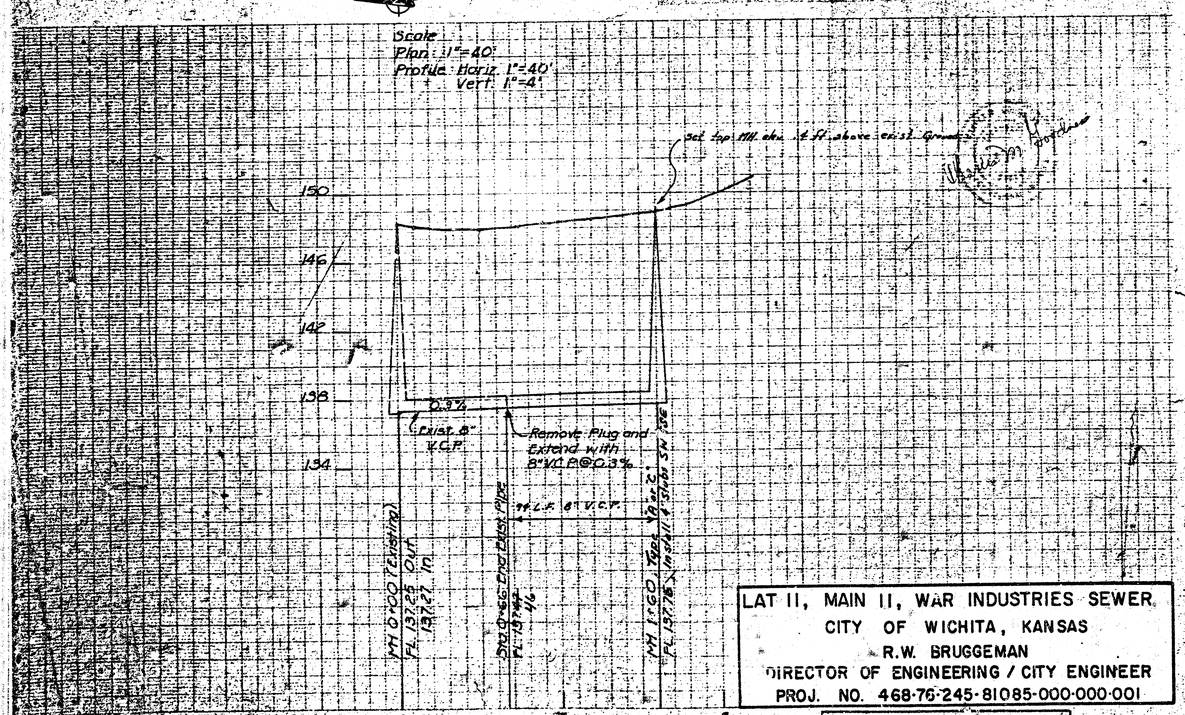

LAT 11, MAIN 11, WAR INDUSTRIES SEWER
CITY OF WICHITA, KANSAS
R.W. BRUGGEMAN
DIRECTOR OF ENGINEERING / CITY ENGINEER
PROJ. NO. 468-76-245-81085-000-000-001

REISS & GOODNESS ENGINEERS
2160 WEST 21ST STREET
WICHITA, KANSAS 67203
(316) 262-0251

As Built
SS
1/4/82

1/