

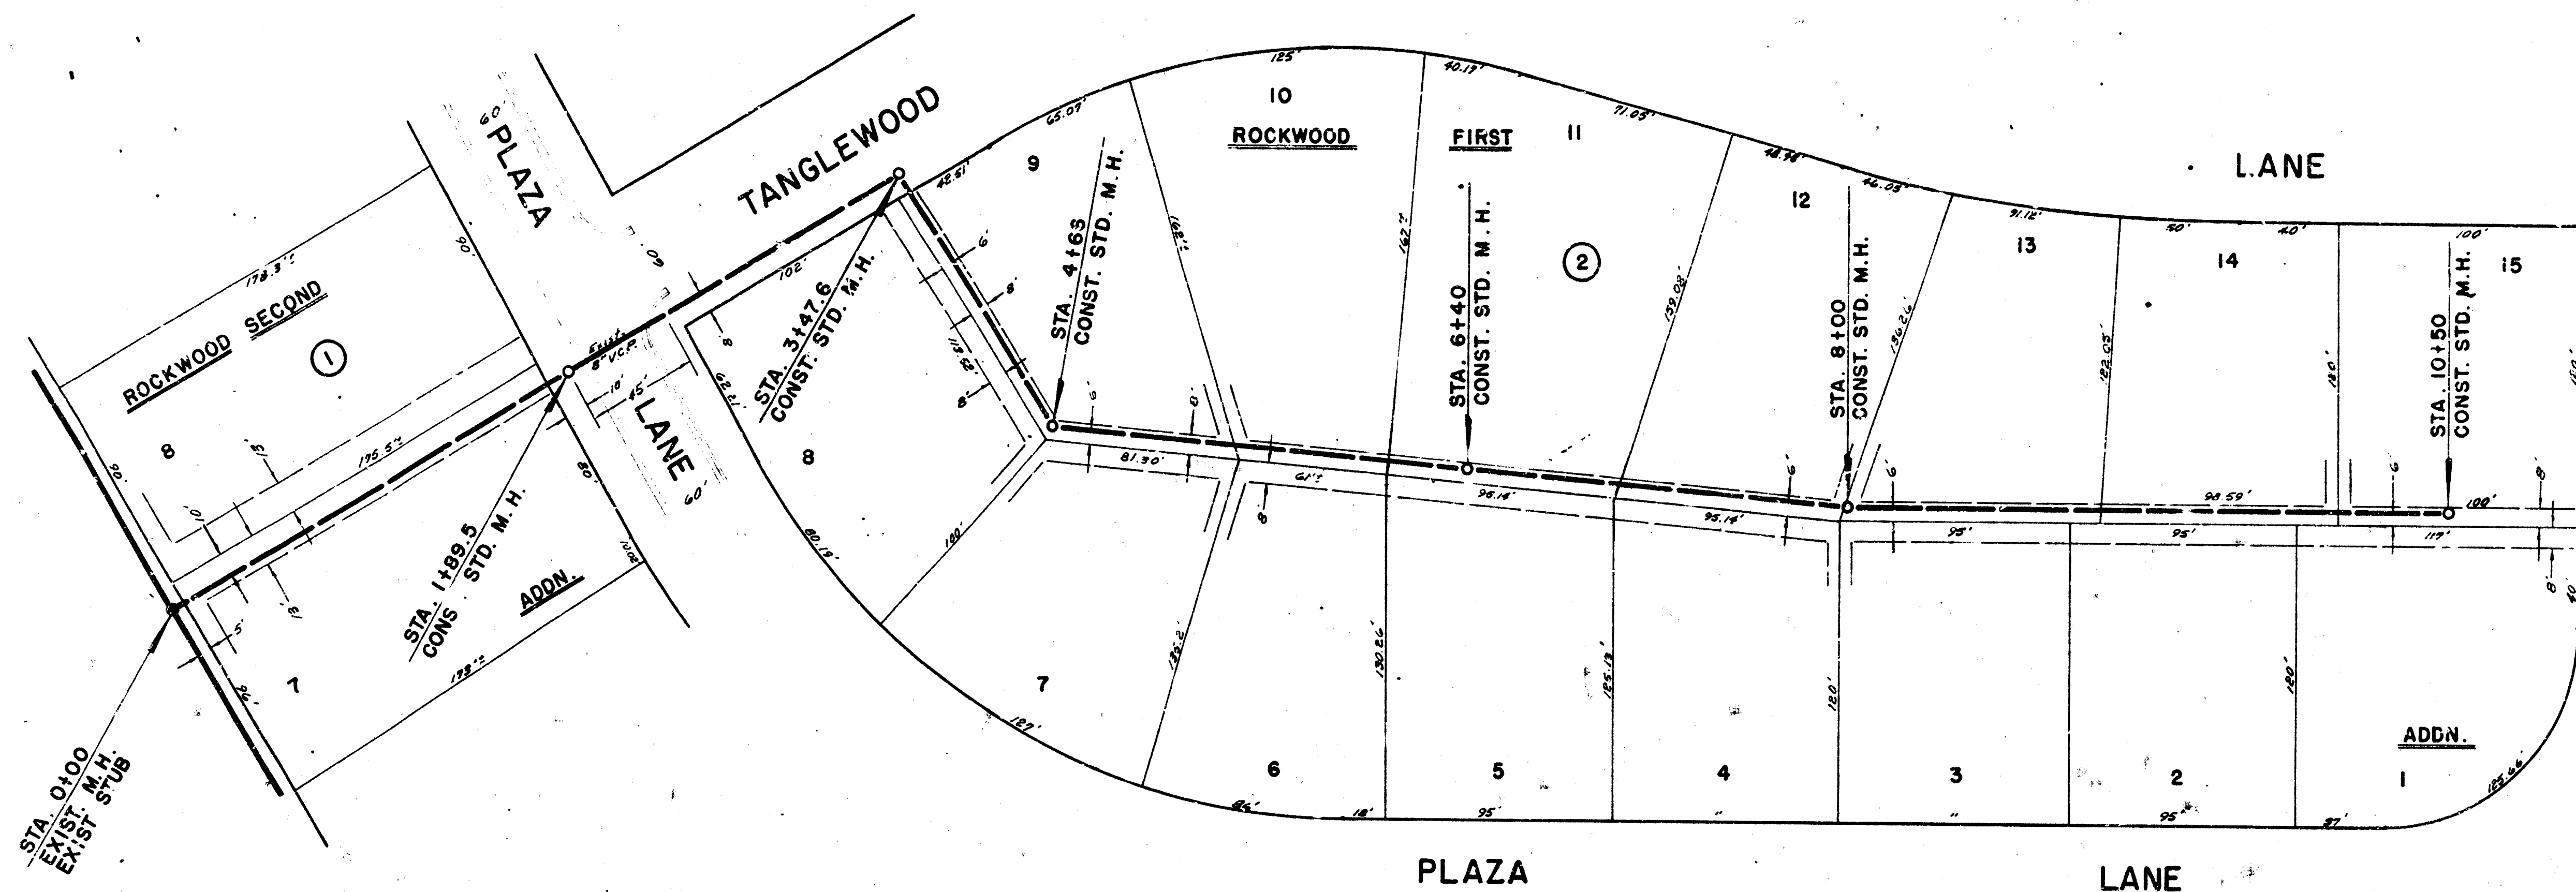
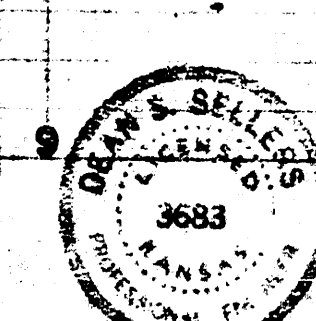


Survey By J. K. Knapen - 8/24/11-12
 Drawn By D. Cramer
 Checked By J. Knapen Date

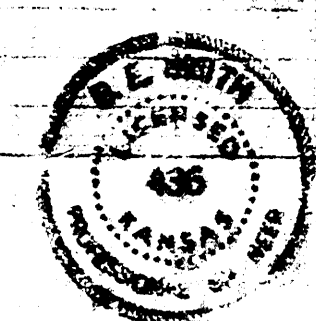

PLAN SCALE 1"=40'
 PROFILE SCALE 1"=40' HOR.
 1"=4' VERT.

B.M. 166.65 "R" IN RITCHIE W. END RAD. N. SIDE TANGLEWOOD W.L. PLAZA LANE
 B.M. 159.80 CITY B.M. DISC S.E. COR. R.C.B.C. CENTRAL

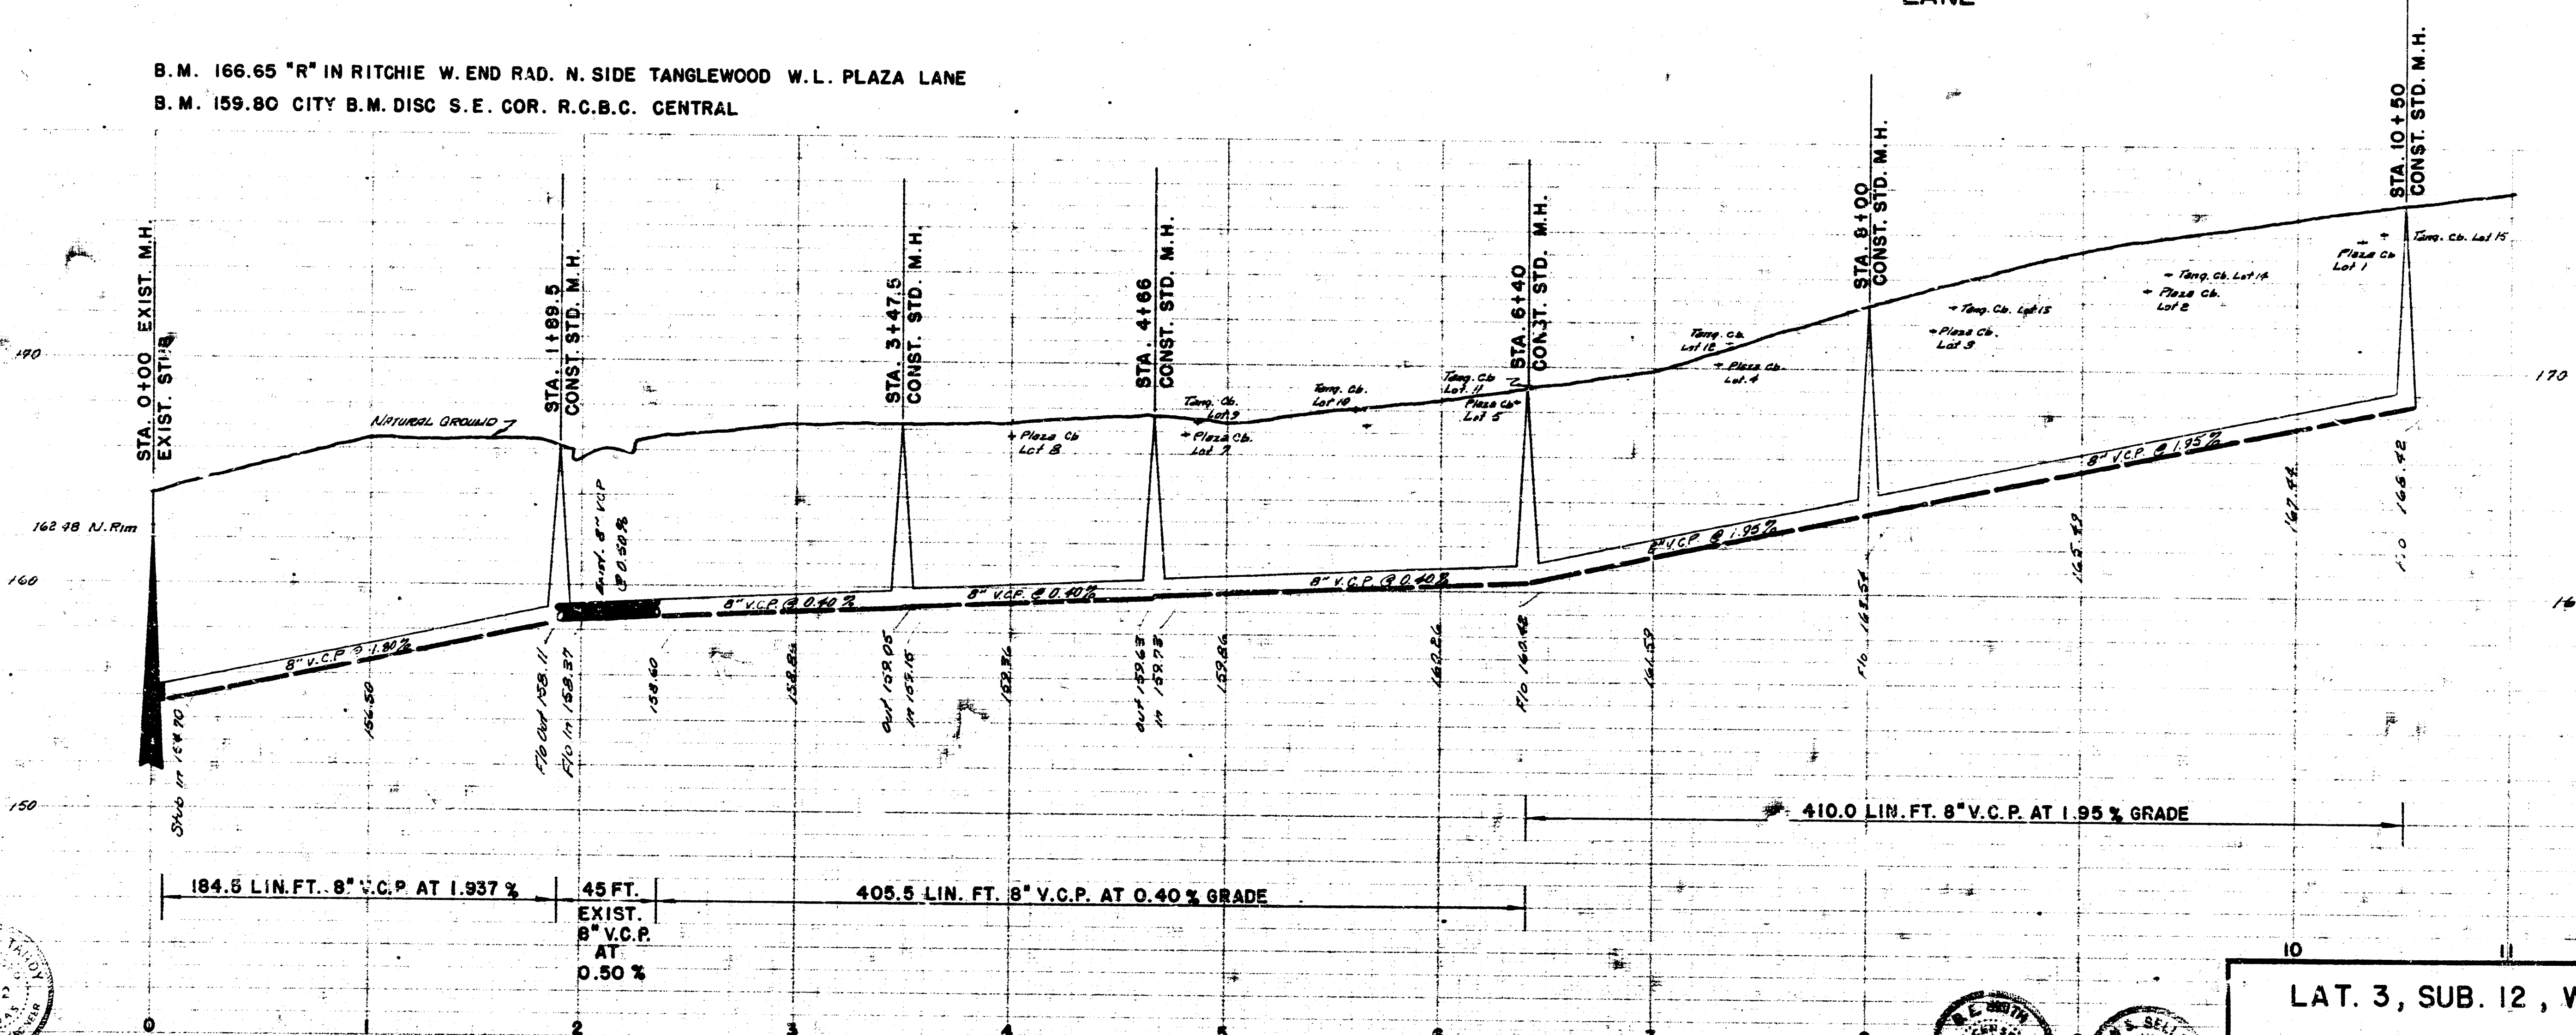

LAT. 3, SUB. 12, W.I.S.
 CITY OF WICHITA, KANSAS
 B. E. SMITH, CITY ENGINEER
 PROJ. NO. C23-22 DATE MAY 1953