
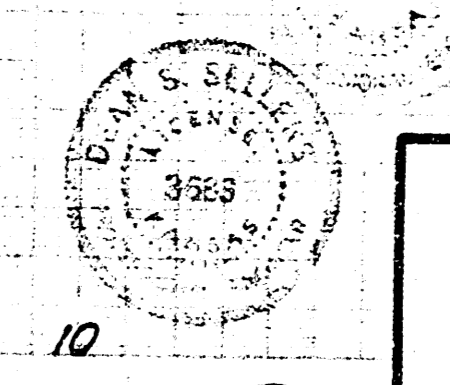


NOTE:
 10' easement desc. as fol:
 East of the NE cor. of lot 2 Blk. D;
 1/2' S.W. to a pt. on W.L. of lot 2
 & 30' N. of S.W. cor. of lot 2.

B.M. 192.32 "R" in Ritchie top S. cb. Abbotsford @ W.L. Lot 1 Blk. D. McEwen 9th Addn.

B.M. 189.4 "R" in Ritchie top N. cb. 14th St. @ W.L. Stratford

Plan Scale 1"=40'
 Profile Scale 1"=4' Hor.
 1"=4' Vert.

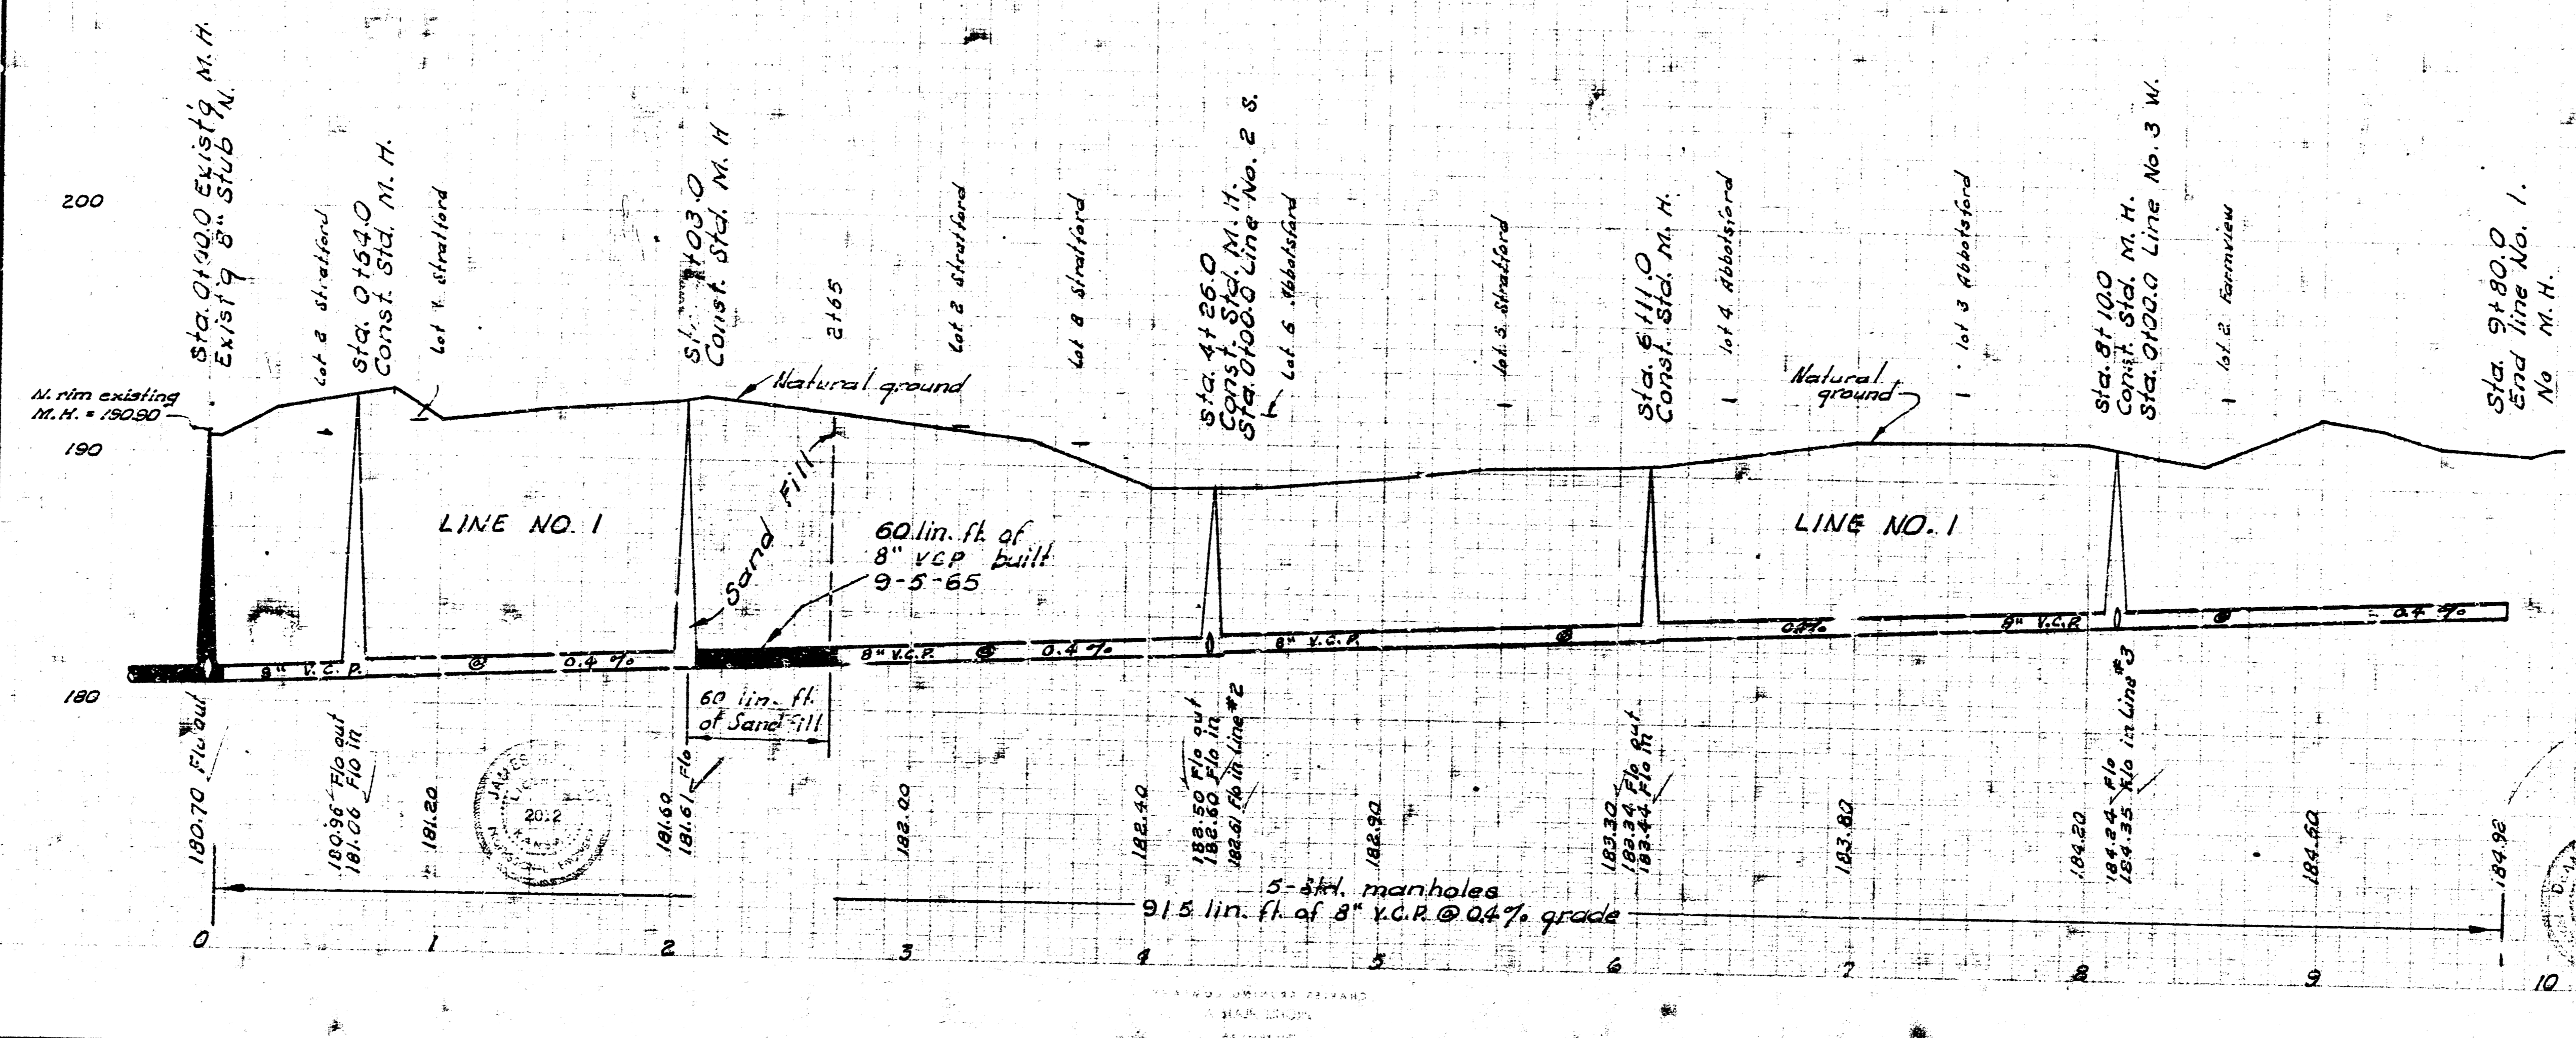

LAT. 9, SUB. 12, W. 1. S.
 CITY OF WICHITA, KANSAS
 B. E. SMITH, CITY ENGINEER
 PROJ. NO. C25-20 DATE: NOV. 1965

1/2

