Survey by C.L.G.
Plan by J.R.W
Bk. No. CLG 07


B. M. #1 171.63 "M" in Mueller on Fire Hydrant NE Cor. Intersection of Killarney Place and Lawrence Ln. (Est. by I. H.)

B. M. #2 169.75 "+" S. Rim M.H. 1220' east of E.L. Lawrence Ln & 82' South of N.L. Killarney Place.

Plan Scale 1"= 40'
Profile Scale 1"= 40' Horz.
1"= 4' Vert.

G. W. McCLELLAN 2ND. ADDITION

NOTE:
Benefit district includes all lots in block 1.

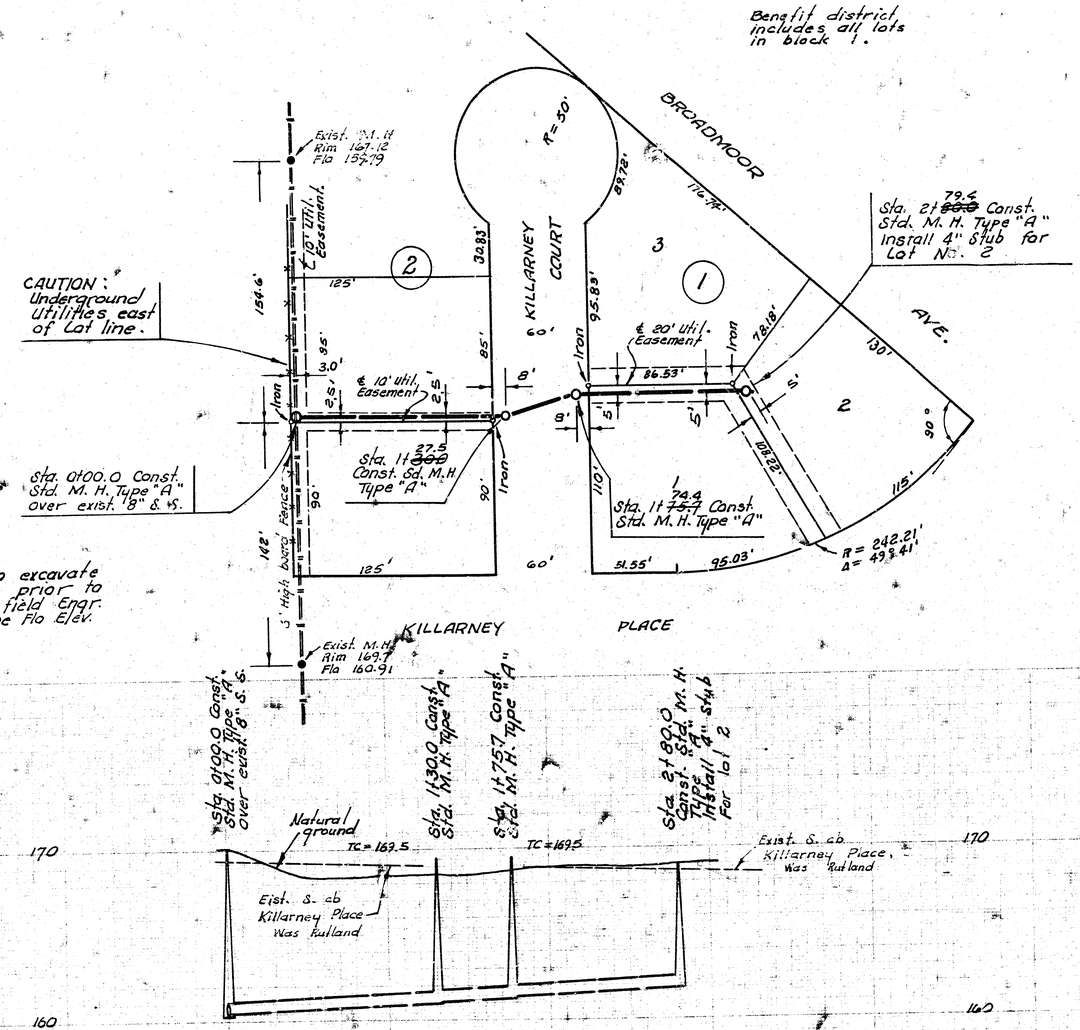

LARRY W. LAURSEN LICENSED 6363 KANSAS PROFESSIONAL ENGINEER

LAT. 20, MAIN 12, W. I. S.
CITY OF WICHITA, KANSAS
R. W. LINN — CITY ENGINEER
MAY 1974 PROJECT NO. DBKL574009

FINAL MEASUREMENTS FROM P-379

14 8 4 1/1