Survey by C.L.a.
Plan by J.R.W
Bk. No. CLG 07


B. M. #1 171.63 "N" in Mueller on Fire Hydrant NE Cor. Intersection of Killarney Place and Lawrence Ln. (Est. by I. H.)

B. M. #2 169.75 "+" S. Rim M.H. 122.0' east of E.L. Lawrence Ln & 8± South of N.L. Killarney Place.

G. W. McCLELLAN 2ND. ADDITION

Plan Scale 1" = 40'
Profile Scale 1" = 40' Horz.
1" = 4' Vert.

NOTE:
Benefit district includes all lots in block 1.

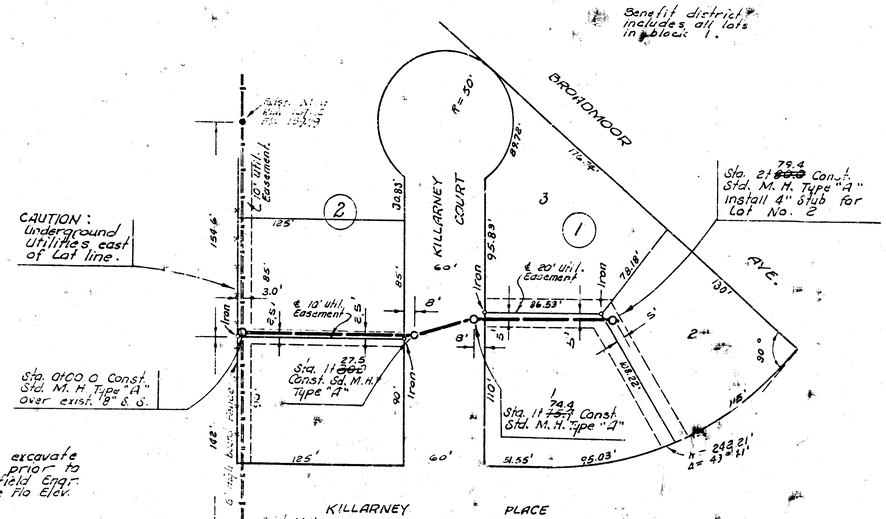

NOTE:
Contractor is to excavate at Sta. 0+00.0 prior to Construction So Field Engr. Can verify Pipe Flo Elev.

N

LAT. 20, MAIN 12, W. I. S.
CITY OF WICHITA, KANSAS
R. W. LINN — CITY ENGINEER
MAY 1974 PROJECT NO. DBK-L-574009

FINAL MEASUREMENTS FROM 1-274

LARRY W. LUSK
CONSULTANT
6353
KANSAS
PROFESSIONAL ENGINEER