
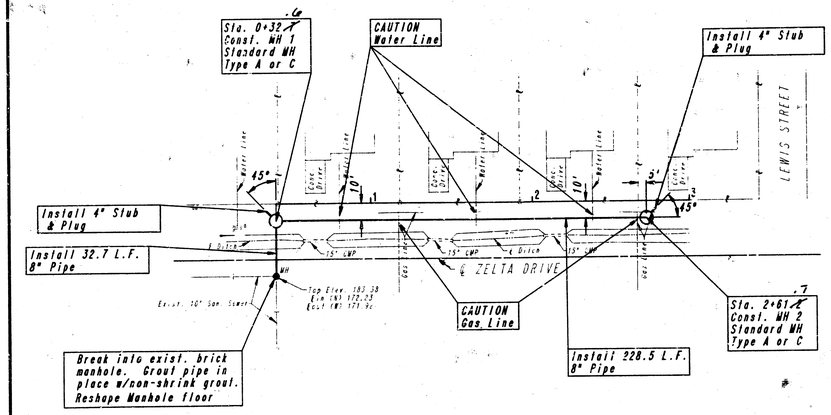


B.M. CITY OF WICHITA BENCH MARK DISC, 75' WEST AND 8' NORTH OF QUARTER SECTION CORNER @ ZELTA DRIVE & KELLOGG ELEV. 174.699 (CITY DATUM)

B.M. CITY OF WICHITA BENCH MARK DISC, 32' WEST AND 38' NORTH OF CENTERLINE OF ZELTA DRIVE & DOUGLAS. ELEV. 169.889 (CITY DATUM)

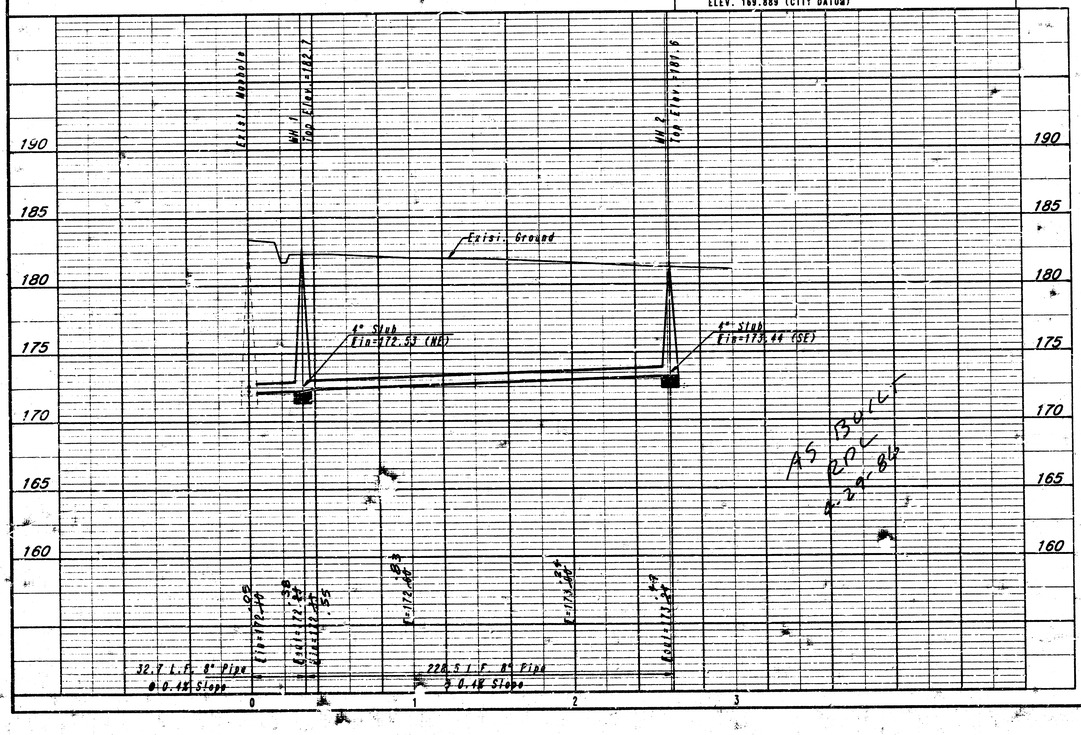


SCALE:

PLAN: LAT. & LONG. 40 0 40 80

PROFILE: HORIZ. SAME AS ABOVE

VERT.

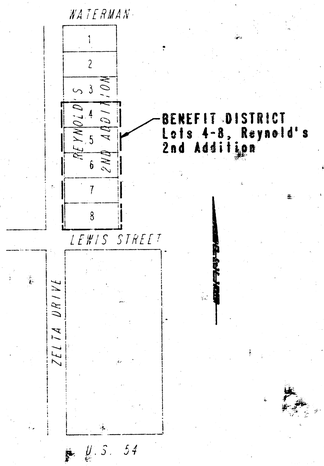

BENEFIT DISTRICT
Lots 4-8, Reynold's
2nd Addition

LOCATION MAP

CONSTRUCTION PLANS FOR

LATERAL 17, MAIN 13


OF THE

WAR INDUSTRIES SEWER

THE CITY OF WICHITA,

SEDGWICK COUNTY, KANSAS

MICHAEL E. LINDEBAK, P.E. CITY ENGINEER

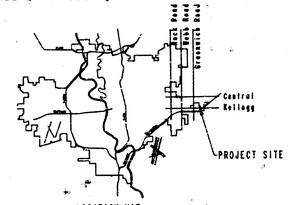

LOCATION MAP

CITY OF WICHITA PROJECT NO. 468-76-245-81496-000-000-001

DECEMBER, 1985

PLANS PREPARED BY

PROFESSIONAL ENGINEERING CONSULTANTS, P.A.

ENGINEERS

WICHITA, KANSAS

GENERAL NOTES

1. ALL CONSTRUCTION AND MATERIALS TO COMPLY WITH CITY OF WICHITA SPECIFICATIONS AND STANDARDS.
2. ALL ELEVATIONS SHOWN ARE CITY OF WICHITA DATUM (USGS-1187.4 = CITY DATUM).
3. THE CONTRACTOR SHALL LIMIT THE EXTENT OF TRENCH TO REMAIN OPEN OVERNIGHT AND WEEKENDS TO LESS THAN 50 FEET.
4. AT LEAST 48 HOURS PRIOR TO BEGINNING EXCAVATION, IF REQUIRED, (EXCLUDING WEEKENDS AND HOLIDAYS), THE CONTRACTOR SHALL CONTACT THE KANSAS ONE-CALL SYSTEM, A UTILITY LOCATION SERVICE, AT (316) 687-2470 TO REQUEST THE FOLLOWING UTILITY COMPANIES TO LOCATE ANY EXISTING LINES WITHIN THE PROJECT AREA: GAS SERVICE COMPANY, K.G.&E., THE WICHITA WATER DEPARTMENT, AND AIR CAPITAL CABLEVISION.
5. THE CONTRACTOR MUST ALSO NOTIFY THE TELEPHONE COMPANY AT (313) 571-2115 48 HOURS PRIOR TO BEGINNING EXCAVATION AND REQUEST THAT ANY LINES WITHIN THE PROJECT AREA BE FLAGGED.
6. THE BURIED UTILITIES AS LOCATED ON THE PLANS ARE APPROXIMATE LOCATIONS ONLY. IT SHOULD BE NOTED THAT OTHER BURIED LINES AND CABLES MAY EXIST WHICH ARE NOT SHOWN ON THESE PLANS. THE CONTRACTOR SHALL EXERCISE EXTREME CAUTION DURING TRENCHING OPERATIONS TO AVOID DAMAGING THESE LINES. ANY LINES DAMAGED SHALL BE REPLACED OR REPAIRED IMMEDIATELY AS DIRECTED BY THE ENGINEER AT THE CONTRACTOR'S EXPENSE.
7. THE CONTRACTOR SHALL RESTORE ALL DITCHES, SWALES, ROAD SHOULDERS, ENTRANCES, AND BANK LINES TO THEIR ORIGINAL SLOPES. **COST TO BE INCIDENTAL TO PROJECT.**
8. THE CONTRACTOR SHALL BE RESPONSIBLE FOR PRESERVING PROPERTY IRONS. THE CONTRACTOR SHALL BE REQUIRED TO RE-ESTABLISH ANY PROPERTY IRONS WHICH ARE DAMAGED OR DESTROYED BY HIS CONSTRUCTION OPERATIONS. SUCH IRONS SHALL BE RE-ESTABLISHED BY A LICENSED LAND SURVEYOR OR A LICENSED PROFESSIONAL ENGINEER IN ACCORDANCE WITH STATE LAWS. ALL COSTS FOR THIS WORK SHALL BE SUBSIDIARY TO THE OTHER ITEMS OF WORK.
9. CONTRACTOR SHALL PROVIDE POSITIVE DRAINAGE AWAY FROM ALL MANHOLE COVERS.

MICHAEL D. SCHUMACHER LICENSED 6778 KANSAS PROFESSIONAL ENGINEER

No.	Revision	By	Date

CITY OF WICHITA, KANSAS

LATERAL 17, MAIN 13

OF THE

WAR INDUSTRIES SEWER

MICHAEL E. LINDEBAK P.E. CITY ENGINEER

CITY OF WICHITA PROJECT NO. 468-76-245-81496-000-000-001

PROFESSIONAL ENGINEERING CONSULTANTS, P.A.

ENGINEERS

WICHITA, KANSAS

Designed by MDS	Job No. 34-85656	Sht. 1 of 1
Drawn by CAL	Date December, 1985	

FILMED FROM THE BEST AVAILABLE COPY