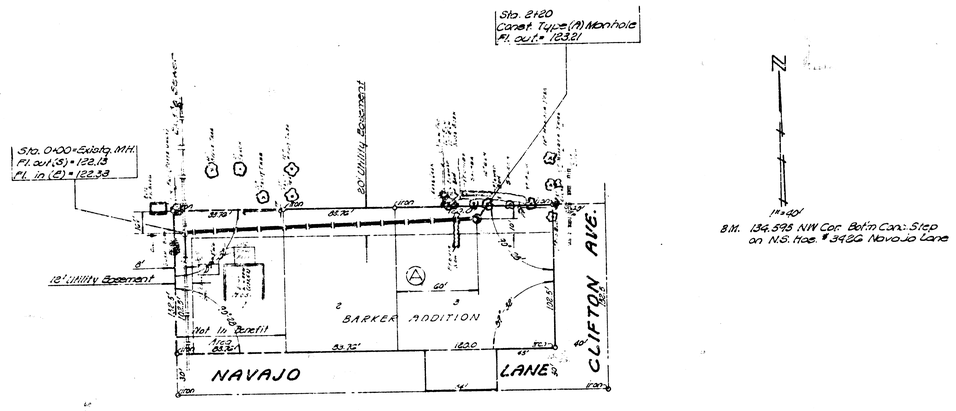

1" = 40'

B.M. 134.595 NW Cor. Bolt in Conc. Step on N.S. Hse. # 3486 Navajo Lane

Profile = 1" = 20' Horiz.
1" = 5' Vert.

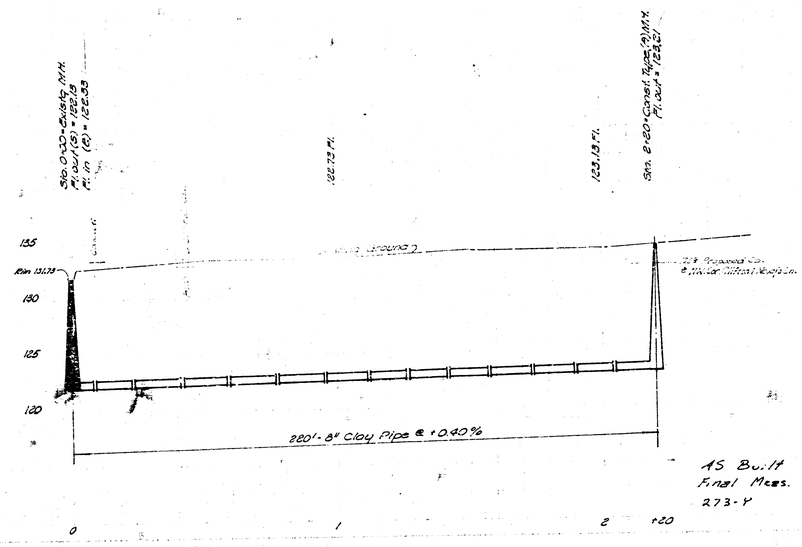

AS Built
Final Meas.
2-7-3-Y

LAT. 5, SUBMAIN 14, W.I.S.

City Of Wichita, Kansas
R.W. Linn City Engineer
Date - Jan. 1974 DBKL 570057